

9/23/63  
or 9/24/64

# PERMIT

SEWAGE DISPOSAL SYSTEM

MARYLAND STATE DEPARTMENT OF HEALTH

HOWARD COUNTY

ELLCOTT CITY

DISTRICT 5

DATE 4-3-63

## INDEXED

06525

06427

W. Robert Ricketts, Inc.

IS PERMITTED TO INSTALL  ALTER

ADDRESS \_\_\_\_\_ PHONE \_\_\_\_\_

A SEWAGE DISPOSAL SYSTEM LOCATED AT \_\_\_\_\_

SUBDIVISION Moosefield Cherry Knolls Dr. LOT 18, blk C

PROPERTY OWNER Robert Weid

ADDRESS JOE + COLLEEN GREEN

### SPECIFICATIONS

DRAIN FIELD \_\_\_\_\_ DEPTH \_\_\_\_\_ FEET, BOTTOM AREA \_\_\_\_\_ SQ. FT.

SEWAGE RATE 1 ASCRIBENT SIDE WALL AREA 12' x 11' deep below inlet

SEPTIC TANK CAPACITY 750 GALLONS

FOR GARBAGE GRINDER, INCREASE DISPOSAL AREA 25% & TANK CAPACITY 50%

OTHER Locate dry well 143 ft. from front property line and

30 ft. off the left side property line as determined on plan

from plot from Cherry Knolls Dr. Place inlet 3 1/2 ft. below original grade

PLANS APPROVED BY J. Allen DATE 3-29-63


FILL SEPTIC TANK AND DISTRIBUTION BOX WITH WATER BEFORE CALLING FOR AN INSPECTION. COVER NO WORK UNTIL INSPECTED AND APPROVED.

NEITHER THE HOWARD COUNTY COMMISSIONERS NOR THE HEALTH DEPARTMENT IS RESPONSIBLE FOR THE SUCCESSFUL OPERATION OF ANY SYSTEM.

OLD PERMIT BOOKS  
AND VOUCHERS  
Serial # B7010 4871  
Proposed

A49311-B

22526  
W.S.D.

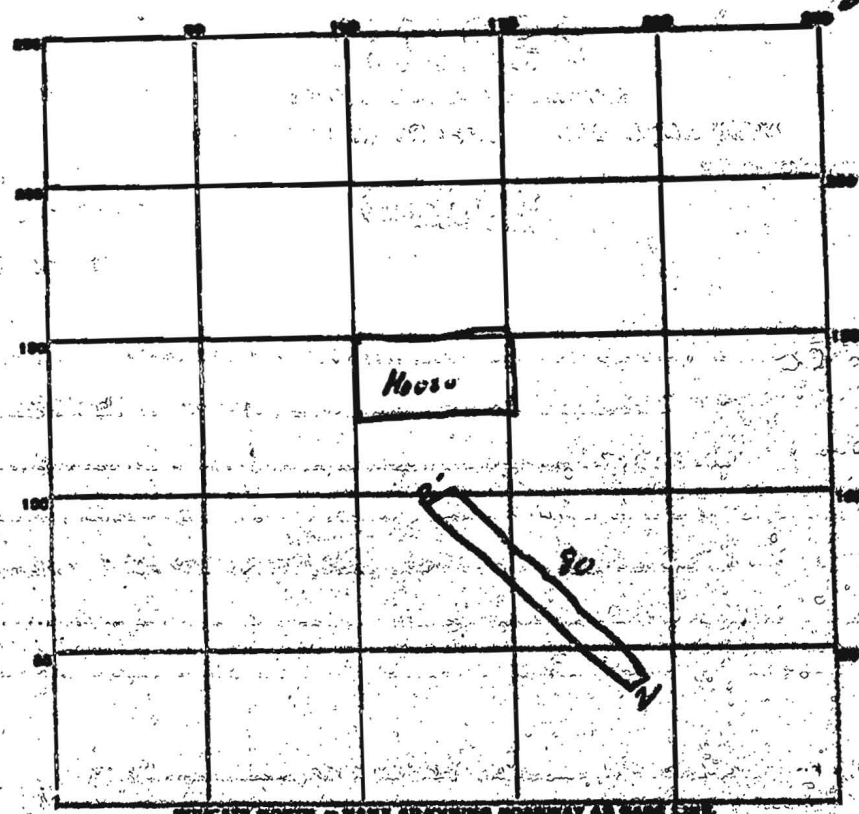

Cherry Tree Ave

PERMIT CARD OK

SEPTIC TANK LEVEL EXISTING CLEANOUTS N/A

DISTRIBUTION BOX LEVEL N/A

TILE FIELD, DEPTH 12 FT. TRENCH WIDTH 2 FT.

GRAVEL DEPTH 96 IN. TOTAL LENGTH 80 FT.

NUMBER OF TRENCHES 1 TOTAL BOTTOM AREA 60 SQ. FT.

SEEPAGE PITS, INSIDE DIAMETER N/A FT. DEPTH BELOW INLET N/A FT.

ABSORBENT AREA 640 SQ. FT.

REMARKS 11-20-75 OK TO COVER IN

DATE SYSTEM APPROVED 11-20-75 DIRECTOR [Signature]