

PERMIT

SEWAGE DISPOSAL SYSTEM

MARYLAND STATE DEPARTMENT OF HEALTH

HOWARD COUNTY

ELLICOTT CITY

DISTRICT 1

INDEXED

DATE 3/4/72

Jack Frank IS PERMITTED TO INSTALL ALTER 2

ADDRESS Ten Oaks Road, Glenold, Md. PHONE 294-2979

SEWAGE DISPOSAL SYSTEM LOCATED AT _____

SECTION Moorefield ROAD 7530 Cherry Tree Dr. LOT _____

OPERATOR OWNER Cristan Hought 735-6759

ADDRESS _____

REQUIREMENTS _____

DRAIN FIELD _____ DEPTH _____ FEET. BOTTOM AREA _____ SQ. FT.

SEEPAGE PITS _____ ABSORBENT SIDE-WALL AREA _____ SQ. FT.

SEPTIC TANK CAPACITY _____ GALLONS

FOR GARBAGE GRINDER, INCREASE DISPOSAL AREA 22% & TANK CAPACITY 50%.

OTHER REPAIR - Call for inspection when ground is opened up and Sanitarian will
recommend repair system.


PLANS APPROVED BY Palmer F. Wise DATE 3/4/72

FILL SEPTIC TANK AND DISTRIBUTION BOX WITH WATER BEFORE CALLING FOR AN INSPECTION. COVER NO WORK UNTIL INSPECTED AND APPROVED.

NEITHER THE HOWARD COUNTY COMMISSIONERS NOR THE HEALTH DEPARTMENT IS RESPONSIBLE FOR THE SUCCESSFUL OPERATION OF ANY SYSTEM.

GREEN Hill road

16816

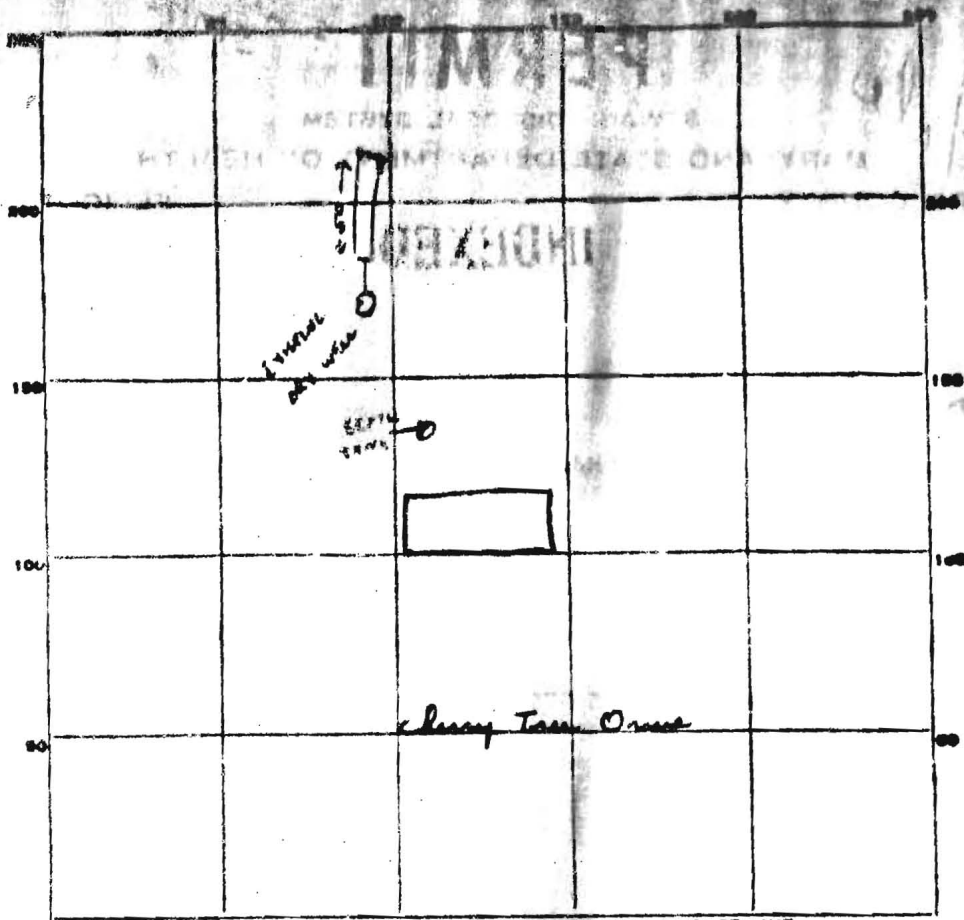

PERMIT CARD _____

SEPTIC TANK, LEVEL _____ CLEANOUTS _____

DISTRIBUTION BOX, LEVEL _____

TILE FIELD, DEPTH 9 1/2 = 10 1/2 FT. TRENCH WIDTH 1 1/2 FT.

GRAVEL DEPTH 6 IN. TOTAL LENGTH 50 FT.

NUMBER OF TRENCHES: 1 External TOTAL BOTTOM AREA 600 sq. ft. (not all absorbent area) Efficient area 300 sq. ft.

SEEPAGE PITS, INSIDE DIAMETER _____ FT. DEPTH BELOW INLET _____ FT.

ABSORBENT AREA _____ SQ. FT.

REMARKS 5/19/72 - Tank under ground for two hours but not started in at all below on 6 1/2 ft. of clay.

DATE SYSTEM APPROVED 5/19/72

INSPECTOR P. Tame