

# APPLICATION

A \_\_\_\_\_

P \_\_\_\_\_

## SEWAGE DISPOSAL TESTING

STATE OF MARYLAND - DEPARTMENT OF HEALTH AND MENTAL HYGIENE

HOWARD COUNTY HEALTH DEPARTMENT  
ENVIRONMENTAL HEALTH SERVICES  
P. O. BOX 476, ELLICOTT CITY, MARYLAND 21043  
TELEPHONE: 465-5000, EXT. 356

DISTRICT Fifth

DATE 9/9/76

TO: THE COUNTY HEALTH OFFICER  
ELLICOTT CITY, MARYLAND

I, HEREBY, APPLY FOR THE NECESSARY TEST IN ORDER TO CONSTRUCT (OR RECONSTRUCT) A SEWAGE DISPOSAL SYSTEM.

PROPERTY OWNER Mr. and Mrs. Smith W. Allnutt, Jr.

ADDRESS 13288 Highland Road  
Highland, MD 20777 PHONE 088-9303

PROPERTY LOCATION:

SUBDIVISION H1 - Land Farm Estates LOT NO. 110

ROAD AND DESCRIPTION Road "D"

SIZE OF LOT 1.05 Ac TYPE BLDG. 3 or 4 bedroom  
NUMBER OF BEDROOMS

IF NOT SINGLE RESIDENCE DESCRIBE \_\_\_\_\_

THE SYSTEM INSTALLED UNDER THIS APPLICATION IS ACCEPTABLE ONLY UNTIL PUBLIC FACILITIES BECOME AVAILABLE.

SIGNATURE OF APPLICANT /s/ Margaret G. Allnutt


APPROVED BY \_\_\_\_\_ FOR \_\_\_\_\_ DATE \_\_\_\_\_  
(KIND OF SYSTEM)

REJECTED BY \_\_\_\_\_ FOR \_\_\_\_\_ DATE \_\_\_\_\_  
(KIND OF SYSTEM)

HOLD PENDING FURTHER TESTS \_\_\_\_\_ DATE \_\_\_\_\_

REASONS FOR REJECTION OR HOLDING \_\_\_\_\_

# THIS IS NOT A PERMIT

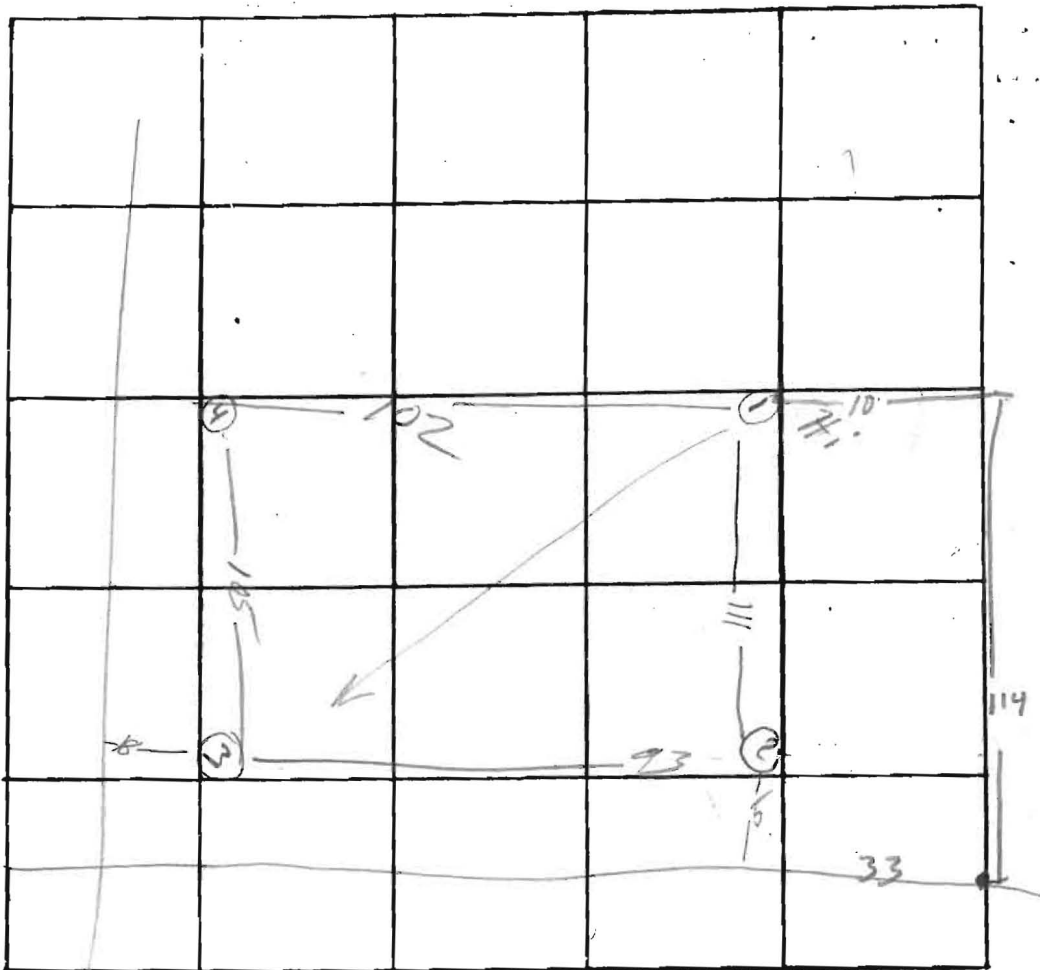

INDICATE NORTH. - NAME ADJOINING ROADWAY AS BASE LINE.

ROAD D

DATE	TEST NO.	DEPTH	PRE-WET		TEST - 1" DROP		TIME
			START	STOP	START	STOP	
Oct 76	1 s	2.5	1457	1459	1459	1502	3
"	d	13	1457	1458	1458	1500	2
"	2 s	15	<del>Visual</del>				
"	d						
"	3 s	3	1509	1520	1520	1531	11
"	d	12	1508	1509	1509	1511	2
"	4 s	3	1503	1508	1508	1526	16
"	d	12	1503	1504	1504	1506	2

REMARKS

Generally sandy soils

TYPE OF SOIL

TESTED BY

R Biggs O Niell


ALSO PRESENT:

Kellerman

①  
Clay 2  
Sandy 2  
④  
Clay 2  
Sandy 2  
⑦  
Clay 0  
Sandy 4  
12

②  
Clay  
Sandy

38  
3

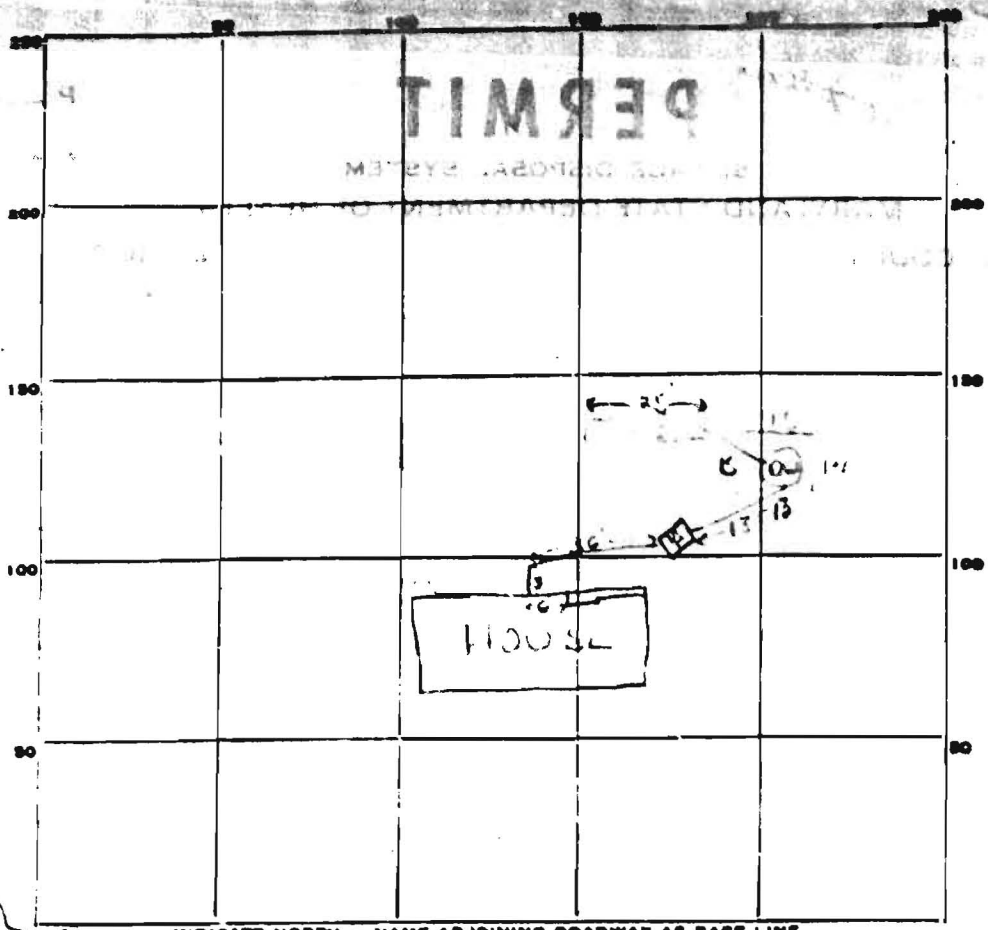

INDICATE NORTH NAME ADJOINING ROADWAY AS BASE LINE.

Riland Ct.

PERMIT CARD \_\_\_\_\_

ST | D.W.

SEPTIC TANK, LEVEL  \_\_\_\_\_

CLEANOUTS None  \_\_\_\_\_

DISTRIBUTION BOX, LEVEL n.a. \_\_\_\_\_

TILE FIELD, DEPTH 1 1/2 FT. TRENCH WIDTH 2 FT.

GRAVEL DEPTH 8-9 IN. TOTAL LENGTH 25 FT.

NUMBER OF TRENCHES 1 TOTAL BOTTOM AREA 150 <sup>1/2 SIDEWELL</sup>

SEE PAGE PITS, <sup>OUTSIDE PERIMETER</sup> INSIDE DIAMETER 56 FT. DEPTH BELOW INLET 8 FT.

Total ABSORBENT AREA ±598 SQ. FT.

REMARKS 12/7/78 21 by at ground level F.S.

DATE SYSTEM APPROVED 5/26/78 INSPECTOR Frank Skinner