

APPROVED

WALK-THRU BUILDING PERMIT

BP# 600153119 A# 13462


APP. SAN KJB for Pay DATE: 4/13/05

DESC. OF WORK: Deck



B.R.L.=BUILDING RESTRIC LINE

13462 CHAROLAIS COURT ALLNUTT FARM ESTATES HIGHLAND, MD-20777		
PROPOSED DECK ADDITIONS SITE PLAN		
DATE: APRIL 6, 2005	SCALE: 1"=40'	DWG. NO. C-1

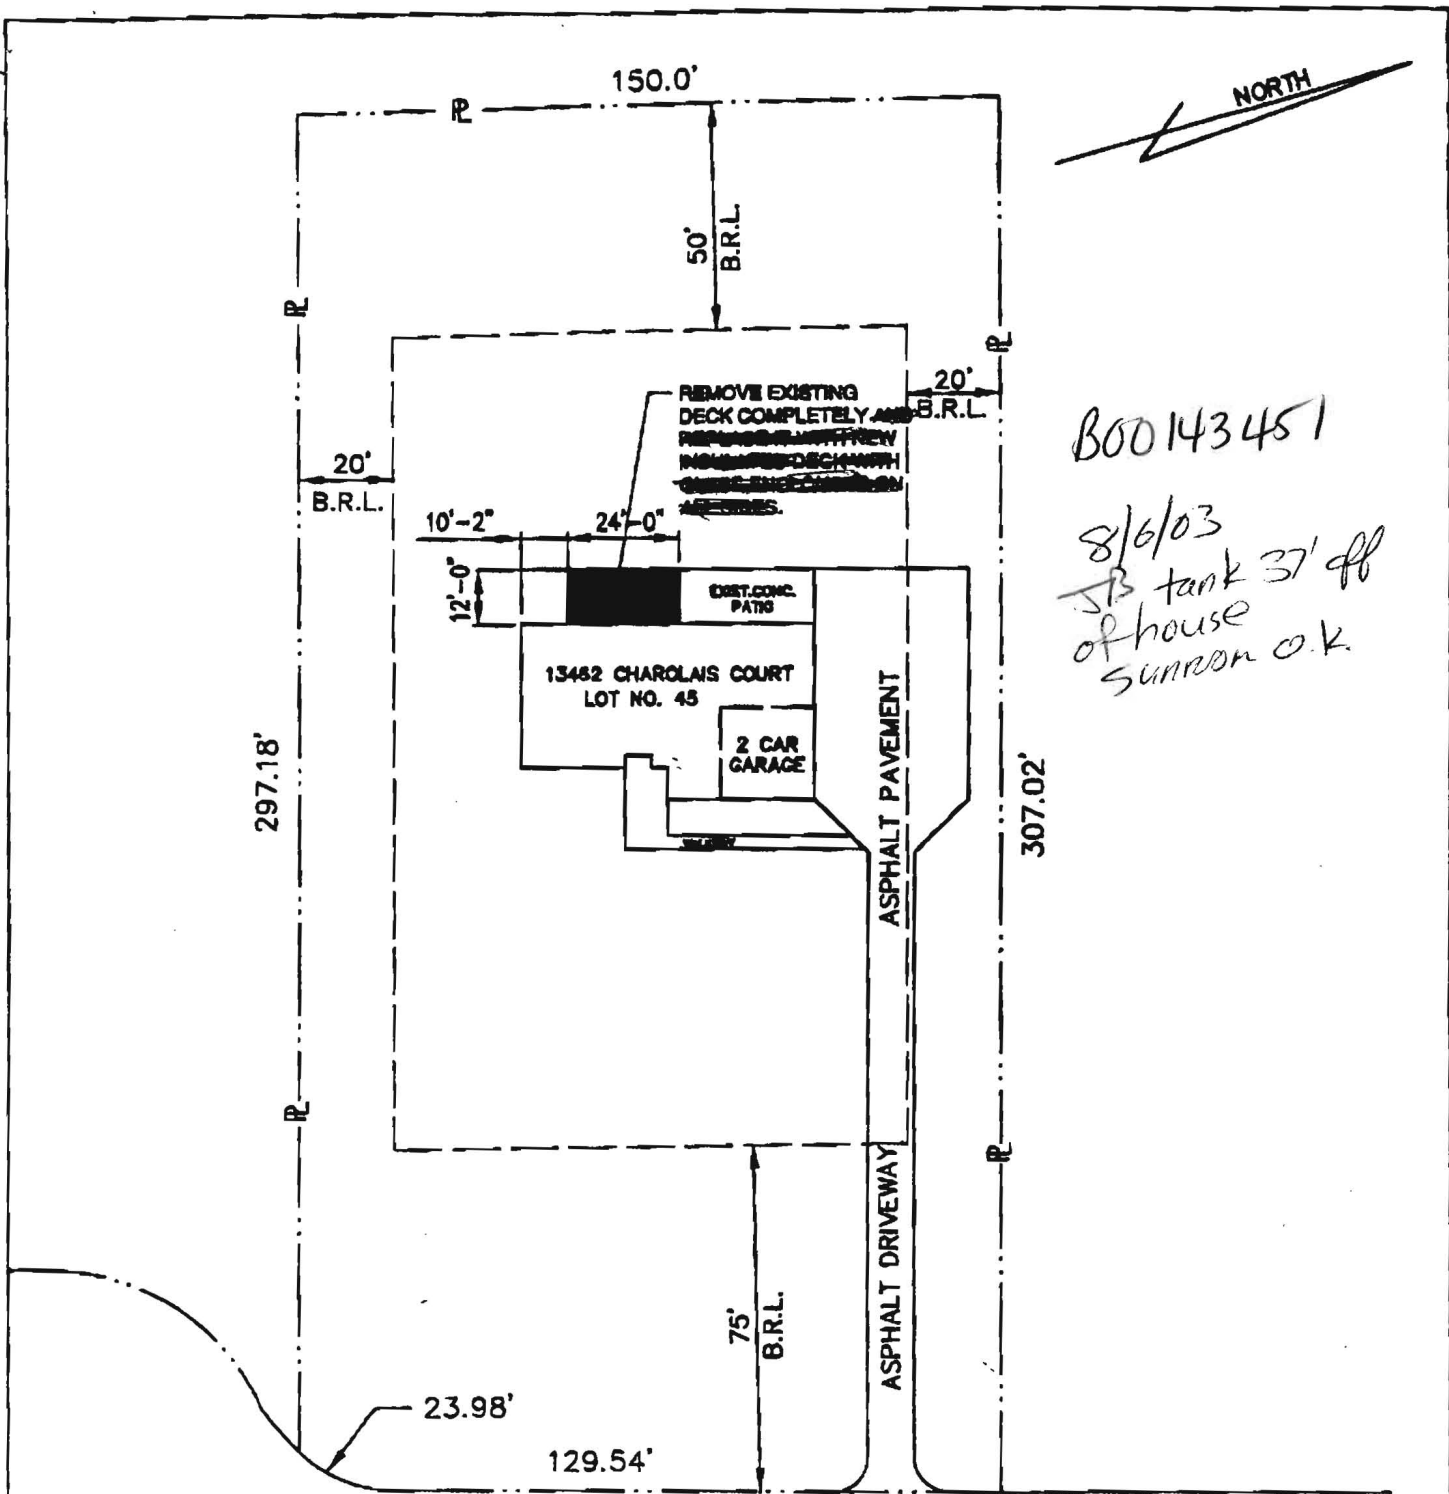

B00143451

8/6/03
 JB tank 37' off
 of house
 sunroom o.k.

B.R.L.=BUILDING RESTRIC LINE

13462 CHAROLAIS COURT ALLNUTT FARM ESTATES HIGHLAND, MD-20777		
PROPOSED SUNROOM ADDITIONS SITE PLAN		
DATE JUNE 7, 2003	SCALE 1"=40'	DWG. NO. C-1