

PUB. SEWER STATUS VERIFIED BY _____

ISSUE DATE: 01/17/06

PERMIT

P 523925

APPROVAL DATE: 2/6/06

A REPAIR

ON-SITE SEWAGE DISPOSAL SYSTEM HOWARD COUNTY HEALTH DEPARTMENT BUREAU OF ENVIRONMENTAL HEALTH

F. Timothy Roarty IS PERMITTED TO INSTALL ALTER

ADDRESS: 7414 Cherry Tree Drive PHONE NUMBER: 301-725-0032

SUBDIVISION: _____ LOT NUMBER: _____

ADDRESS: 7404 Cherry Tree Drive PROPERTY OWNER: F. Timothy Roarty

SEPTIC TANK CAPACITY (GALLONS): _____

PUMP CHAMBER CAPACITY (GALLONS): _____

NUMBER OF BEDROOMS: 3

SQUARE FEET PER BEDROOM: _____

LINEAR FEET OF TRENCH REQUIRED: _____

**BUILDING PERMIT SIGNED
AND RETURNED**
B07003303- inground pool


TRENCHES:	Trench to be _____ feet wide. Inlet _____ feet below original grade. Bottom maximum depth _____ feet below original grade. Effective area begins at _____ feet below original grade. _____ feet of stone below distribution pipe.
LOCATION:	
PURPOSE:	Septic tank needs to be moved and percing required. Call for inspection when ground is opened so sanitarian can recommend repair.

PLANS APPROVED: _____ DATE: _____

- NOTE: PERMIT VOID AFTER 2 YEARS
- NOTE: CONTRACTOR RESPONSIBLE FOR SCHEDULING A PRE-CONSTRUCTION INSPECTION FOR ALL INSTALLATIONS
- NOTE: WATERTIGHT SEPTIC TANKS REQUIRED
- NOTE: ALL PARTS OF SEPTIC SYSTEM SHALL BE 100 FEET FROM ANY WATER WELL
- NOTE: MANHOLE RISERS REQUIRED ON ALL SEPTIC TANKS AND PUMP CHAMBERS

NEITHER THE HOWARD COUNTY COUNCIL OR THE HEALTH DEPARTMENT IS RESPONSIBLE FOR THE SUCCESSFUL OPERATION OF ANY SYSTEM PERMITTEE RESPONSIBLE FOR OBTAINING FINAL APPROVAL ON THIS PERMIT CALL 410-313-2640 FOR INSPECTION OF SEPTIC SYSTEM

NOT TO SCALE

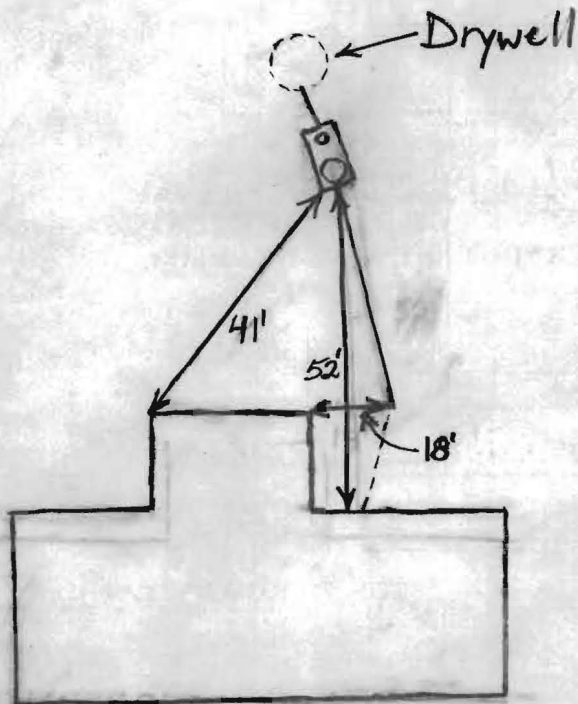

Cherry Tree Drive

ROAD

TRENCH/DRAINFIELD DATA		
WIDTH	INLET	BOTTOM
_____	_____	_____
NUMBER OF TRENCHES _____		
TOTAL LENGTH _____		
ABSORPTION AREA _____		
DISTRIBUTION BOX LEVEL _____		
DISTRIBUTION BOX BAFFLE _____		
DISTRIBUTION BOX PORT _____		

SEPTIC TANK DATA	
SEPTIC TANK 1 LEVEL	<u>Yes</u>
CAPACITY	<u>1500</u> GAL
SEAM LOC	<u>Top</u>
TANK LID DEPTH	<u>~6.5'</u>
BAFFLES	<u>Yes</u>
BAFFLE FILTER	<u>No</u>
MANHOLE LOC	<u>Front</u>
6" PORT LOC	<u>Rear</u>
WATERTIGHT TEST	<u>No</u>
SEPTIC TANK 2 LEVEL	<u>N/A</u>
CAPACITY	_____ GAL
SEAM LOC	_____
TANK LID DEPTH	_____
BAFFLES	_____
BAFFLE FILTER	_____
MANHOLE LOC	_____
6" PORT LOC	_____
WATERTIGHT TEST	_____


2-Comp.
Babylon
Traffic
Bearing
Lid

PRE-CONSTRUCTION _____

INSTALLATION 2/6/06 New tank set. Depth approved by S. Oster per phone conversation. Old tank pumped out and filled in per Robert Trujillo (BB)

FINAL INSPECTOR B. Baker

DATE OF APPROVAL 2/6/06

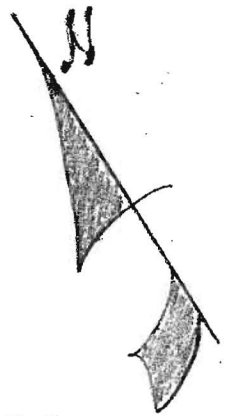

N 51° 06' 10" W
215.0'

5' UTILITY & DRAIN ESMT.

50 45 40 30 25

LOT 38
1.0101 AC ±

A.

B.

LOT 20
SDA ~ 11,000 ft²

S 15° 04' 10" W
DRAINAGE ESMT.

Trailer

DW

NW ST location

ONE STORY ADDITION

NEW AREAWAY

ST needs to be moved ~ 35' from original location due to new SF
SF 11/28/05

3 bedrooms

EXIST BRICK PATIO

EXIST (1) STORY BLDG

FRONT PORCH

EXIST DRIVE

CHERRY TREE DRIVE
A = 130.0'
R = 445.0'

SURVEY PREPARED FOR:
MR & MRS TIMOTHY ROARTY
7414 CHERRY TREE DRIVE
CLARKSVILLE, MD
HOWARD CTY.

INFORMATION TAKEN FROM SURVEY.
PREPARED BY:
SURVEY ASSOCIATES

LOT 38 HOPKINS MEAD
SEC 3 REVISED
BOOK 17 FOLIO 170 DIST 5

200 GRAYS RD
HARWOOD, MD 20716
410-266-7211

DATE: 5/4/05
SCALE: 1" = 40'