

5/10/78

Shrill need Septic Tank. Check in Bed.
Need little more gravel in Bed.

PERMIT

SEWAGE DISPOSAL SYSTEM

MARYLAND STATE DEPARTMENT OF HEALTH

HOWARD COUNTY

ELLICOTT CITY

DISTRICT _____

INDEXED

DATE 4/10/78

William Munn IS PERMITTED TO INSTALL ALTER _____

ADDRESS _____ PHONE _____

SUBDIVISION Moorefield ROAD _____ LOT 14, Blk. A, Plat 3

PROPERTY OWNER Mr. William Munn

ADDRESS _____

SPECIFICATIONS 3 bedrooms

SEPTIC TANK CAPACITY 1000 GALLONS

DRAIN FIELD _____ DEPTH _____ FEET, BOTTOM AREA _____ SQ. FT.

DEEP TRENCH _____ DEPTH _____ FEET, BOTTOM AREA _____ SQ. FT.

SEEPAGE PITS _____ ABSORBENT SIDE-WALL AREA _____ SQ. FT.

INLET PIPE _____ FT. BELOW ORIGINAL GRADE. MAXIMUM DEPTH _____ FT. BELOW ORIGINAL GRADE

EFFECTIVE DEPTH AT _____ FT. BELOW ORIGINAL GRADE.

LOCATE DISPOSAL AREA _____ FT. FROM _____ LOT LINE AND _____ FT. FROM _____ LOT LINE AS SEEN WHEN

FACING LOT FROM

DRY WELL-dug 15 ft. sq. - set block & top for 12 ft. diameter and fill in rest of pit with gravel. Dry well to have 6 ft. effective depth below the inlet pipe. Inlet pipe to be 3 ft. below original grade. Maximum depth of dry well is 9 ft. below original grade. Come off dry well 5 ft. earth buffer and begin trench. Trench to be 9 ft. deep, 2 ft. wide, 30 ft. long with 6 ft. of stone and follow contour of ground and be inspected before gravel is installed. Place the dry well 60 ft. from front lot line and 100 ft. from the right side line as seen when facing from the front.

PLANS APPROVED BY Donald W. Monaghan, DATE 4/10/78

COVER NO WORK UNTIL INSPECTED AND APPROVED.

NEITHER THE HOWARD COUNTY COUNCIL NOR THE HEALTH DEPARTMENT IS RESPONSIBLE FOR THE SUCCESSFUL OPERATION OF ANY SYSTEM.

NOTE: IF TRENCH IS USED CALL FOR INSPECTION BEFORE PLACING GRAVEL IN TRENCH.

NOTE: NO DRY WELL SHALL EXCEED 16 FOOT IN DIAMETER.

NOTE: ALL PIPE FROM HOUSE TO DISPOSAL AREA MUST BE CAST IRON.

PERMIT VOID AFTER THREE YEARS.

NOTE: INSTALL STAND PIPE ON SEPTIC TANK AND DRY WELL. STAND PIPES MUST BE 6 INCHES IN DIAMETER. CAST IRON, CONCRETE OR TERRA

COTTA ACCEPTED.

***INSTALLER IS RESPONSIBLE FOR OBTAINING FINAL APPROVAL ON THIS PERMIT.**

HD - 23 5-178 - specs changed - see next sheet - to install. & Bed.

Jesse Miller Lot 2


5/1/78 MR.
Index and
File - see
letter attached
from plumber.

P 27784

09207

BLDG. PERMIT SIGNED
AND RETURNED 5/11/78
serial # 35554
Pool permit signed
5/23/78 - serial No. 35555

A09207

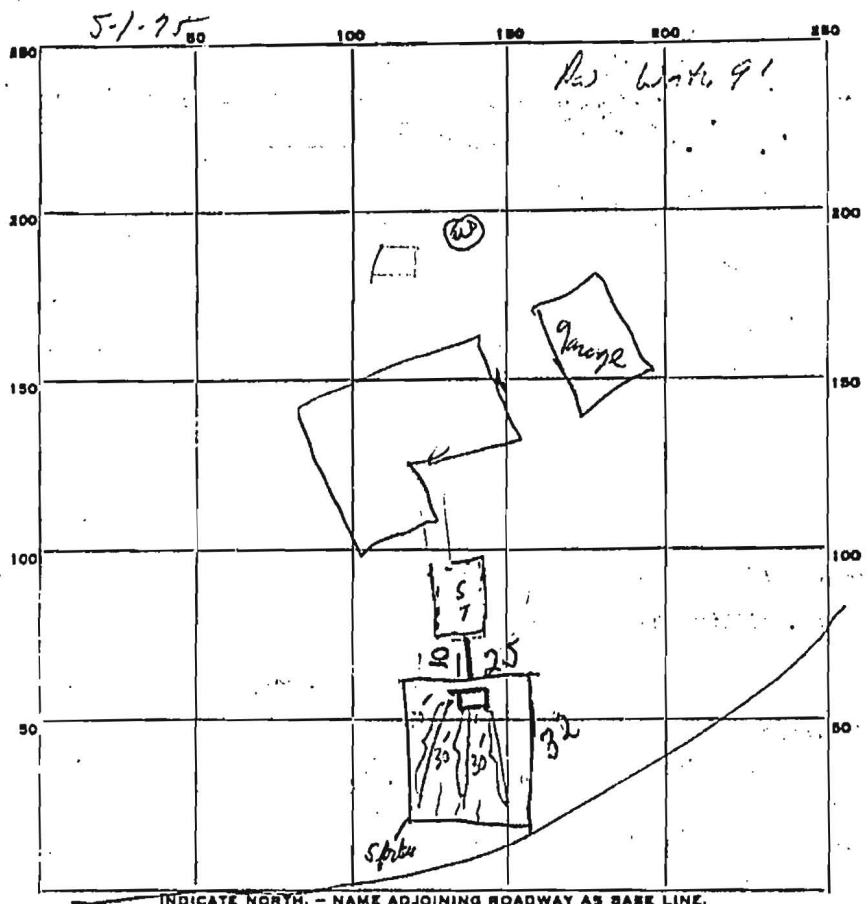

Permit 23811
 repair? Voided
 11-20-64
 8-31-76 R.H.

PERMIT CARD _____ ST

SEPTIC TANK, LEVEL OK CLEANOUTS NO

DISTRIBUTION BOX, LEVEL OK

TILE FIELD, DEPTH _____ FT. TRENCH WIDTH _____ FT.

GRAVEL DEPTH _____ IN. TOTAL LENGTH _____ FT.

NUMBER OF TRENCHES _____ TOTAL BOTTOM AREA _____

SEEPAGE PITS, INSIDE DIAMETER _____ FT. DEPTH BELOW INLET _____ FT.

ABSORBENT AREA _____ SQ. FT.

REMARKS ⁵⁻⁵⁻⁷⁸ Mount 7. 2' deep - ok to put gravel in bed. ^{5/9/78} 110

III. BOX IN STALLGD - PUT STONE IN BED & CALLS R.H.

5/9/78: Not Ready needs more gravel. must cover enough
 gravel over pipe in the trench. Also need to have
 a cleanout on Septic Tank CMB.

5/11/78 As Per Conversation Mr. Monahan okay to backfill over leaching bed and install
 cleanout on Septic Tank CMB.

DATE SYSTEM APPROVED _____ INSPECTOR _____