

Menu Save Reset Cancel Help

Record Detail \* (This section is required.)

Permit Type Building/Residential/Alteration/SFD Permit Number B15004972 Opened Date 11/03/2015

Description of Work Finish basemenT area. Add wall and door to mech room. Finish under stairs, hallway (3.5' x 14'), and large rec. room (52' x 15'). \*\*OWNER IS ADVISED THAT TRADE PERMITS ARE REQUIRED FOR PLUMBING AND ELECTRIC\*\*

check spelling

Address \* (This section is required.)

Search Reset Clear Get Parcel & Owner

Street # 17259 Street Name HARDY Street Type RD
Unit Type --Select-- Unit # X Coordinate -77.11535 Y Coordinate 39.34035
City MOUNT AIRY State MD Zip Code 21771 Primary Yes

Parcel \* (This section is required.)

Search Reset Clear Get Address & Owner

GIS ID \* 831272 Parcel 528 Parcel Area 40010 Land Value 165600 Improved Value 165600 Exemption Value 0

Legal Description LOT 27 40,010 SQ[ ]17259 HARDY RD[ ]SPRING HOLLOW RSB LOT 2

check spelling

Block Plan Area Section Grid SDP No. Record Plat No. Owner Occupied Historic District Registry No. Building No.

Lot 27 Census Tract 604001 Council Dist 5 Supervisor Dist Map # DAP Zone Primary Yes
State Tax Id 1404363019 Subdivision Name
Area Tax Map 7
Zoning District ADC Map 4691-B6
Final Plan No. WP File No.
WS Contract No. FDP No.
Year Built Historic District Yes No
Stat Area 4-04 Flood Plain Yes No

APPROVED
WALKTHRU BUILDING PERMIT
BP# 15004972 A#
APP. SAN 11/24/15
DESC. OF WORK:
DATE: 11/24/15

Owner (This section is not required.)

Search Reset Clear

Name \* BUECHLER JONATHAN M
Address Line 1

17259 Hardy Road #21  
**Address Line 2**  
**Address Line 3**  
**Mail City**      **Mail State**      **Mail Zip Code**  
 Mount Airy      MD      21771  
**Phone**      **Primary**  
 301-703-5959      Yes  
**E-mail**  
 jon.buechler@gmail.com  
**Cell Number**      **Fax Number**  
 4434725326

**Professionals** (This section is not required.)

Search Reset Clear

**License # \***      **Business Name**  
 15-PEOP-00021  
**License Type \***      **First Name**      **Middle Name**      **Last Name**  
 Home Owner      Jonathan           Buechler  
**Primary**      **Address Line 1**  
 Yes      17259 Hardy Rd  
**Address Line 2**  
**City**      **State**      **ZIP Code**  
 Mt Airy      MD      21771  
**Phone 1**      **Phone 2**      **Fax**  
 443-472-5326      301-703-5959  
**E-mail**

**Applicant** (This section is not required.)

Search As Owner As Lic. Prof

**Type \***      **First Name**      **MI**      **Last Name**  
 Applicant      Jonathan           Buechler  
**Relationship**      **Full Name**  
 Applicant  
**Primary**      **Organization Name**  
 Yes  
**Street Address**  
 17259 Hardy Road  
**Address Line 2**  
**City**      **State**      **Zip Code**  
 Mount Airy      MD      21771  
**Phone**      **Cell**      **Fax**  
 301-703-5959  
**E-mail \***  
 jon.buechler@gmail.com

**Contact** (This section is not required.)

Search As Owner As Lic. Prof

**Type**      **First Name**      **MI**      **Last Name**  
 Contact      JONATHAN           BUECHLER  
**Relationship**      **Full Name**  
 Owner      BUECHLER JONATHAN M  
**Primary**      **Organization Name**  
 No  
**Street Address**  
 17259 Hardy Road #21

Address Line 2

<b>City</b>	<b>State</b>	<b>Zip Code</b>
Mount Airy	MD	21771
<b>Phone</b>	<b>Cell</b>	<b>Fax</b>
301-703-5959		
<b>E-mail</b>		
jon.buechler@gmail.com		

Addtl Info

<b>Est Construction Cost *</b>	<b>Housing Units *</b>	<b>Number of Buildings *</b>	<b>Public Owned</b>
18000	0	0	No ▼
<b>Construction Type</b>			
--Select-- ▼			

RES ALT

<b>Total Square Footage *</b>	<b>Bedrooms</b>	<b>Full Baths</b>	<b>Half Baths</b>	<b>Water *</b>	<b>Sewage *</b>	<b>Existing Utilities *</b>
840	0	0	0	Private ▼	Private ▼	Electric ▼
SQFT						
<b>Existing Heating System *</b>	<b>Existing Sprinkler System *</b>	<b>Type of New Fireplace</b>		<b>Expiration Date</b>		
Electric ▼	NFPA #13D ▼	--Select-- ▼		5/22/2016		

PAYMENT INFORMATION

<b>Check 1</b>	<b>Payee 1</b>	<b>Check 2</b>	<b>Payee 2</b>	<b>SAP Doc No</b>	<b>SAP Entered</b>
ON LINE					

Submit Cancel

15004972

# APPROVED WALKTHRU BUILDING PERMIT

BP# B15004972 A#  
APP. SAN Handwritten DATE: 11/24/15  
DESC. OF WORK: Add walls for unfinished  
area as shown. **FINISHED**

4" CONCRETE SLAB w/  
WWF 66-W1.4 x W1.4 ON  
6-MIL P.V.B. ON 4" MIN.  
WASHED GRAVEL

## BASEMENT

TYPICAL HOUSE FDN. 8"  
THICK x 9'-0" HIGH POURED  
CONC. WALL ON 4" PROJ. x  
8" DEEP CONT. CONC.  
FOOTING. (SEE COVER SHEET  
FOR REINFORCING  
REQUIREMENTS)

3 1/2" BEARING WALL ON  
16" WIDE X 8" DEEP  
THICKENED CONC. SLAB


*open area  
w/ new  
walls*

11-7/8" PRE-ENGINEERED  
1" JSTS  
ABOVE @ 16" O.C.  
SUPPLIER TO PROVIDE  
SHOP DRAWINGS

*ok  
no BR  
Addition*

11-7/8" PRE-ENGINEERED  
1" JSTS  
ABOVE @ 16" O.C.  
SUPPLIER TO PROVIDE  
SHOP DRAWINGS

(2) 1-3/4" x 11-7/8" LVL JSTS

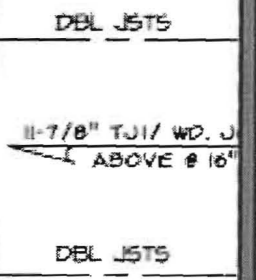


11'-0 1/2"

6'-0"

3'-1 1/2"

11'-4"

14'-1 1/2"

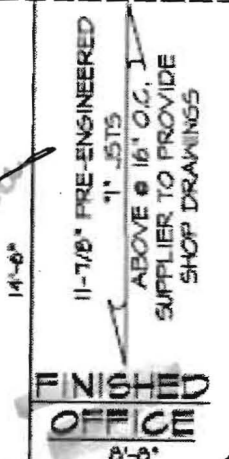

**FINISHED OFFICE**  
8'-8"

*(Already in)*

DBL JSTS

DBL JSTS

2'-6 1/4" STAIR WELL OPNG.

7'-11" STAIRWELL OPNG.

3 1/2" BEARING WALL ON  
16" WIDE X 8" DEEP  
THICKENED CONC. SLAB


UP  
16R  
0" T.  
3'-6"

(S)




**FINISHED BATH**  
5'-4"  
*(Already in)*

11-7/8" PRE-ENGINEERED  
1" JSTS  
ABOVE @ 16" O.C.  
SUPPLIER TO PROVIDE  
SHOP DRAWINGS

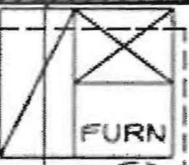

FURN

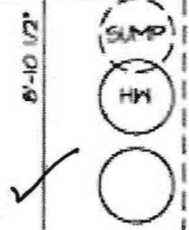

MECH.

4" LEDGE FOR GARAGE SLAB

## UNEXCAVATED

18'-10"