

12, 1974

# PERMIT

P 19467  
A 17642

SEWAGE DISPOSAL SYSTEM

MARYLAND STATE DEPARTMENT OF HEALTH

HOWARD COUNTY

**INDEXED**

ELLICOTT CITY

2/26/74 *dot complete except for sewer →  
house connections. WWT.*

DISTRICT 5

DATE 1/28/74

*File*

John T. Gibson IS PERMITTED TO INSTALL  ALTER

ADDRESS 8525 Pineway Drive, Laurel, Md. PHONE 497-0451

A SEWAGE DISPOSAL SYSTEM LOCATED AT

SUBDIVISION ROAD Brighton Dam Rd. LOT  
(see application for better directions)

PROPERTY OWNER John T. Gibson

ADDRESS

SPECIFICATIONS - 4 bedrooms

DRAIN FIELD DEPTH FEET, BOTTOM AREA SQ. FT.

SEEPAGE PITS ABSORBENT SIDE-WALL AREA SQ. FT.

SEPTIC TANK CAPACITY 1,200 GALLONS

FOR GARBAGE GRINDER, INCREASE DISPOSAL AREA 22% & TANK CAPACITY 50%.

OTHER Dry well to have 120 sq. ft. effective absorbent sidewall area per bedroom below inlet. Inlet to be 4 ft. below original grade and maximum depth 12 ft. below original grade.

Location 175 ft. from edge of road and 235 ft. in from right property line when facing lot from road. *195 R.T.*

NOTE: ALL PIPE FROM HOUSE TO DRY WELL MUST BE CAST IRON.

PERMIT VOID AFTER THREE YEARS.

NOTE: INSTALL STAND PIPE ON SEPTIC TANK AND DRY WELL.


PLANS APPROVED BY C. Streaker/Torre DATE 11/16/72 & 8/24/73

FILL SEPTIC TANK AND DISTRIBUTION BOX WITH WATER BEFORE CALLING FOR AN INSPECTION. COVER NO WORK UNTIL INSPECTED AND APPROVED.

NOTE: BUILDING PERMIT CANNOT BE RELEASED UNTIL SYSTEM IS INSTALLED AND APPROVED. NEITHER THE HOWARD COUNTY COMMISSIONERS NOR THE HEALTH DEPARTMENT IS RESPONSIBLE FOR THE SUCCESSFUL OPERATION OF ANY SYSTEM.

A 17642

INSPECTOR DATE SYSTEM APPROVED

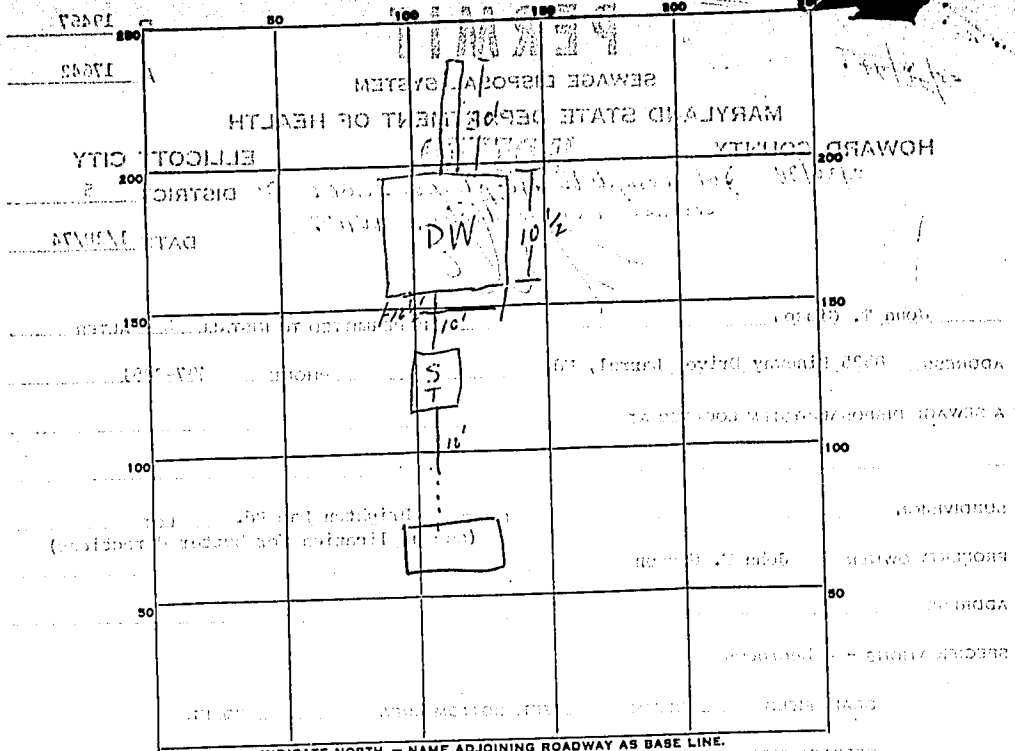

INDICATE NORTH. - NAME ADJOINING ROADWAY AS BASE LINE.  
BRIDGEWAY DAM RD

PERMIT CARD \_\_\_\_\_

SEPTIC TANK, LEVEL: 1250 gal. OK CLEANOUTS: ✓

DISTRIBUTION BOX, LEVEL: \_\_\_\_\_

TILE FIELD, DEPTH: \_\_\_\_\_ FT. TRENCH WIDTH: \_\_\_\_\_ FT.

GRAVEL DEPTH: 7' IN. TOTAL LENGTH: 30 FT. .42  
2.97  
2.10  
50.1

NUMBER OF TRENCHES: 1 TOTAL BOTTOM AREA: 210 side area

SEEPAGE PITS, INSIDE DIAMETER: outside perimeter 10 1/2 x 10 1/2 FT. DEPTH BELOW INLET: 7' FT.

ABSORBENT AREA: 510 1/4 SQ. FT.

REMARKS: 2/26/74 Location as per specs.  
Need to see connection sewer line - house  
11/14 No one at home  
12-11-74  
March /75 - Backfilled

DATE SYSTEM APPROVED: March, 1975 INSPECTOR: R. Tom

DRY WELL  
PR. GR. 4572  
EX. GR. 4594

SEPTIC TANK  
PR. GR. 4608  
EX. GR. 4618

FF 4662  
BSMT 4574

INV. 4557  
INV. 4562  
INV. 4574

x4642  
x4641

x4652

WELLO

DAM

ROAD

PLOT PLAN  
PROPERTY OF  
JOHN T. GIBSON AND WIFE  
5th ELECTION DIST. ~ HOWARD COUNTY, MD.  
FEB. 28, 1974  
SCALE: 1" = 50'