
 WATER WELL ABANDONMENT-SEALING REPORT FORM

SUBMIT COPIES OF COMPLETED FORM TO:

- * COUNTY ENVIRONMENTAL AGENCY (contact MDE, WMA if address needed)
- * WELL OWNER
- * MDE, WATER MANAGEMENT ADMINISTRATION, WELL PROGRAM

DATE WELL ABANDONED: 6-1-13 (month/day/year)

* PERMIT NUMBER OF ABANDONED WELL (if any) _____

* PERMIT NUMBER OF REPLACEMENT WELL: _____


* PERSON ABANDONING WELL: John ~~Greer~~ Greer WELL DRILLER'S LICENSE NUMBER: 086

* OWNER'S NAME: Yoriko Harigaya CIRCLE: MWD / MSD / MGD

* WELL LOCATION: Prince Georges Howard Co

SITE LOCATION MAP

COUNTY: _____
 NEAREST TOWN: LAURET
 TAX MAP 0046 BLOCK 0018 PARCEL 0088
 SUBDIVISION: _____
 SECTION: _____ LOT: _____
 STREET ADDRESS: 10676 Old Bird Mill Rd

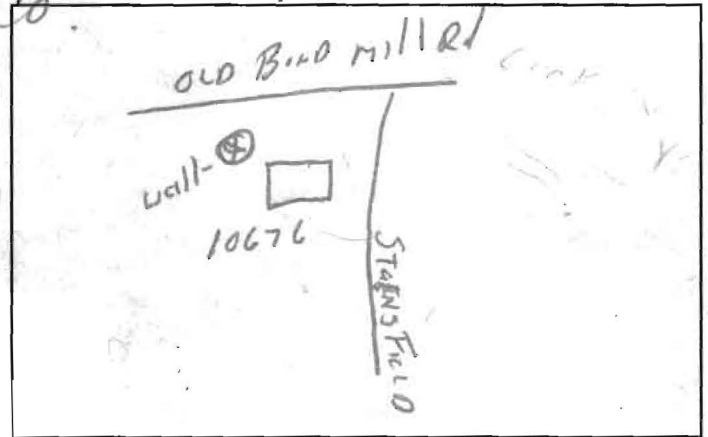

LATITUDE 3 9.133202 Starstrek Rd
 LONGITUDE 7 6.881227

* TYPE OF WELL BEING ABANDONED:
 DRILLED JETTED
 BORED HAND DUG
 OTHER (specify) _____

LOG OF SEALING MATERIAL

* USE CODE:
 DOMESTIC MUNICIPAL/PUBLIC
 IRRIGATION INDUSTRIAL
 TEST/OBSERVATION GEOTHERMAL

MATERIAL	FEET	
	FROM	TO
Sand	20	5
Cement	5	2
Backt	2	-

* TYPE OF CASING:
 STEEL PLASTIC
 CONCRETE OTHER (specify) _____

SIZE OF CASING: 36 INCHES IN DIAMETER

DEPTH OF WELL: 30 FEET DEEP

WAS ANY CASING REMOVED? YES NO
 If yes, length removed, in feet: _____

WAS CASING RIPPED OR PERFORATED? YES NO

SIGNATURE-MASTER WELL DRILLER OR SUPERVISING SANITARIAN LICENSE# _____

MWD / MSD / MGS
 CIRCLE ONE

DATE 6/1/13

COUNTY _____