

Pre

APPLICATION

SEWAGE DISPOSAL TESTING

STATE OF MARYLAND - DEPARTMENT OF HEALTH AND MENTAL HYGIENE

A 29152
P _____

HOWARD COUNTY HEALTH DEPARTMENT
ENVIRONMENTAL HEALTH SERVICES
P.O. BOX 476 ELLICOTT, MARYLAND 21043
TELEPHONE: 992-2330

DISTRICT 5th.

SEE SPECS ON SEPARATE SHEET DATE 5/21/79

BLDG. PERMIT SIGNED
AND RETURNED 6/30/83
Serial # 54631

TO: THE COUNTY HEALTH OFFICER
ELLICOTT CITY, MARYLAND

I, HEREBY, APPLY FOR THE NECESSARY TEST IN ORDER TO CONSTRUCT (OR RECONSTRUCT) A SEWAGE DISPOSAL SYSTEM.

PROPERTY OWNER S. Turner Nichols Kenneth M. Howard, Jr.
Fenton Farms, Inc. 3339 N. Chatham Rd 461-9528
ADDRESS 13938 Highland Road, Clarksville, Md. 21029 PHONE 286-2463 or 286-2993
Ellicott City, Md

PROPERTY LOCATION: 11-15-79
SUBDIVISION Now Called FENTON ESTATES LOT NO. Lot 1 on Final
TA

ROAD AND DESCRIPTION Highland Road & Triadelphia Mill Road

13420 Triadelphia Mill Road.
SIZE OF LOT 3 Acres m/1 TYPE BLDG. 3 or 4 Bedrooms

THE SYSTEM INSTALLED UNDER THIS APPLICATION IS ACCEPTABLE ONLY UNTIL PUBLIC FACILITIES BECOME AVAILABLE.

I FULLY UNDERSTAND THE FEE CONNECTED WITH THE FILING OF THIS PERC TEST APPLICATION IS NON-REFUNDABLE UNDER

ANY CIRCUMSTANCES.

SIGNATURE OF APPLICANT /s/ Jack Boender for S. Turner Nichols

APPROVED BY Raymond Hodger FOR Dry Well DATE 11/20/79

REJECTED BY _____ FOR _____ DATE _____

HOLD PENDING FURTHER TESTS _____ DATE _____

REASONS FOR REJECTION OR HOLDING 7/12/79 - PERC TIME OK CERTIFY

LOCATION & ELEVATION ONE HOLES P.H.


11/20/79 - FINAL PLAT OK
BLDG. PERMIT SIGNED AND RETURNED 4/7/83
Serial # 49443
16267 pole barn

THIS IS NOT A PERMIT

SEE
PLAN

1" = 50 FT
SCALE

BACK

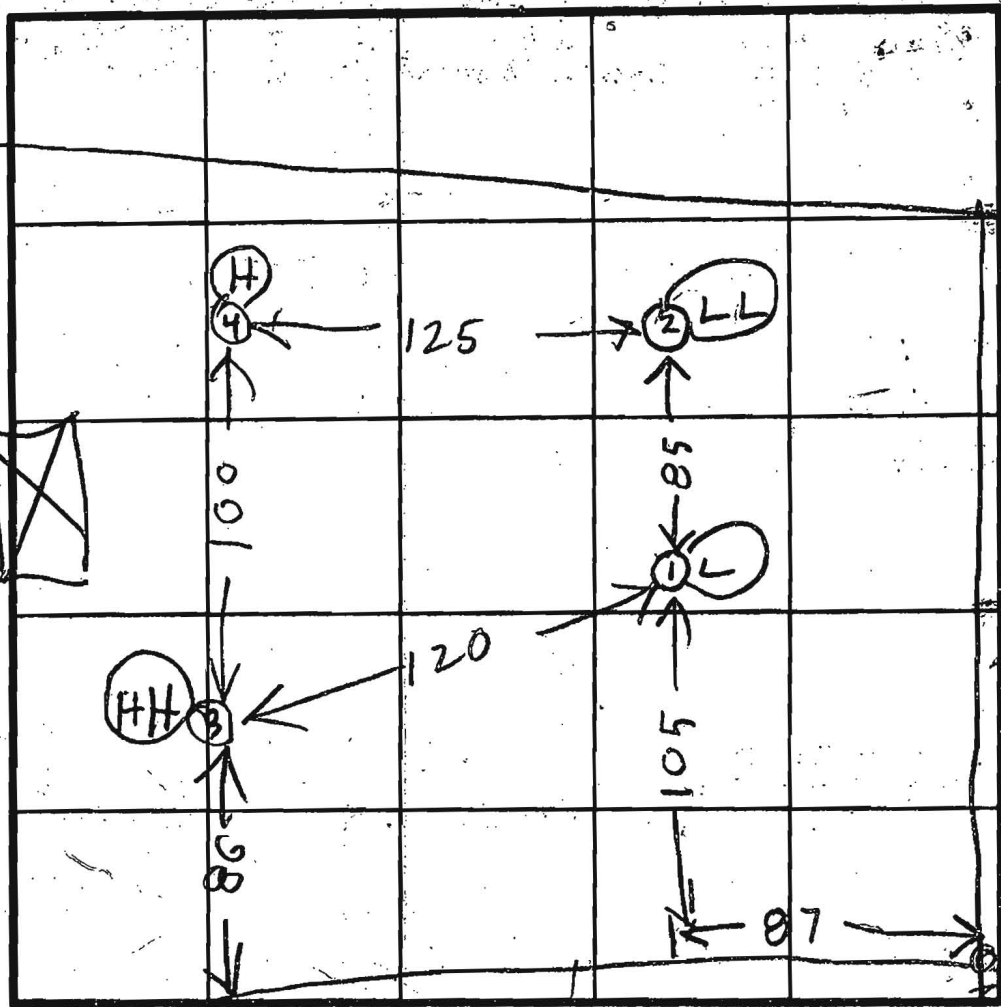

SOIL PROFILE

CLAY

USE FOR
HW
SAND
&
MICA

INDICATE NORTH - NAME ADJOINING ROADWAY AS BASE LINE.

HIGHLAND RD

HOLE
ELEVATION
HH = HIGHEST
HIGH
LL = LOWEST
LOW
H = HIGH
L = LOW

DATE	TEST NO.	DEPTH	PRE-WET		TEST - 1' DROP		TIME
			START	STOP	START	STOP	
7/12/79	1D	12 1/2	215	220	220	235	15
7/12/79	1S	3	215	217	217	220	3
	2D	12 1/2	217	219	219	228	9
	2S	4 1/2	217	219	219	221	2
	3D	12	223	227	227	235	8
	3S	4	223	225	225	227	2
7/14/79	4V	12	TOP	2 FT	CLAY	10 FT	SANDY

REMARKS _____

TYPE OF SOIL _____

TESTED BY BH ALSO PRESENT PENNY GARY