

# PERMIT

SEWAGE DISPOSAL SYSTEM

MARYLAND STATE DEPARTMENT OF HEALTH

HOWARD COUNTY

ELLICOTT CITY

DISTRICT \_\_\_\_\_

## INDEXED

DATE 2-16-59

Albert G. Burman

IS PERMITTED TO INSTALL  ALTER

ADDRESS Mt. Airy

PHONE Lykes 36394

A SEWAGE DISPOSAL SYSTEM LOCATED AT 1/2 mile McKeon Church Rd. S. of Rt. 144

SUBDIVISION \_\_\_\_\_ ROAD \_\_\_\_\_ LOT \_\_\_\_\_

PROPERTY OWNER Ridgely Warren

ADDRESS Glady

SPECIFICATIONS

DRAIN FIELD  DEPTH \_\_\_\_\_ FEET, BOTTOM AREA 150 - 2 ft. wide SQ. FT.

SEEPAGE PITS \_\_\_\_\_ ABSORBENT SIDE-WALL AREA \_\_\_\_\_ SQ. FT.

SEPTIC TANK CAPACITY 450 GALLONS

FOR GARBAGE GRINDER, INCREASE DISPOSAL AREA 22% & TANK CAPACITY 50%.

OTHER \_\_\_\_\_


PLANS APPROVED BY Palmer J. Hume

DATE 2-16-59

FILL SEPTIC TANK AND DISTRIBUTION BOX WITH WATER BEFORE CALLING FOR AN INSPECTION. COVER NO WORK UNTIL INSPECTED AND APPROVED.

NEITHER THE HOWARD COUNTY COMMISSIONERS NOR THE HEALTH DEPARTMENT IS RESPONSIBLE FOR THE SUCCESSFUL OPERATION OF ANY SYSTEM.

A  
00472

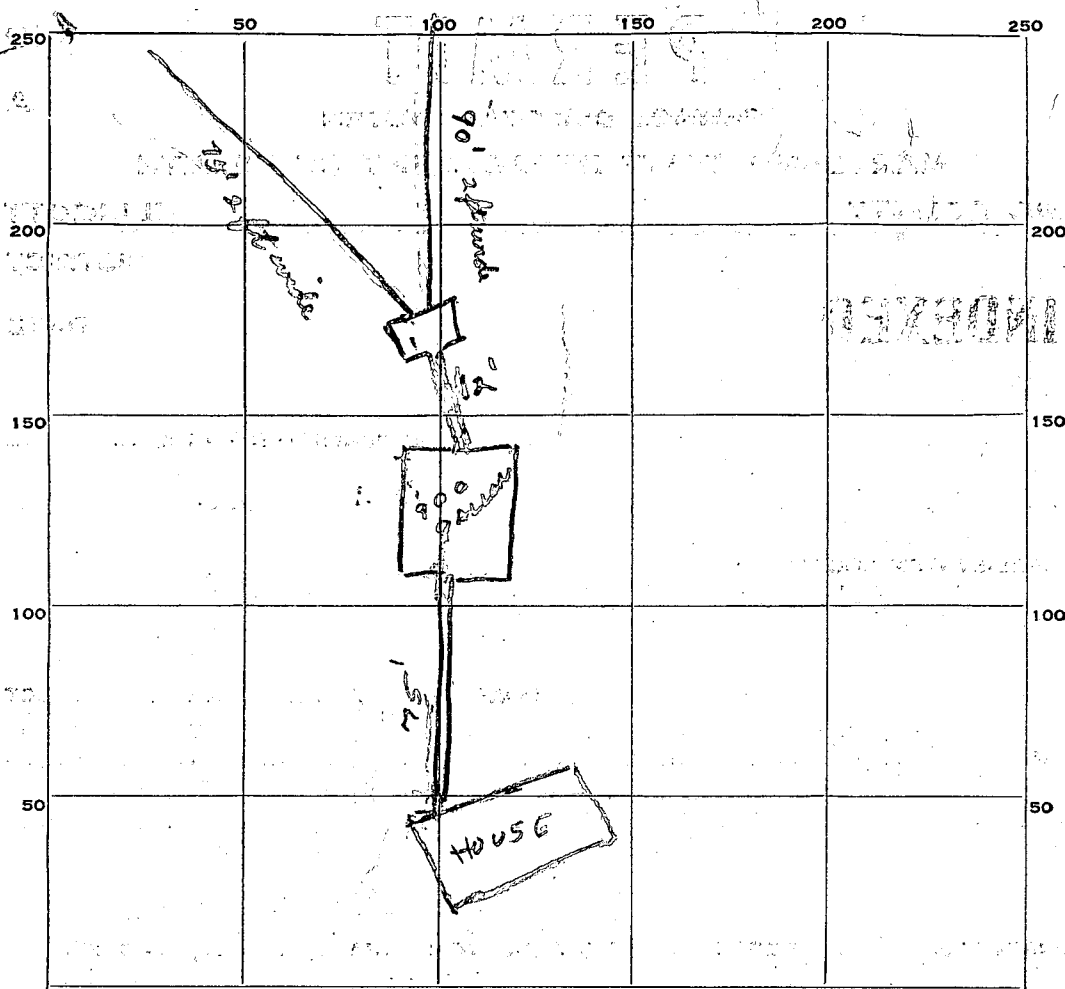

INDICATE NORTH. - NAME ADJOINING ROADWAY AS BASE LINE.

PERMIT CARD \_\_\_\_\_

SEPTIC TANK, LEVEL OK OVERSIDE CLEANOUTS \_\_\_\_\_

DISTRIBUTION BOX, LEVEL OK \_\_\_\_\_

TILE FIELD, DEPTH 3 FT. TRENCH WIDTH 2 FT.

GRAVEL DEPTH 15 IN. TOTAL LENGTH 165 FT.

NUMBER OF TRENCHES 2 TOTAL BOTTOM AREA 330

SEEPAGE PITS, INSIDE DIAMETER \_\_\_\_\_ FT. DEPTH BELOW INLET \_\_\_\_\_ FT.

ABSORBENT AREA \_\_\_\_\_ SQ. FT.

27  
3  
94

9  
2  
50  
10  
164

5' 3 X 9

27  
5  
135  
cups

90 135  
75 75  
15 670  
2 75  
3 0030

REMARKS \_\_\_\_\_

\_\_\_\_\_

\_\_\_\_\_

\_\_\_\_\_

\_\_\_\_\_

DATE SYSTEM APPROVED 2/25/59 INSPECTOR Raymond Hodges