

COUNTY #

SOIL PROFILE


0' 161
 1' topsoil
 4' org red
 brn
 cl Lm
 4.5' med
 org tan
 sil Lm
 12' redox
 features
 14'

162

0' 162
 1' topsoil
 4' dk red
 brn
 sil Lm
 4.5' med
 org tan
 sil Lm
 12.5' redox
 features
 13.5'

161

0' 161
 1' topsoil
 4.5' red org
 brn
 cl Lm
 pale
 org tan
 sil Lm
 10-19%
 sh
 14'

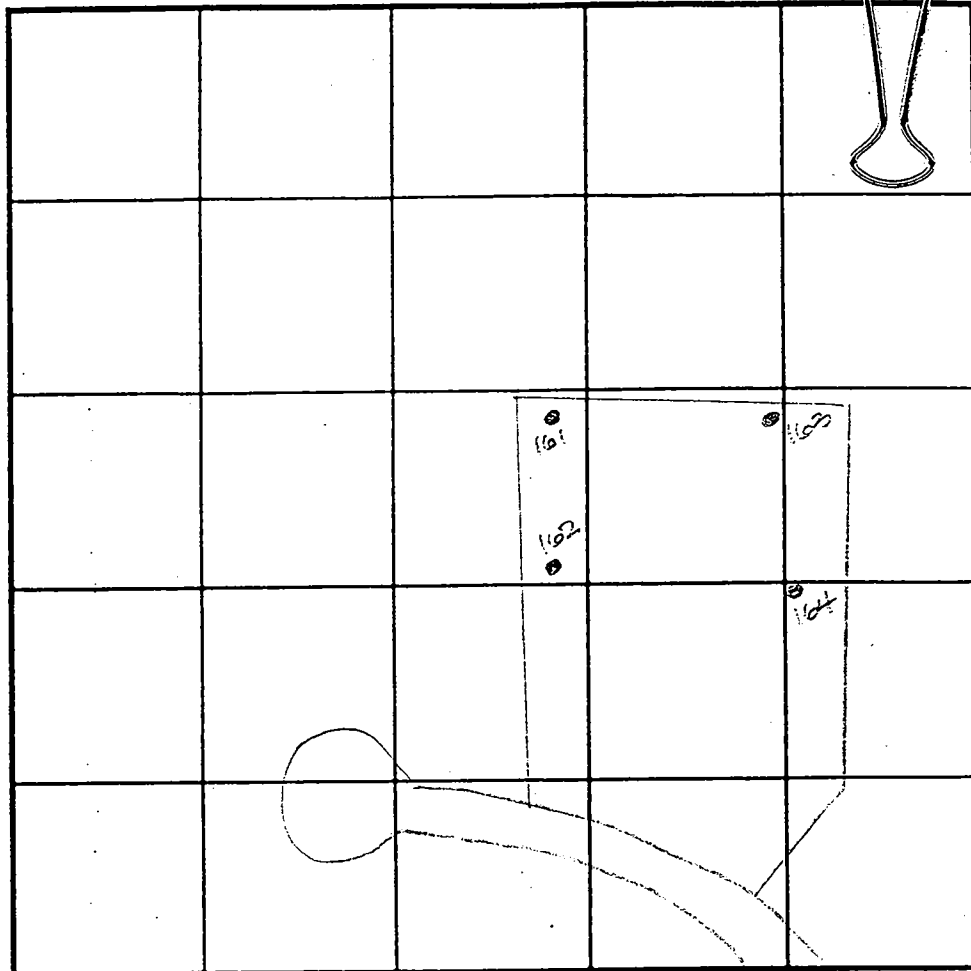

SOIL PROFILE

0' 163
 1' topsoil
 4.5' org brn
 cl Lm
 pale
 org brn
 15-20%
 sapr
 sh
 14'

INDICATE NORTH - NAME ADJOINING ROADWAY AS BASE LINE.

Triadelphia Road

DATE	TEST NO.	DEPTH	PRE-WET		TEST - 1" DROP		TIME
			START	STOP	START	STOP	
11-28-00	164	5.0' S	3:00	3:02	3:02	3:06	4
		14.0' D	Visual	- see	profile		OK
	162	5.5' S	3:13	3:14	3:14	3:17	3
		13.8" D	Visual	- see	profile		OK
11-29-00	161	5.0' S	1:59	2:01	2:01	2:04	2
		14.0' D	Visual	- see	profile		OK
	163	5.0' S	2:11	2:14	2:14	2:20	6
		14.0' D	Visual	- see	profile		OK

REMARKS

holes tested as stated

TYPE OF SOIL

TESTED BY

JJC

ALSO PRESENT Fogle's, Mr. Wain

TRENCH DESIGN DATA: AVERAGE PERCOLATION TIME

TRENCH WIDTH

INLET DEPTH

MAXIMUM BOTTOM DEPTH

SO FT/BEDROOM



UNBUILDABLE
PARCEL A
CLARKS WOODS
PRESERVATION PARCEL A
ST. ESMT. HOLDER

PARCEL EAST
CLARKS WOODS
EDGEBROOK FARM, INC.
NON-BUILDABLE
PRESERVATION PARCEL A
4839/244
PLAT NO. 14203
ZONED: RC-DEC

PARCEL 227
CLARKS WOODS I
DORSET MILL LLC
LOT 4
6577/654 550
PLAT NO. 14203
ZONED: RC-DEC

EXISTING
CORN FIELD

EX. BOE
TO BE REMOVED

EX. DIRT DRIVE
TO BE ABANDONED

EX. BOE
TO BE REMOVED

22/6 NON-BUILDABLE
PRESERVATION PARCEL A
FOR COMMUNITY SEPTIC
HOA OWNED

FUTURE
SEWAGE DISPOSAL
AREA

216/12/12
12/16/12
12/16/12

MATCH LINE SEE SHEET 8

MATCH LINE

