



HOWARD COUNTY PERMITS
By SHARI LOGAN

4/25/14

RECEIVED

APR 25 2014

LICENSES & PERMITS
DIVISION

RE: BELLEHAY ESTATE LOT (26)
15275 SWEETBAY STREET
WOODBINE, MD.
B14000816

Dear Ms. Logan

KHOVNANIAN HOMES REQUEST AN AMENDMENT TO THE ABOVE PENDING
BUILDING PERMIT APPLICATION, TO DELETE THE FINISHED DEN IN THE BASEMENT
AND TO DELETE ANY REFERENCE TO A FULL BATH ON THE FIRST FLOOR, TO
ADDRESS PUBLIC COMMENTS BY MR. JERRY WILLIAMS OF THE HOWARD COUNTY
HEALTH DEPARTMENT.

Sincerely

Chelsea Willet
240-375-4515
cwillet@khov.com

REVISED
 Date: 4/25/14
 Comments: B14000816

NOTES:
 1. ALL INTERIOR & EXTERIOR WALLS ARE SHOWN @ 3/12" UNLESS OTHERWISE NOTED.
SCALE:
 1/8" = 1'-0" @ 11 x 17
 1/4" = 1'-0" @ 24 x 36



| | |
|--------------|-----------|
| SHEET NUMBER | 38 |
| SCALE | AS NOTED |
| DRAWN BY | |
| DATE | 6-20-2013 |
| REVISIONS | |
| REVISIONS | |
| REVISIONS | |
| REVISIONS | |
| MODEL | MANHATTAN |
| SET # | |

NOTE: ALL DOORS & CLOSETS CONTIGUOUS W/ OPT. REC. ROOM ARE INCLUDED W/ REC. ROOM.
 ALL DOORS & CLOSETS CONTIGUOUS W/ OPT. DEN ARE INCLUDED W/ OPT. DEN.

SEE PAGE 60 FOR DETAILS

SEE PAGE 60 FOR DETAILS

REMOVED 4/24/14
 UNFINISHED

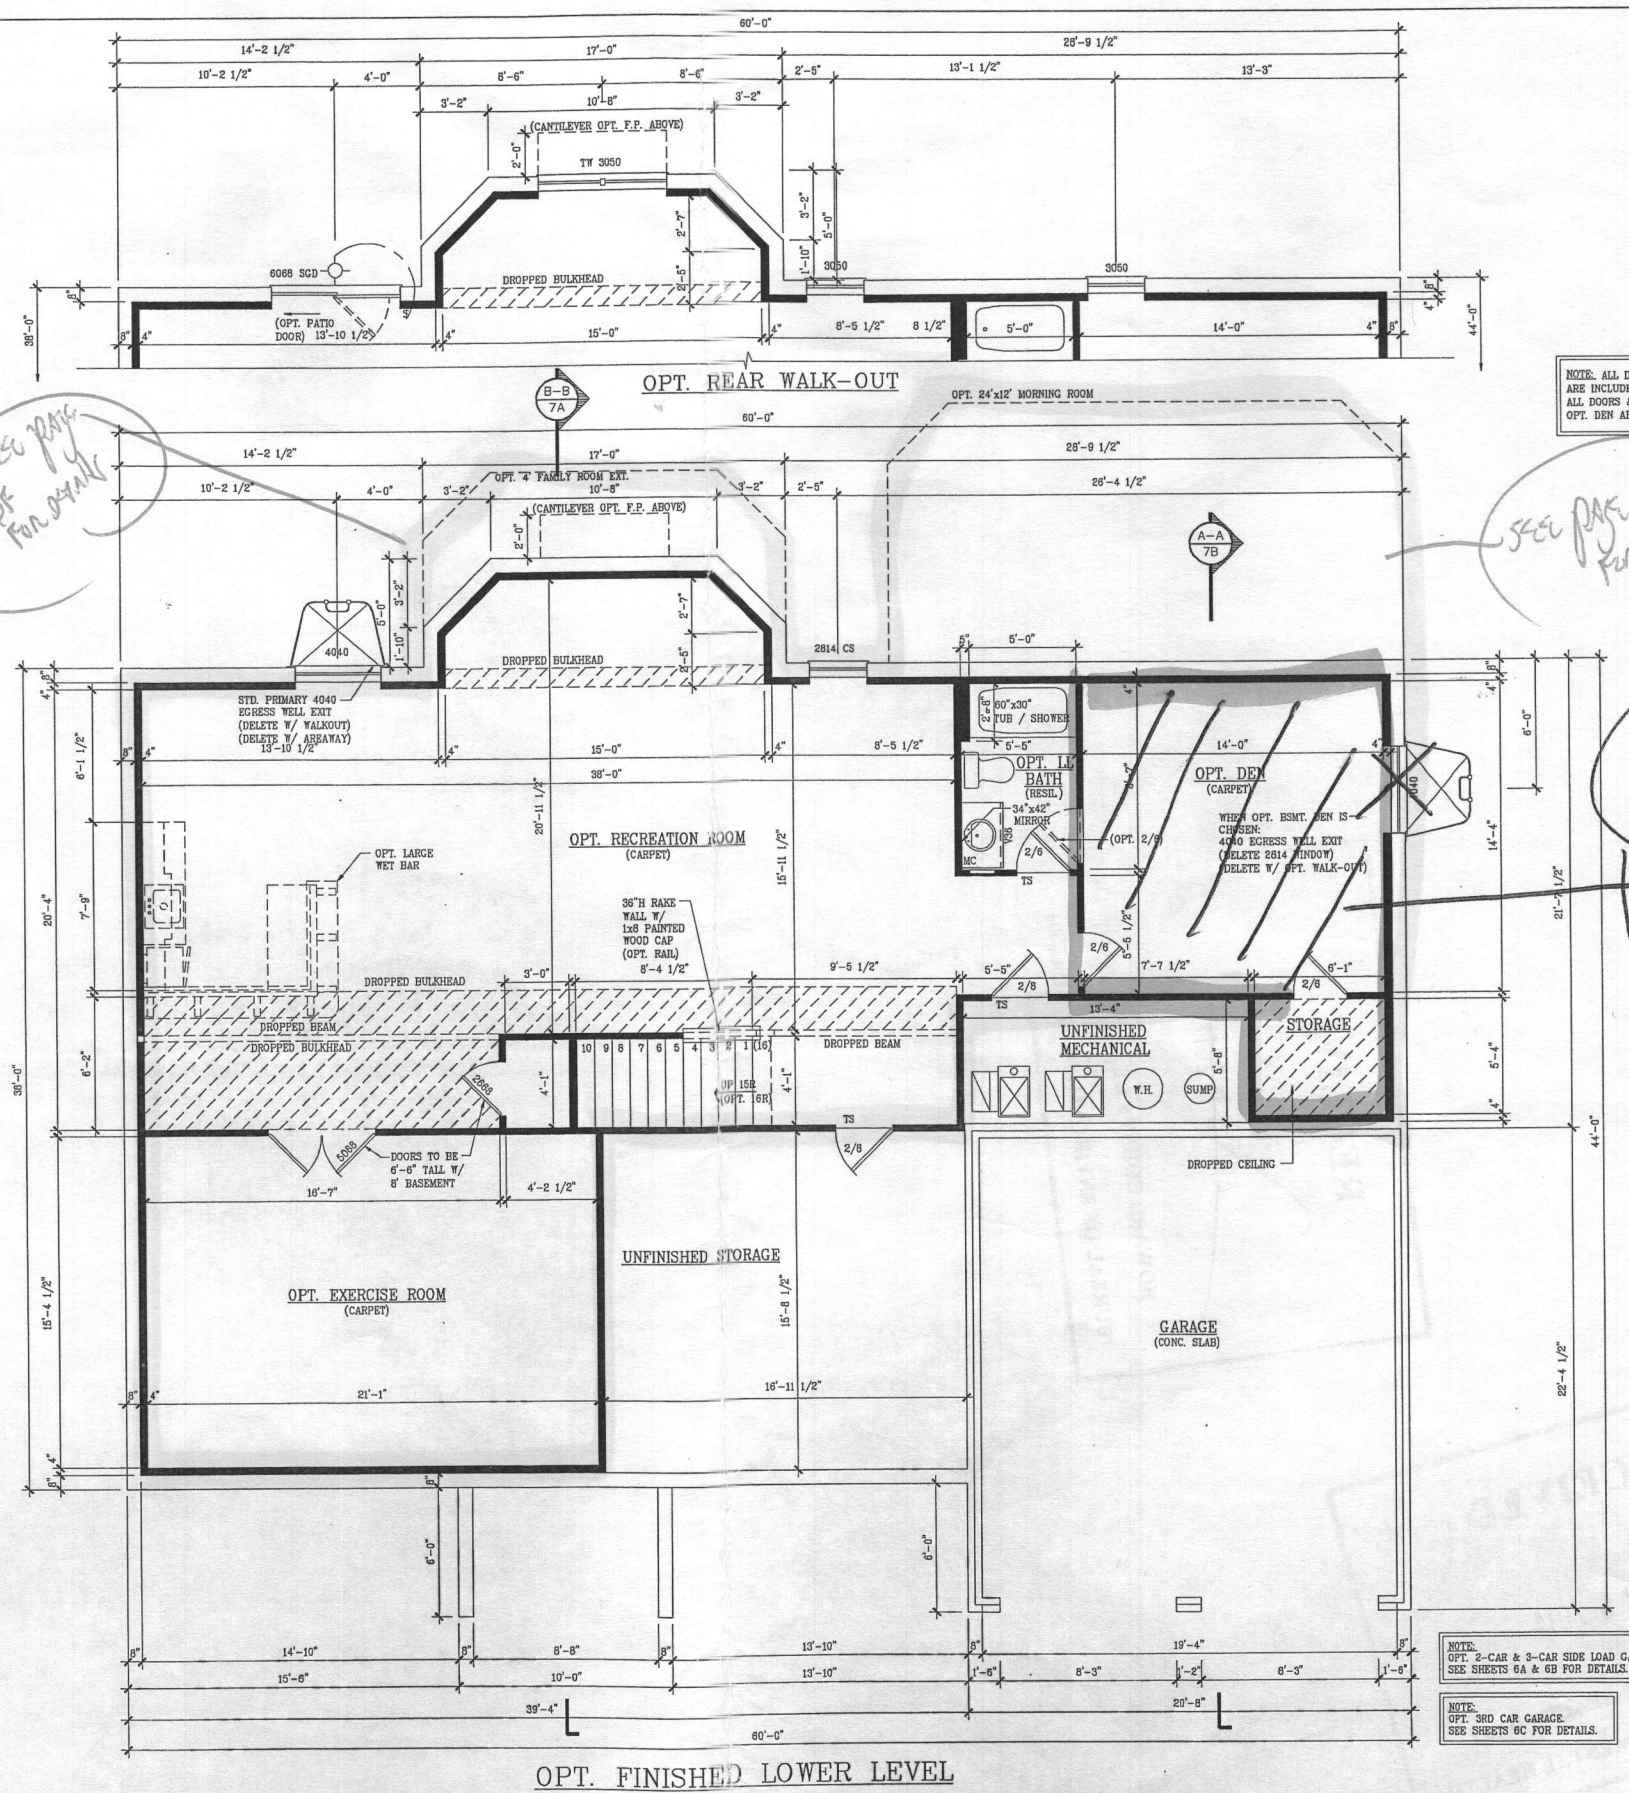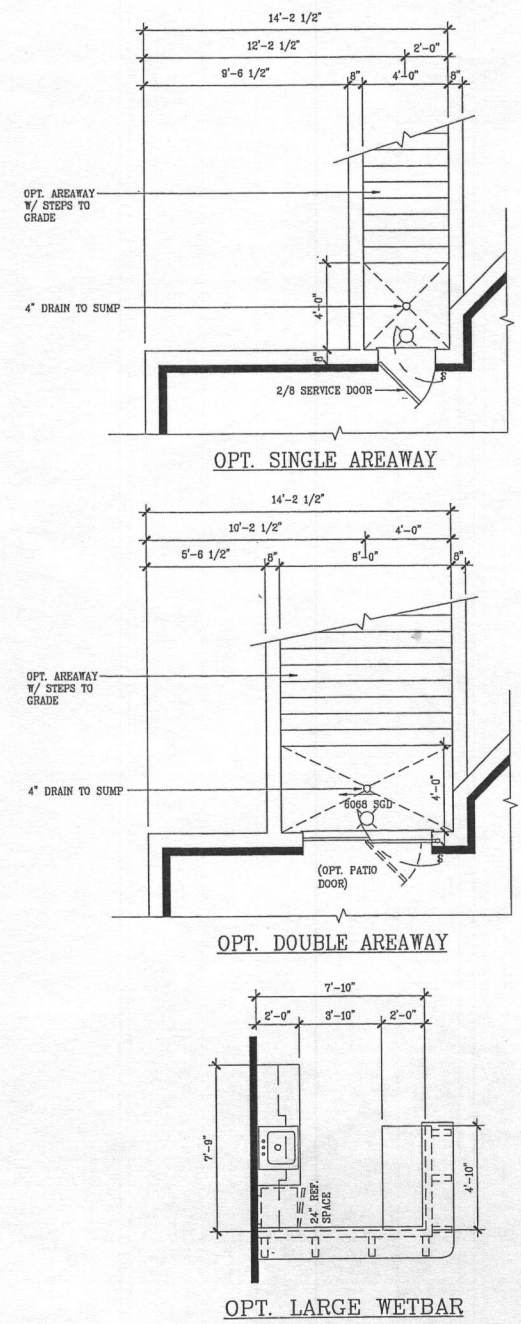


NOTE: OPT. 2-CAR & 3-CAR SIDE LOAD GARAGE. SEE SHEETS 6A & 6B FOR DETAILS.

NOTE: OPT. 3RD CAR GARAGE. SEE SHEETS 6C FOR DETAILS.

MANHATTAN
 KV198_6039


B14000816

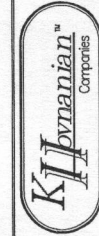


SCALE:
 1/8" = 1'-0" @ 11 x 17
 1/4" = 1'-0" @ 24 X 36

NOTES:
 1. ALL INTERIOR & EXTERIOR WALLS
 ARE SHOWN @ 3 1/2" UNLESS
 OTHERWISE NOTED.


SHEET NUMBER
 4A
 SCALE
 AS NOTED
 DRAWN BY
 DATE
 6-20-2013

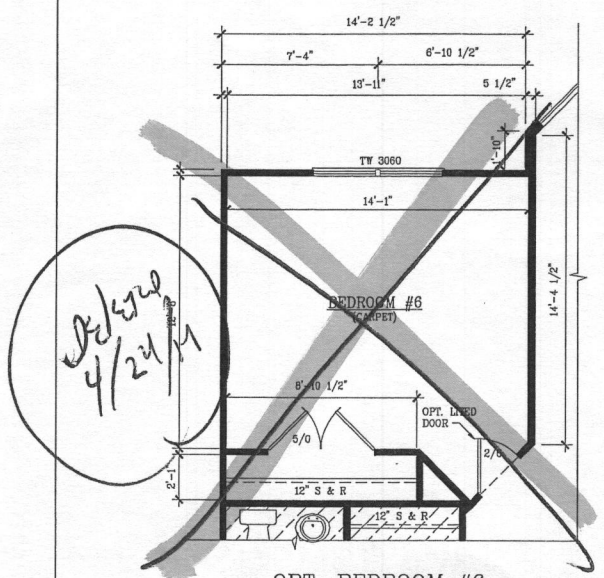


OPT. BEDROOM #6
 I/O HOME OFFICE

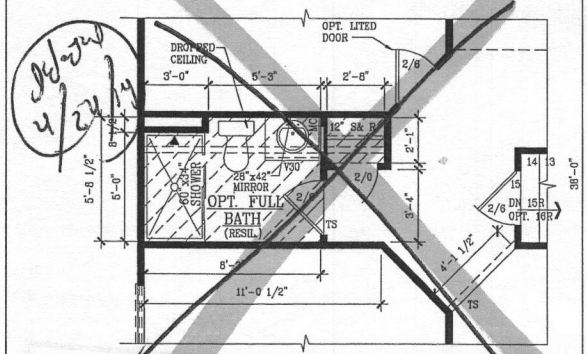

OPT. FULL BATH I/O POWDER RM.
 (N/A W/ FIRST FLOOR SUITE OPTIONS)

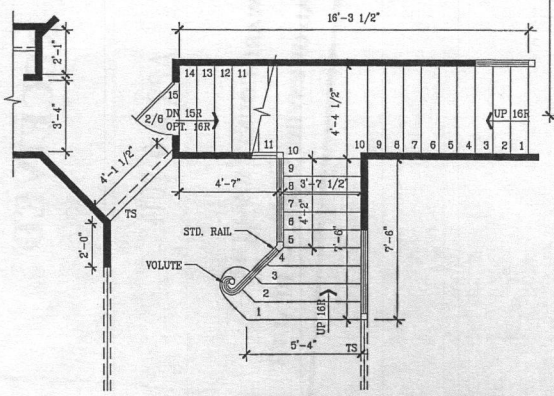

OPT. OPEN OAK FLARED STAIR

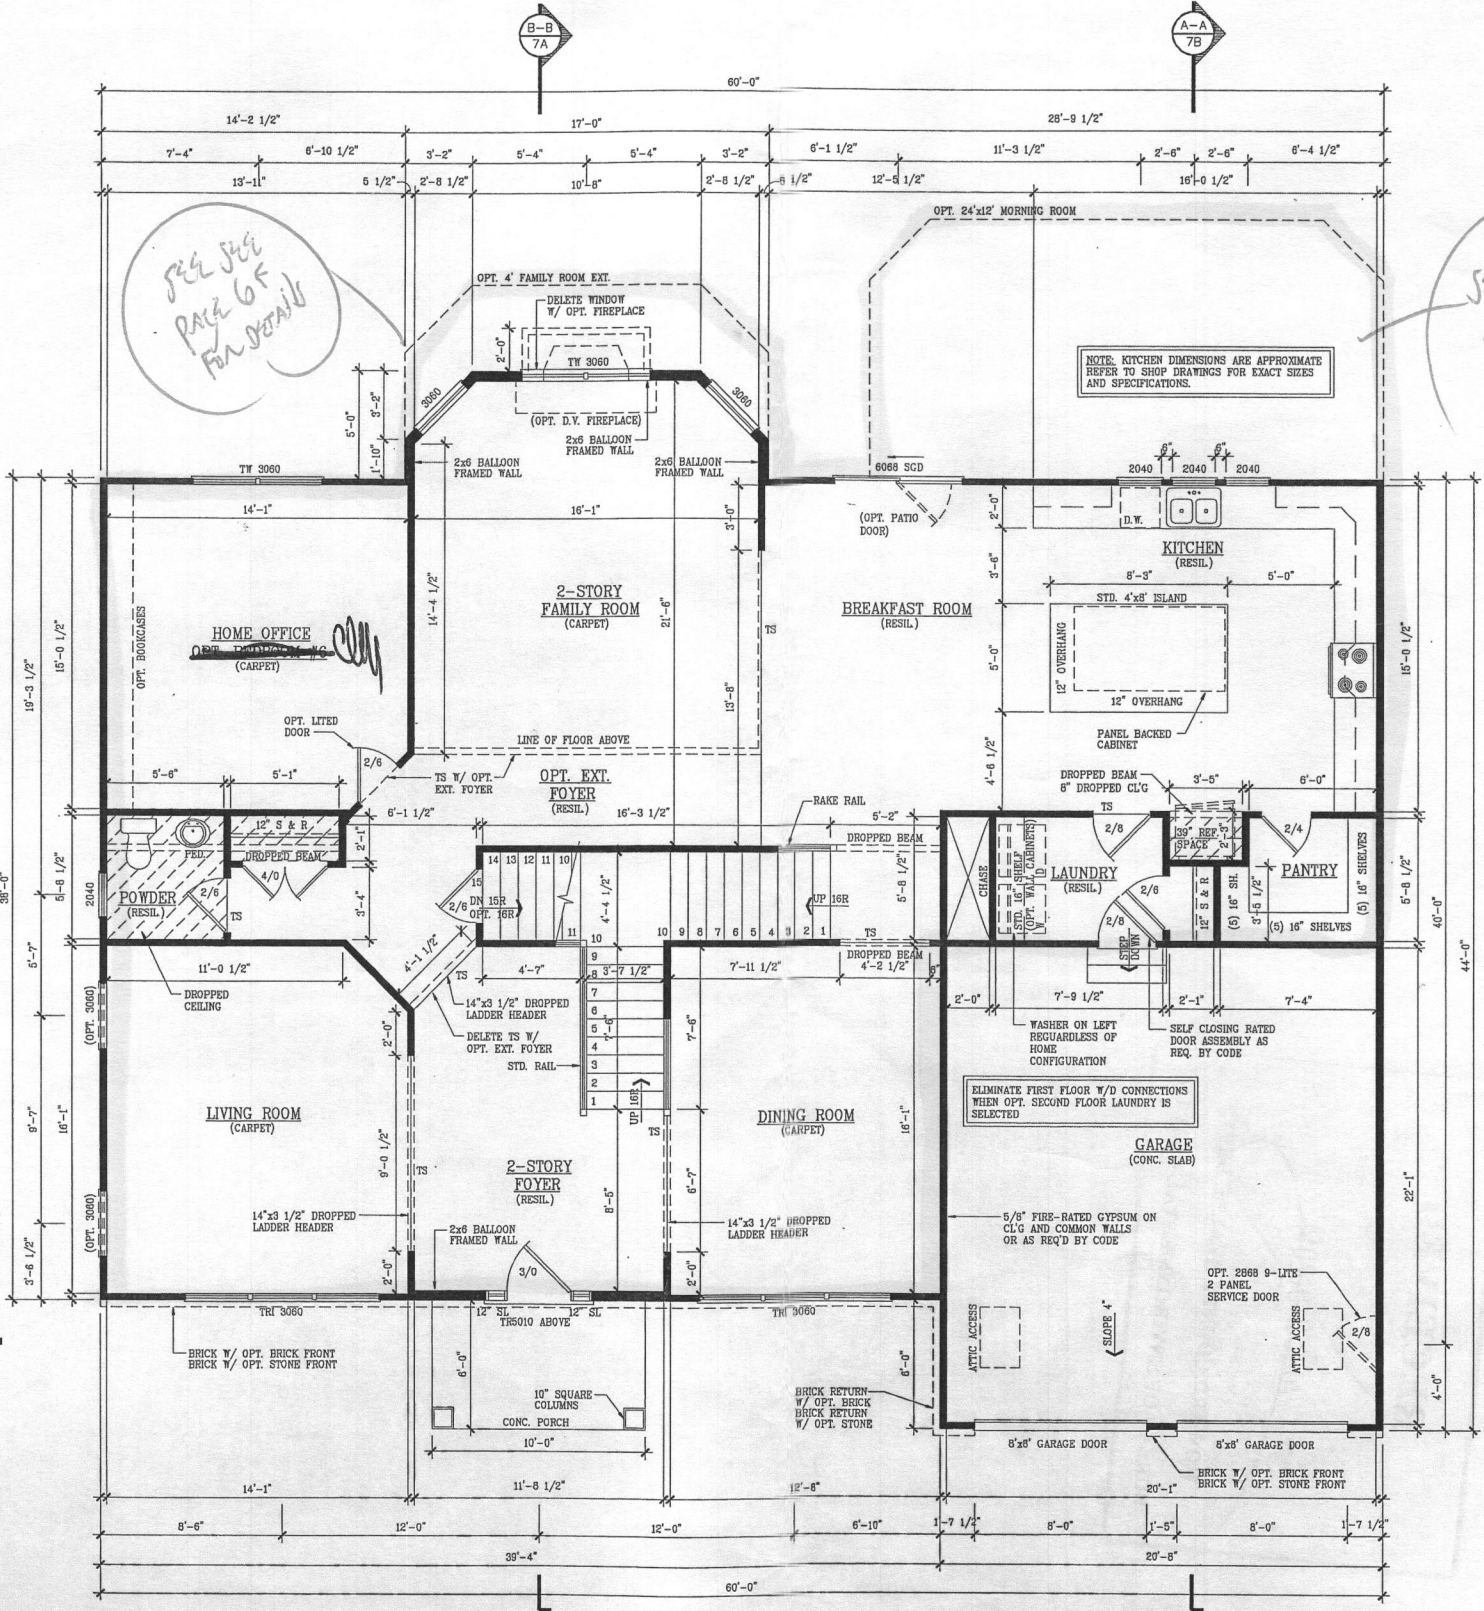


FIRST FLOOR PLAN
 ELEVATION "A"

NOTE:
 OPT. 2-CAR & 3-CAR SIDE LOAD GARAGE.
 SEE SHEETS 6A & 6B FOR DETAILS.

NOTE:
 OPT. 3RD CAR GARAGE.
 SEE SHEETS 6C FOR DETAILS.

See page 60
 for detail

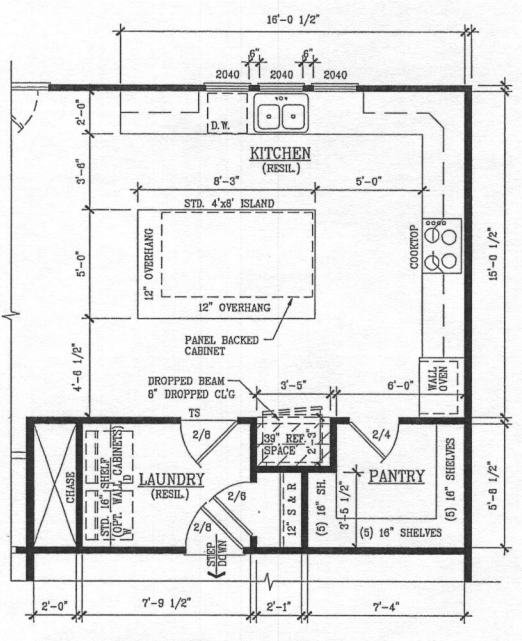

OPT. GOURMET KITCHEN


| REV# | DATE | REV# | REMARKS |
|------|------|------|---------|
| | | | |
| | | | |
| | | | |

| REV# | DATE | REV# | REMARKS |
|------|------|------|---------|
| | | | |
| | | | |
| | | | |


MODEL
 MANHATTAN
 SET #




MANHATTAN
 KV198_6039

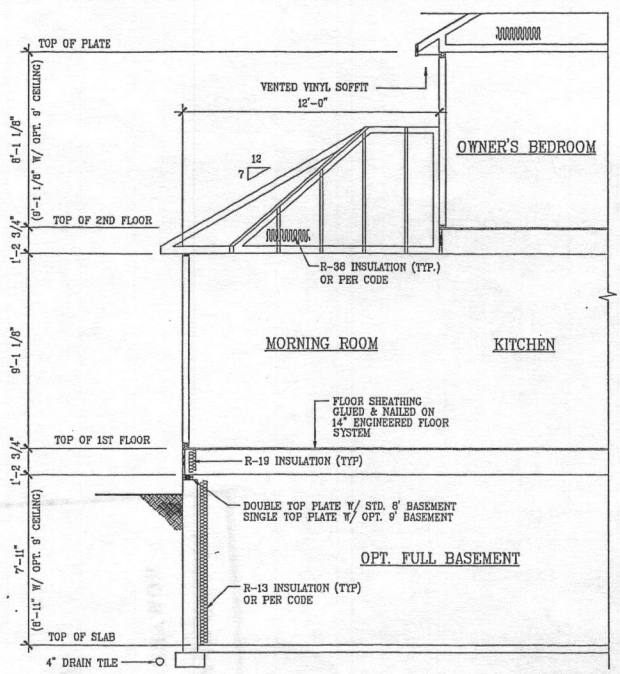


CROSS SECTION "B-B" W/ FULL BASEMENT

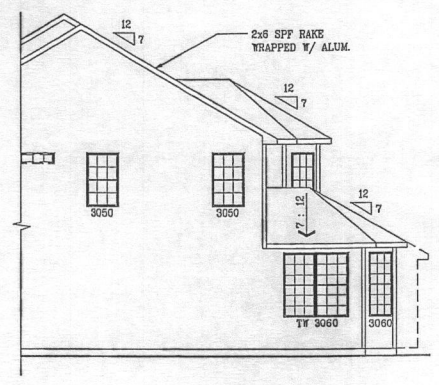

RIGHT SIDE ELEVATION
SCALE: 1/16"=1'-0" @ 11 X 17
SCALE: 1/8"=1'-0" @ 24 X 36

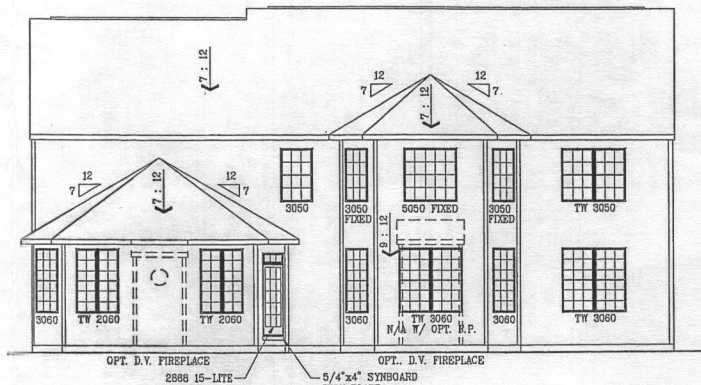

REAR ELEVATION
SCALE: 1/16"=1'-0" @ 11 X 17
SCALE: 1/8"=1'-0" @ 24 X 36

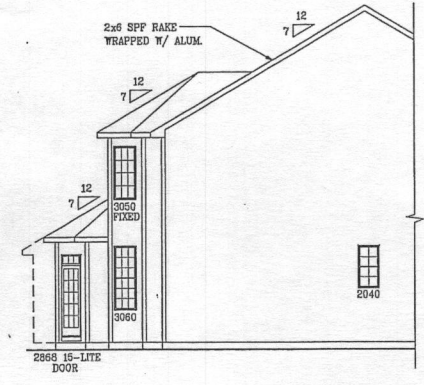


LEFT SIDE ELEVATION
SCALE: 1/16"=1'-0" @ 11 X 17
SCALE: 1/8"=1'-0" @ 24 X 36

SCALE:
1/8" = 1'-0" @ 11 x 17
1/4" = 1'-0" @ 24 X 36


NOTES:
1. ALL INTERIOR & EXTERIOR WALLS ARE SHOWN @ 3/16" UNLESS OTHERWISE NOTED.

| | |
|--------------|-----------|
| SHEET NUMBER | 60 |
| SCALE | AS NOTED |
| DRAWN BY | |
| DATE | 6-20-2013 |


| | | | |
|----------|------|----|---------|
| REVISION | DATE | BY | REMARKS |
| | | | |
| | | | |
| | | | |

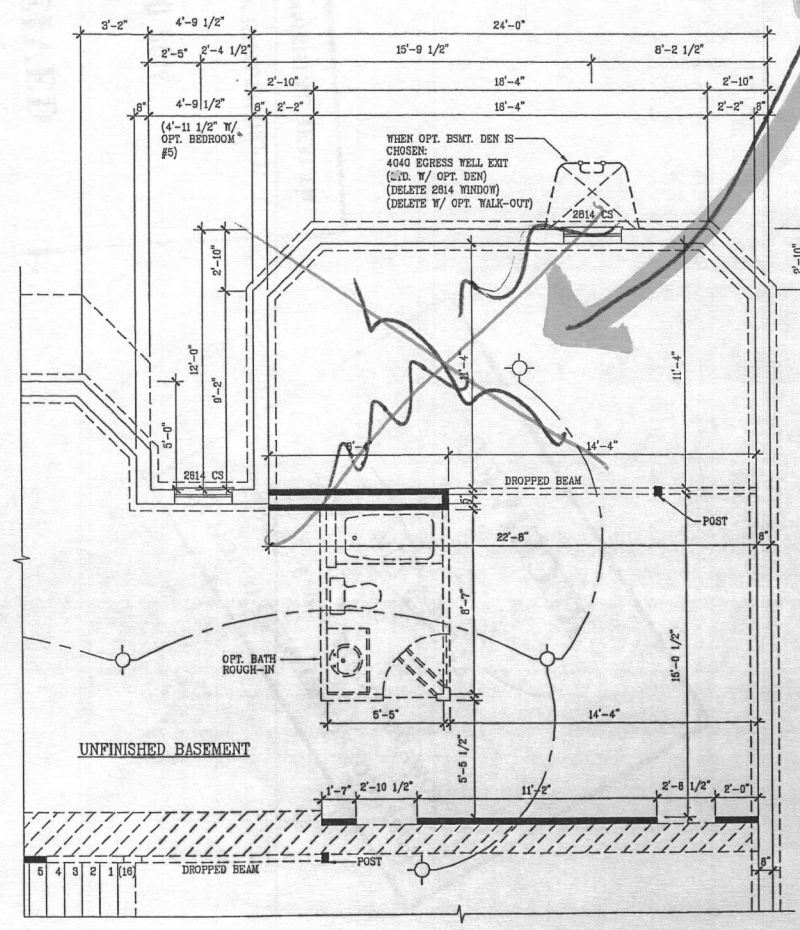

FOUNDATION PLAN - STD. BASEMENT

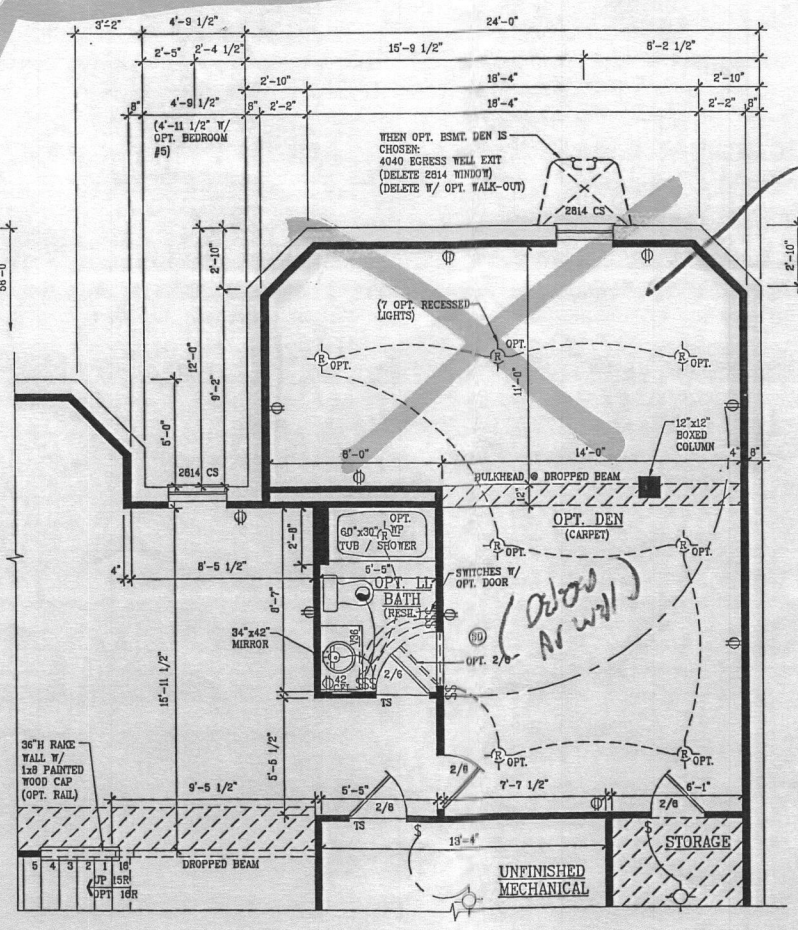

OPT. FINISHED LOWER LEVEL

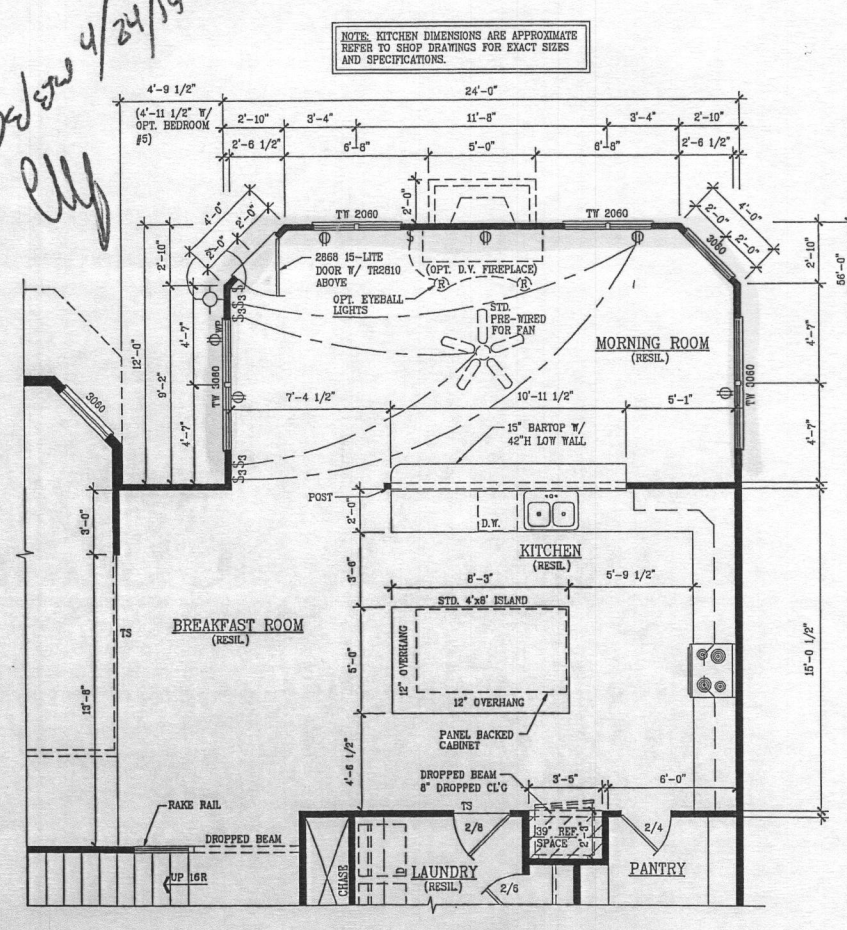

OPT. MORNING ROOM
FIRST FLOOR PLAN

MANHATTAN
KV198_6039

| | |
|-------|-----------|
| MODEL | MANHATTAN |
| SET # | |



B14000816