
 WATER WELL ABANDONMENT-SEALING REPORT FORM

SUBMIT COPIES OF COMPLETED FORM TO:

- * COUNTY ENVIRONMENTAL AGENCY (contact MDE, WMA if address needed)
- * WELL OWNER
- * MDE, WATER MANAGEMENT ADMINISTRATION, WELL PROGRAM

** No Original Well Permit Application Found*

DATE WELL ABANDONED: 12-11-2015 (month/day/year)

* PERMIT NUMBER OF ABANDONED WELL (if any) none — —

* PERMIT NUMBER OF REPLACEMENT WELL: none — —


* PERSON ABANDONING WELL: Joseph & Mayra WELL DRILLER'S LICENSE NUMBER: MSD 024

CIRCLE: MWD / MSD / MGD

* OWNER'S NAME: Charlotte B. Cottrell

* WELL LOCATION:
 COUNTY: Howard
 NEAREST TOWN: Clarksville
 TAX MAP _____ BLOCK _____ PARCEL _____
 SUBDIVISION: _____
 SECTION: _____ LOT: _____
 STREET ADDRESS: 6106 Tulane Drive

SITE LOCATION MAP

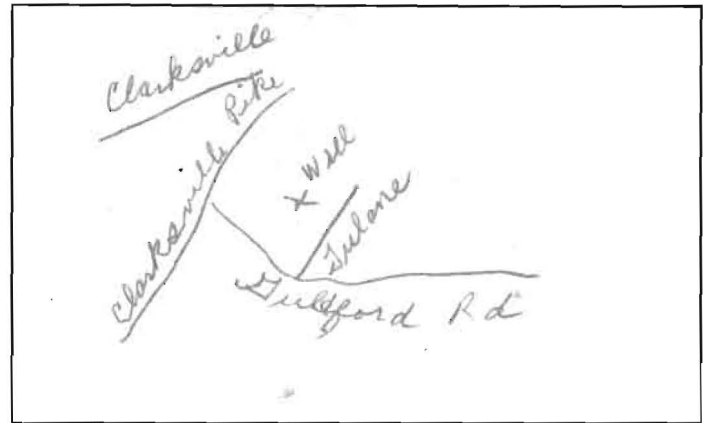

LATITUDE 3 9.20265 —

LONGITUDE 7 6.93898 —

SK KMD

- * TYPE OF WELL BEING ABANDONED:
 DRILLED JETTED
 BORED HAND DUG
 OTHER (specify) _____

LOG OF SEALING MATERIAL

MATERIAL	FEET	
	FROM	TO
<u>Cement & gravel</u>	<u>0</u>	<u>36</u>
VOLUME OF MATERIAL USED		

- * USE CODE:
 DOMESTIC MUNICIPAL/PUBLIC
 IRRIGATION INDUSTRIAL
 TEST/OBSERVATION GEOTHERMAL

- * TYPE OF CASING:
 STEEL PLASTIC
 CONCRETE OTHER (specify) _____

SIZE OF CASING: 5 5/8 INCHES IN DIAMETER

DEPTH OF WELL: 36 FEET DEEP

WAS ANY CASING REMOVED? YES NO
 If yes, length removed, in feet: 1

WAS CASING RIPPED OR PERFORATED? YES NO

SIGNATURE-MASTER WELL DRILLER OR SUPERVISING SANITARIAN Joseph & Mayra LICENSE# MSD 024 CIRCLE ONE MWD / MSD / MGS DATE 12-17-2015

COUNTY