


DRIVE

A503630

ASD/PT

MEADOW TREE COURT

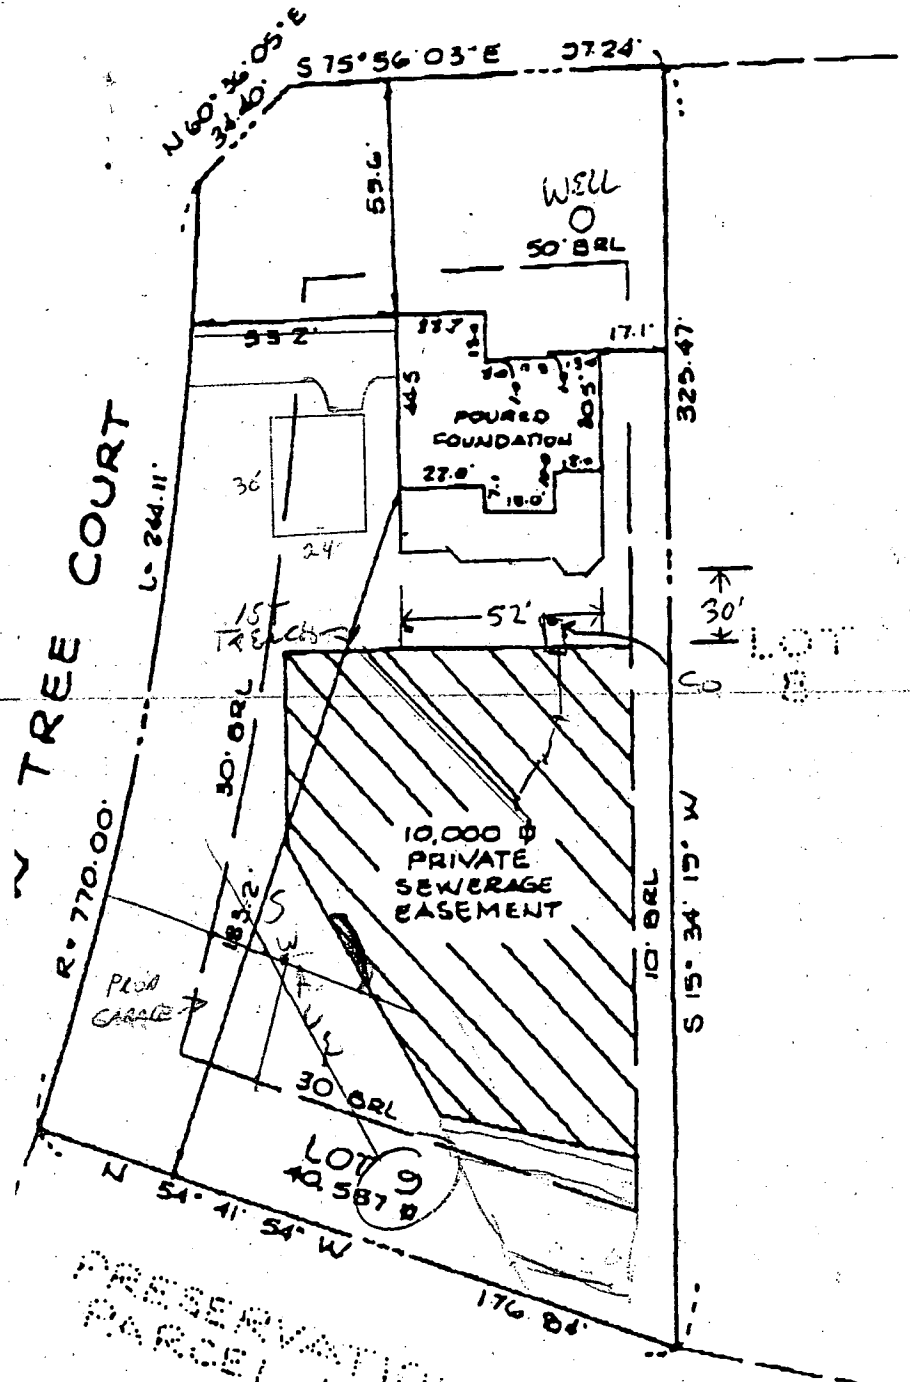

APPROVED

WALK THRU BUILDING PERMIT

BP# B00155970 A# 50368 P

APP. SAN PAY DATE: 11/11/05

DESC. OF WORK: 30x24 garage

1 story 2 car garage

RESERVATION
PARCEL 'B'

IN DRAWING
BEST OF
IE
AS THE
AT THESE ARE
SHOWN THE
GOOD HAZARD
D BELOW
PURCHASER. NO
EVEN SET.



LOCATION DRAWING
RIGGS MEADOW
LOT 9
2001 MEADOW TREE
COURT

140% OF
SUBMITTED

1150

JOB B

Department of Planning and Zoning
Howard County, Maryland
Recommendations/Comments

Date: 6/13/05

Hearing Examiner 8/1/05
Planning Board _____ Board of Appeals _____ Zoning Board _____

Petition No. BA05-020V Map No. 8 Block 22 Parcel 96 Lot 9

Return Comments by 7/15/05 to Public Service and Zoning Administration

Location of Property: Southeast of Riggs Meadow Drive and Meadow Tree Ct.

Applicant: Brian E. Witt

Applicant's Address: 2001 Meadow Tree Court, Cooksville, MD 21723

Owner: (if other than applicant) _____

Owner's Address: _____

Petition: Variance to reduce 30' building restriction line to 12.36' for a garage.

To:

- Department of Education
- Bureau of Environmental Health 6/22/05 KJS
- Development Engineering Division
- Department of Inspections, Licenses and Permits
- Department of Recreation and Parks
- Department of Fire and Rescue Services
- State Highway Administration
- Sgt. Karen Shinham, Howard County Police Dept.
- James Irvin, Department of Public Works
- MD Dept. of Human Resources, Janice Burris
(Child Day Care)
- Office on Aging, Betty Totaro (senior assisted living)
- Police Dept., Animal Control, Brenda Purvis, (kennels)
- Susan Fitzpatrick, Health Dept. (Nursing & Res. Care)
- Land Development - (Religious Facility & Age-Restricted
Adult Housing)


COMMENTS: NONE



SIGNATURE

Penny E. Borenstein, M.D., M.P.H., Health Officer

F A X

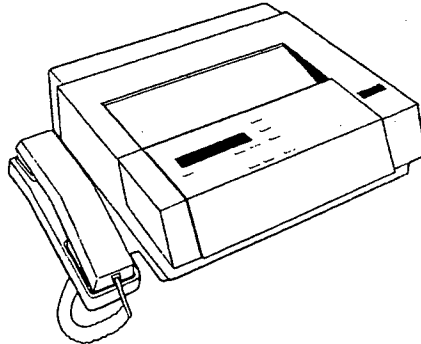

*Mr. Witt
This was
faxed on
9/19/05*

Date 9/19/05 + 10/31/08

To Brian or Robin Wurtz

Department 251-

FAX # 301-~~751~~-5541

From Kacie

Telephone 410-313-1775 FAX (410) 313-2648

Of Pages 2 (including cover page)

Comments Need site plan to scale &
S. Tank location shown. Appears
garage loc. ok. Call to verify receipt
Thanks

*B. Permit
Review*

CONFIDENTIALITY NOTICE
"WARNING: UNAUTHORIZED INTERCEPTION OF THIS TELEPHONIC
COMMUNICATION COULD BE A VIOLATION OF FEDERAL AND MARYLAND LAW"
The documents accompanying this telecopy transmission contain confidential information belonging to the sender which is legally privileged. The information is intended only for the use of the individual or entity named above. If you are not the intended recipient, you are hereby notified that any discourse, copying, distribution or the taking of any action in reliance on the contents of this telephonic information is strictly prohibited. If you have received this telecopy in error, please immediately notify sender by telephone to arrange for return of the original documents to us.