

PERMIT

SEWAGE DISPOSAL SYSTEM

MARYLAND STATE DEPARTMENT OF HEALTH

HOWARD COUNTY

ELLICOTT CITY

DISTRICT 5th

DATE 7/9/73

INDEXED

Partial 10/2/73 O.W.M. (?)
Partial 10/7/73 B.S.
18696

Hold for A 18211 final
File final

10/2/73

5/1/74

5/2/74

Tattie and Levy

IS PERMITTED TO INSTALL ALTER

ADDRESS 7000 Longview Road, Simpsonville, Md. 21150

PHONE 531-5266

A SEWAGE DISPOSAL SYSTEM LOCATED AT

SUBDIVISION _____ ROAD Brighton Dam Road LOT _____

PROPERTY OWNER Mr. Peter A. Rowell

ADDRESS 3625 Merryvale Drive, Upper Marlboro, Md.

SPECIFICATIONS 3 bedrooms

DRAIN FIELD _____ DEPTH _____ FEET, BOTTOM AREA _____ SQ. FT.

SEEPAGE PITS _____ ABSORBENT SIDE-WALL AREA _____ SQ. FT.

SEPTIC TANK CAPACITY 1000 GALLONS

FOR GARBAGE GRINDER, INCREASE DISPOSAL AREA 22% & TANK CAPACITY 50%.

9/28/73

Put system in place before house - due to builder not submitting proper elevations

OTHER DRY WELL - To have 125 sq. ft. effective absorbent sidewall area per bedroom below inlet. Inlet to be 3 1/2 ft. below original grade and maximum depth permitted for dry well is 11 ft. Locate in perc holes 4 and 5 as of 5/22/73.

NOTE: ALL PIPE FROM HOUSE TO SEPTIC TANK MUST BE CAST IRON.
PERMIT VOID AFTER THREE YEARS.

NOTE: INSTALL STAND PIPE ON SEPTIC TANK AND DRY WELL.

PLANS APPROVED BY Charles B. Streaker

DATE 5/22/73

FILL SEPTIC TANK AND DISTRIBUTION BOX WITH WATER BEFORE CALLING FOR AN INSPECTION. COVER NO WORK UNTIL INSPECTED AND APPROVED.

NEITHER THE HOWARD COUNTY COMMISSIONERS NOR THE HEALTH DEPARTMENT IS RESPONSIBLE FOR THE SUCCESSFUL OPERATION OF ANY SYSTEM.

BLDG. PERMIT SIGNED AND RETURNED 11/30/74

Serial # 57245

attached garage

BLDG. PERMIT SIGNED AND RETURNED


Serial # 45747

Part 11/5/72

DATE SYSTEM APPROVED

18211

01. M.W.O. 10/10/10
28 30001

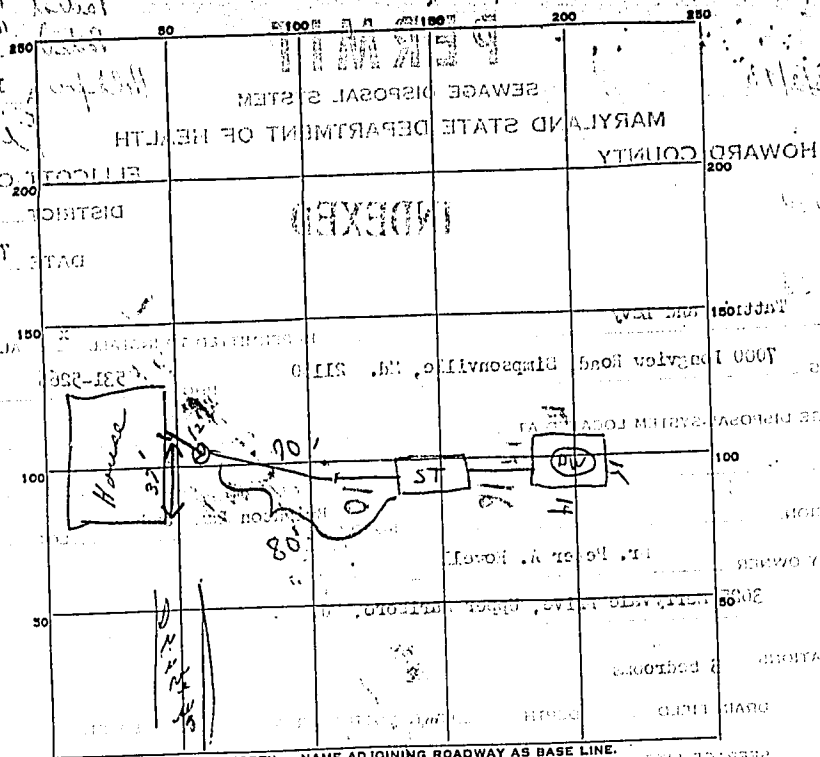

PERMIT CARD OK 0001

SEPTIC TANK, LEVEL OK CLEANOUTS OK

DISTRIBUTION BOX, LEVEL OK

TILE FIELD, DEPTH 18" - 24" TRENCH WIDTH 16"

GRAVEL DEPTH 18" TOTAL LENGTH 10'

NUMBER OF TRENCHES 1 TOTAL BOTTOM AREA 160

SEEPAGE PITS, INSIDE DIAMETER 58 FT. DEPTH BELOW INLET 7' FT.

ABSORBENT AREA 406 SQ. FT.

REMARKS: 1/2 location questionable, not able to determine
B.S. check for location Monday 3/9/3 checked area
dry well in area noted. Hold final
approval until sewer connected to house
OK to cover all system except for
pipe connection to house sewer. B.S.

DATE SYSTEM APPROVED 5/2/74 INSPECTOR C. Theaker