

11/12/82

11/12/82 Appl F.S.

P 32301

PERMIT

A 25715

SEWAGE DISPOSAL SYSTEM

MARYLAND STATE DEPARTMENT OF HEALTH*

HOWARD COUNTY

OS-384397

ELLICOTT CITY

DISTRICT 5th

INDEX

DATE 11/8/82

Robert L. Orndorff IS PERMITTED TO INSTALL X ALTER

ADDRESS 13938 Highland Road, Clarksville, Md. 21029 PHONE 596-9394

SUBDIVISION Simpson Woods ROAD 7225 Meadow Wood Way LOT 16, Sec. 2

PROPERTY OWNER Nu-Homes, Inc. / MARGARIE E. PRADA

ADDRESS 6655 H Dobbins Road
Columbia, Maryland 21045

SPECIFICATIONS 4 Bedrooms

SEPTIC TANK CAPACITY 1250 GALLONS

DRAIN FIELD _____ DEPTH _____ FEET, BOTTOM AREA _____ SQ. FT.

DEEP TRENCH _____ DEPTH _____ FEET, BOTTOM AREA _____ SQ. FT.

Dry well and Trench SEEPAGE PITS X ABSORBENT SIDE-WALL AREA 190 SQ. FT. per bedroom

INLET PIPE 4 FT. BELOW ORIGINAL GRADE. MAXIMUM DEPTH 11 FT. BELOW ORIGINAL GRADE

EFFECTIVE DEPTH AT 5 FT. BELOW ORIGINAL GRADE.

LOCATE DISPOSAL AREA 94 FT. FROM left LOT LINE AND 140 FT. FROM rear LOT LINE AS SEEN WHEN FACING LOT FROM Meadow Wood Way

Trench inlet at 4 1/2 (eff. @5'), maximum depth 11 feet and 77 feet long with absorption area of 460 sq. ft. Come off left side of dry well, run trench toward left side line. Follow contour to keep trench level. Leave 5 ft. earth buffer between trench and dry well. Call for two (2) inspection of trench - before and after gravel is installed.

PLANS APPROVED BY William W. Zepp DATE 1/9/78

COVER NO WORK UNTIL INSPECTED AND APPROVED.

NEITHER THE HOWARD COUNTY COUNCIL NOR THE HEALTH DEPARTMENT IS RESPONSIBLE FOR THE SUCCESSFUL OPERATION OF ANY SYSTEM.

NOTE: IF TRENCH IS USED CALL FOR INSPECTION BEFORE PLACING GRAVEL IN TRENCH.

NOTE: NO DRY WELL SHALL EXCEED 15 FOOT IN DIAMETER.


NOTE: ALL PIPE FROM HOUSE TO DISPOSAL AREA MUST BE CAST IRON.

PERMIT VOID AFTER THREE YEARS.

NOTE: INSTALL STAND PIPE ON SEPTIC TANK AND DRY WELL. STAND PIPES MUST BE 6 INCHES IN DIAMETER. CAST IRON, CONCRETE OR TERRA COTTA ACCEPTED.

***INSTALLER IS RESPONSIBLE FOR OBTAINING FINAL APPROVAL ON THIS PERMIT.**

BLDG. PERMIT SIGNED
AND RETURNED 9-11-97
Serial # B10107818
Hot Tub

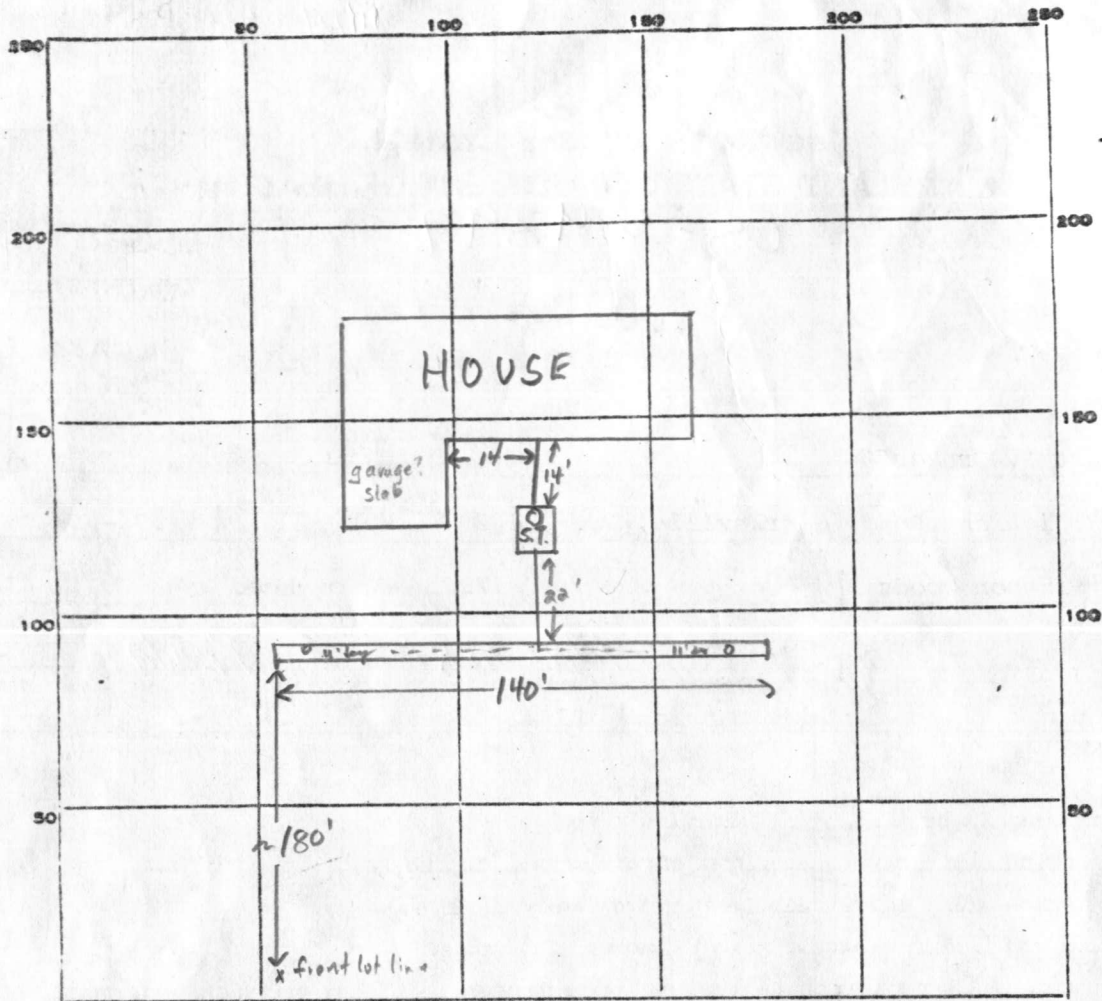

INDICATE NORTH. NAME ADJOINING ROADWAY AS BASE LINE.

Meadow Wood Way

PERMIT CARD _____

SEPTIC TANK, LEVEL at least 1500 gal.

CLEANOUTS S.T. - manhole or.

DISTRIBUTION BOX, LEVEL n.a.

TILE FIELD, DEPTH 11 FT. TRENCH WIDTH 2 FT.

GRAVEL DEPTH 6 1/2 - 7 FT. TOTAL LENGTH 140 FT.

NUMBER OF TRENCHES 1 ONE SIDE TOTAL BOTTOM AREA ±840 sq

SEEPAGE PITS, INSIDE DIAMETER _____ FT. DEPTH BELOW INLET _____ FT.

ABSORBENT AREA ±840 SQ. FT.

REMARKS 11/12/82 O.K. to connect with stand pipes @ both ends of trench to check depths on system installed on holiday 11/11/82 Spoil pile looks adequate F.S.

DATE SYSTEM APPROVED 11/12/82 INSPECTOR F. Shinn