

NA/ST 1/12/81
willamp please

approved 1/12/81
Stage
P 3/102

PERMIT

SEWAGE DISPOSAL SYSTEM

A 30800

MARYLAND STATE DEPARTMENT OF HEALTH*

HOWARD COUNTY

05-388740

ELLICOTT CITY

DISTRICT 5th.

INDEXED

DATE 1/2/81

Covey Construction

IS PERMITTED TO INSTALL ALTER

ADDRESS 1896 Montevideo Road, Jessup, Maryland 20794 PHONE 799-5144

SUBDIVISION Simpson Woods ROAD 7242 Meadow Wood Way LOT 4, Sec. 3

PROPERTY OWNER Richard C. Peters

ADDRESS 8509 Portsmouth Drive, Laurel, Maryland 20811

SPECIFICATIONS 4 bedrooms

SEPTIC TANK CAPACITY 1250 GALLONS

DRAIN FIELD DEPTH FEET, BOTTOM AREA SQ. FT.

DEEP TRENCH DEPTH FEET, BOTTOM AREA SQ. FT.

SEEPAGE PITS ABSORBENT SIDE-WALL AREA 135 SQ. FT. per bedroom

Dry Well INLET PIPE 3 FT. BELOW ORIGINAL GRADE. MAXIMUM DEPTH 10 FT. BELOW ORIGINAL GRADE

EFFECTIVE DEPTH AT 3 FT. BELOW ORIGINAL GRADE.

LOCATE DISPOSAL AREA 260 FT. FROM rear LOT LINE AND 125 FT. FROM left LOT LINE AS SEEN WHEN FACING LOT FROM Meadow Wood Way.

NOTE: OKAY TO USE TRENCH OFF DRY WELL TO MAKE UP ABSORBENT SIDEWALL AREA IN SYSTEM. LEAVE 5 FT. EARTH BUFFER BETWEEN TRENCH AND DRY WELL. TRENCH TO FOLLOW CONTOUR OF THE LAND. CALL FOR TWO INSPECTIONS - BEFORE AND AFTER STONE IS INSTALLED.

PLANS APPROVED BY Frank Skinner DATE 11/12/80

COVER NO WORK UNTIL INSPECTED AND APPROVED.

NEITHER THE HOWARD COUNTY COUNCIL NOR THE HEALTH DEPARTMENT IS RESPONSIBLE FOR THE SUCCESSFUL OPERATION OF ANY SYSTEM.

NOTE: IF TRENCH IS USED CALL FOR INSPECTION BEFORE PLACING GRAVEL IN TRENCH.

NOTE: NO DRY WELL SHALL EXCEED 15 FOOT IN DIAMETER.

NOTE: ALL PIPE FROM HOUSE TO DISPOSAL AREA MUST BE CAST IRON.


PERMIT VOID AFTER THREE YEARS.

NOTE: INSTALL STAND PIPE ON SEPTIC TANK AND DRY WELL. STAND PIPES MUST BE 6 INCHES IN DIAMETER. CAST IRON, CONCRETE OR TERRA COTTA ACCEPTED.

*INSTALLER IS RESPONSIBLE FOR OBTAINING FINAL APPROVAL ON THIS PERMIT.

A 30800

Location OK
SK
11/8/81
540

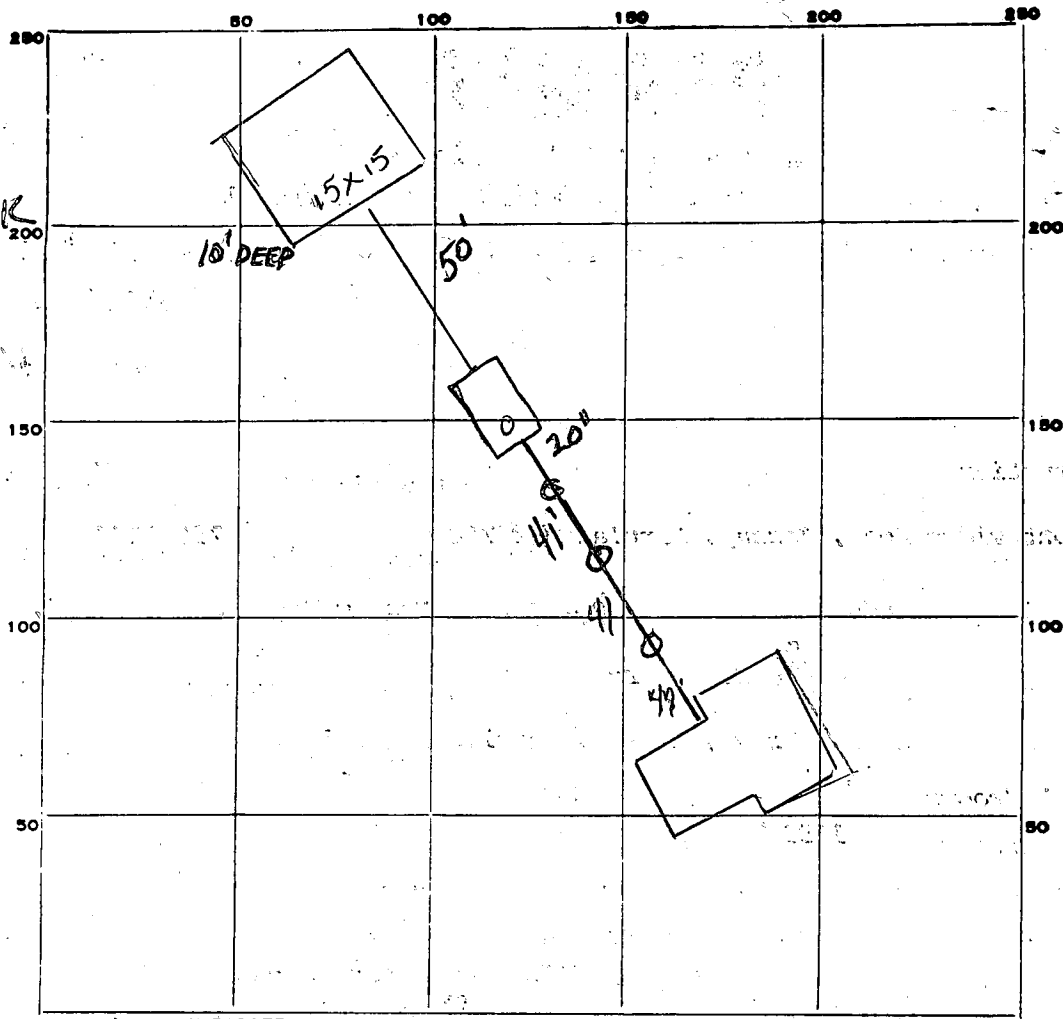

INDICATE NORTH. - NAME ADJOINING ROADWAY AS BASE LINE.

PERMIT CARD

SEPTIC TANK, LEVEL CLEANOUTS ST / DW

DISTRIBUTION BOX, LEVEL Cast iron

TILE FIELD, DEPTH 10 FT. TRENCH WIDTH 2 FT. 18

GRAVEL DEPTH 7 IN. TOTAL LENGTH 18 FT.

NUMBER OF TRENCHES 1 TOTAL BOTTOM AREA 126 126

SEEPAGE PITS, INSIDE DIAMETER 60 FT. DEPTH BELOW INLET 3 FT. 420

ABSORBENT AREA 546 SQ. FT.

REMARKS 1/9/81 OK to cover all work to Dry Well - SK/fj
1/12/81 OK to add gravel in trench, SK & fj
1/12/81 OK to cover all work - SK & fj

DATE SYSTEM APPROVED 1/12/81 INSPECTOR Stayer