

# APPLICATION

A 21989

SEWAGE DISPOSAL TESTING

P \_\_\_\_\_

STATE OF MARYLAND - DEPARTMENT OF HEALTH AND MENTAL HYGIENE

HOWARD COUNTY HEALTH DEPARTMENT  
ENVIRONMENTAL HEALTH SERVICES  
P. O. BOX 476, ELLICOTT CITY, MARYLAND 21043  
TELEPHONE: 485-5000, EXT. 356

DISTRICT 4

DATE 8/20/75

TO: THE COUNTY HEALTH OFFICER  
ELLICOTT CITY, MARYLAND

I, HEREBY, APPLY FOR THE NECESSARY TEST IN ORDER TO CONSTRUCT (OR RECONSTRUCT) A SEWAGE DISPOSAL SYSTEM.

PROPERTY OWNER Howard Associates

ADDRESS Suite 118, Teachers Bldg., Columbia, Md. PHONE 730-7733

PROPERTY LOCATION:

SUBDIVISION \_\_\_\_\_ LOT NO. 15B

ROAD AND DESCRIPTION R/W off Old Frederick Rd.

SIZE OF LOT 1.318 acres TYPE BLDG. 3 or 4

IF NOT SINGLE RESIDENCE DESCRIBE \_\_\_\_\_  
(Single Fmly. Dwllg.)

THE SYSTEM INSTALLED UNDER THIS APPLICATION IS ACCEPTABLE ONLY UNTIL PUBLIC FACILITIES BECOME AVAILABLE.

SIGNATURE OF APPLICANT /s/ Joel Abramson


APPROVED BY \_\_\_\_\_ FOR \_\_\_\_\_ DATE \_\_\_\_\_  
(KIND OF SYSTEM)

REJECTED BY \_\_\_\_\_ FOR \_\_\_\_\_ DATE \_\_\_\_\_  
(KIND OF SYSTEM)

HOLD PENDING FURTHER TESTS \_\_\_\_\_ DATE \_\_\_\_\_

REASONS FOR REJECTION OR HOLDING \_\_\_\_\_

## THIS IS NOT A PERMIT

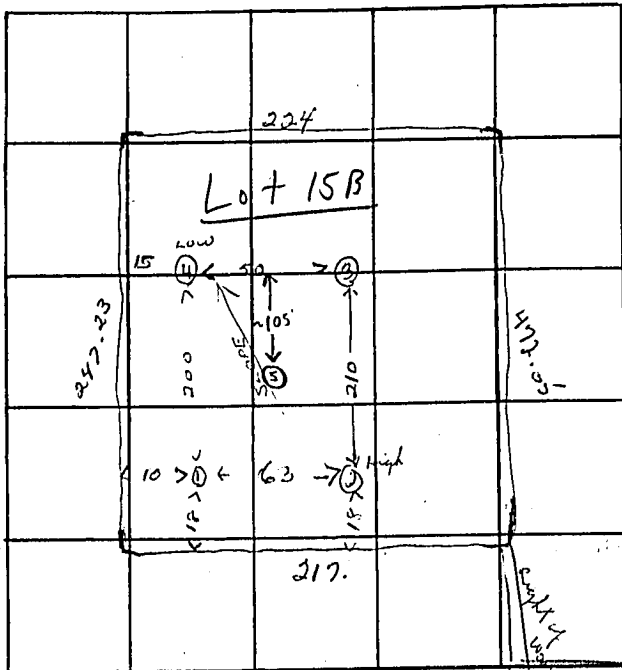

Old Orchard Rd.

DATE	TEST NO.	DEPTH	PRE-WET		TEST - 1" DROP		TIME
			START	STOP	START	STOP	
10/7/75	1	12 1/2'	11 45	11 53	11 53	12 10	12 min
	1A	4'	11 44	11 53	11 53	12 04	11 min
	2	4 1/2'	12 05	12 10	12 10	12 17	7 min
	2A	12'	12 08	12 10	12 10	12 16	6 min
	3	12'	Level hole -				
	4	5 1/2'	12 32	12 34	12 34	12 38	4 min
	4A	12 1/2'	12 32	12 38	12 38	12 48	10 min
	5	10 1/2'	Visibly silty		lean & some spots		10 min

10 min avg.  
trench 4-10'  
150# B.R.

10 min avg.  
trench 4-10'  
150# B.R.

4971.  
REMARKS: Hole #2) Hole tower has some white - appears weathered. 1,3,4, has very little white.  
TYPE OF SOIL: \_\_\_\_\_  
TESTED BY: R.T. 7.5. ALSO PRESENT: \_\_\_\_\_

The lot shown hereon complies with the minimum ownership and lot areas as required by the Maryland State Health Officer.


APPROVED: Private Water & Private Sewer

*Richard P. Browne*  
 Howard County Health Officer

TO OLD FREDERICK ROAD

Owners:  
 Howard Associates  
 Teachers Building  
 Suite 117  
 Columbia, Maryland  
 21044

10-16-78  
 38/1/8

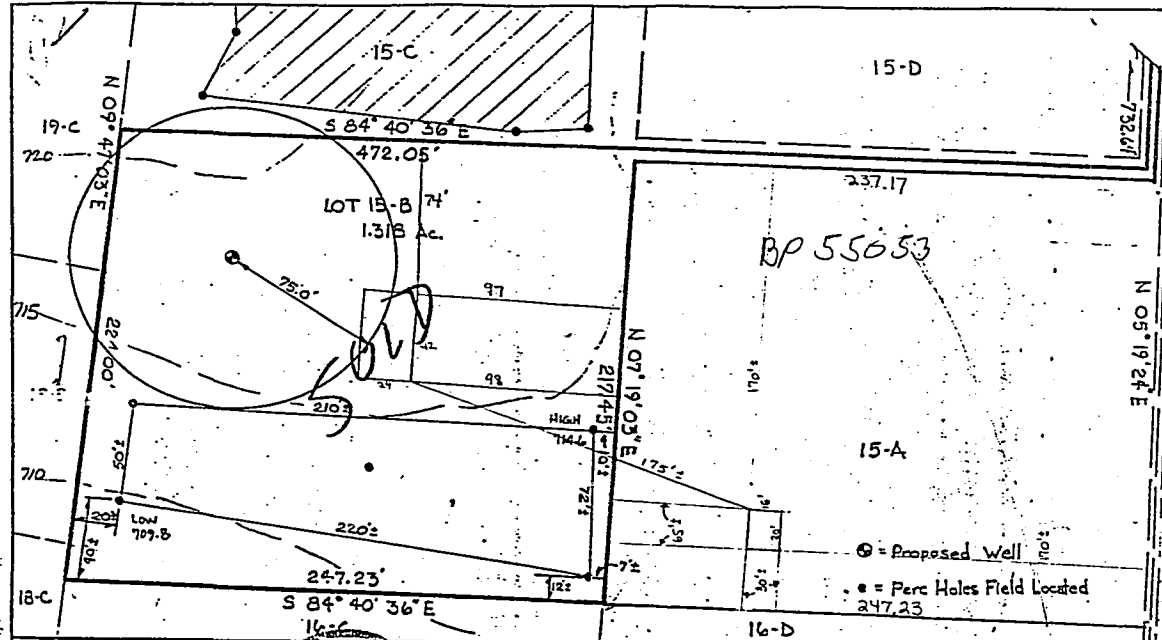

⊙ = Proposed Well  
 ● = Parc Holes Field Located



*Richard P. Browne*

REFERENCE MERIDIAN



**RICHARD P. BROWNE ASSOCIATES**  
 CONSULTING ENGINEERS, PLANNERS  
 WATFV, D.C.      COLUMBIA, MD.

MAP OF PROPERTY OF  
 HOWARD ASSOCIATES

SITUATED IN  
 4<sup>th</sup> Election District Howard County, MD.

SCALE 1" = 50'

DATE 10-16-78

PROJECT No.      W. D. No.

DRAWN *SAT* CHECKED

27-28-78

113111  
 48309  
 60109  
 BRIDGING