

81322 SEQUENCE NO. (WRA USE ONLY) STATE OF MARYLAND WELL COMPLETION REPORT FILL IN THIS FORM COMPLETELY PLEASE PRINT OR TYPE THIS REPORT MUST BE SUBMITTED WITHIN 30 DAYS AFTER WELL IS COMPLETED COUNTY NUMBER A 21989

Date/Received (WRA use only) 3-29-87 DATE WELL COMPLETED PERMIT NO. FROM "PERMIT TO DRILL WELL" 40-73-3952

OWNER Masoney Contractors Inc. last name first name STREET OR RFD 16285 Old Fenwick Road TOWN Woodbine SUBDIVISION Middle Trail SECTION LOT 15-8

WELL LOG Not required for driven wells STATE THE KIND OF FORMATIONS PENETRATED, THEIR COLOR, DEPTH, THICKNESS AND IF WATER BEARING

DESCRIPTION (Use additional sheets if needed)	FEET		Check if water bearing
	FROM	TO	
Earth	0	12	
Brown shale	12	34	
Grays shale	34	240	

SAMPLE H-9012
NITRATE 21.

WELL HAS BEEN GROUTED (Circle appropriate box) YES (Y) NO (N) TYPE OF GROUTING MATERIAL CEMENT (CM) BENTONITE CLAY (BC) NO. OF BAGS 20 NO. OF POUNDS 1200 GALLONS OF WATER 120 DEPTH OF GROUT SEAL (to nearest foot) from 0 to 2 ft. (enter 0 if from surface) (bottom ft.)

CASING RECORD Casing types (insert appropriate code below) (ST) STEEL (PL) PLASTIC (CO) CONCRETE (OT) OTHER MAIN CASING TYPE (S-1) Nominal diameter top/main casing (nearest inch) 6 Total depth of main casing (nearest foot) 28

OTHER CASING (if used) diameter inch depth (feet) from to


SCREEN RECORD screen type or openhole (insert appropriate code below) (ST) STEEL (BR) BRASS (HO) OPEN HOLE (PL) PLASTIC (OT) OTHER

DEPTH (nearest ft.) 40 38 240

PUMPING TEST HOURS PUMPED (nearest hour) 6 PUMPING RATE (gal. per min. to nearest gal.) 2 METHOD USED TO MEASURE PUMPING RATE SUB WATER LEVEL (distance from land surface) BEFORE PUMPING 33 WHEN PUMPING 109 TYPE OF PUMP USED (for test) (A) air (P) piston (T) turbine (C) centrifugal (R) rotary (O) other (describe below) (J) jet (S) submersible

PUMP INSTALLED YES (Y) NO (N) DRILLER WILL INSTALL PUMP (CIRCLE APPROPRIATE BOX) IF DRILLER INSTALLS PUMP, THIS SECTION MUST BE COMPLETED FOR ALL WELLS EXCEPT HOME USE TYPE OF PUMP (WRITE APPROPRIATE LETTER IN BOX - SEE ABOVE: (A, C, J, P, R, S, T, O) CAPACITY: GALLONS PER MINUTE (to nearest gallon) PUMP HORSE POWER PUMP COLUMN LENGTH (nearest ft.)

CASING HEIGHT (circle appropriate box and enter casing height) (+) above LAND SURFACE (-) below (nearest foot) 2

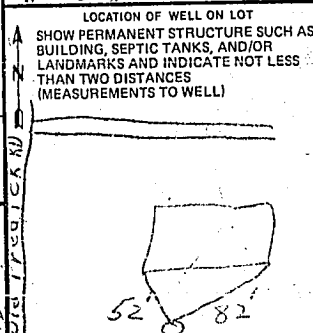

CIRCLE APPROPRIATE BOX (A) A WELL WAS ABANDONED AND SEALED WHEN THIS WELL WAS COMPLETED (E) ELECTRIC LOG OBTAINED (P) TEST WELL CONVERTED TO PRODUCTION WELL

I HEREBY CERTIFY THAT I HAVE COMPLIED WITH ALL CONDITIONS STATED ON THE ABOVE-CAPTIONED "PERMIT TO DRILL WELL", AND THAT INFORMATION CONTAINED IN THIS REPORT IS TRUE, ACCURATE, AND COMPLETE TO THE BEST OF MY KNOWLEDGE, INFORMATION AND BELIEF.

DRILLER'S IDENT. NO. 88 DRILLER'S SIGNATURE (MUST MATCH SIGNATURE ON APPLICATION) SITE SUPERVISOR (sign of driller or journeyman responsible for sitework if different from permittee)

SLOT SIZE DIAMETER OF SCREEN (NEAREST INCH) GRAVEL PACK IF WELL DRILLED WAS FLOWING WELL (CIRCLE BOX) (F)

WRA USE ONLY (NOT TO BE FILLED IN BY DRILLER) TELESCOPE CASING LOG INDICATOR OTHER DATA

HEALTH

ABANDONED ???

8132 SEQUENCE NO. (WRA USE ONLY) STATE OF MARYLAND WELL COMPLETION REPORT THIS REPORT MUST BE SUBMITTED WITHIN 30 DAYS AFTER WELL IS COMPLETED
 COUNTY NUMBER A 21984
 PERMIT NO. FROM "PERMIT TO DRILL WELL" 40-15-0152

Date Received: 3-29-81 WRA use only DATE WELL COMPLETED: [] [] [] [] [] [] [] [] [] []
 Depth of Well: 240 (TO NEAREST FOOT)

OWNER: Massey Contractors Inc. last name first name
 STREET OR RFD: 11085 Old Church Road TOWN: Woodbury
 SUBDIVISION: Middle T SECTION: LOT: 15-B

WELL LOG (Not required for driven wells)

STATE THE KIND OF FORMATIONS PENETRATED, THEIR COLOR, DEPTH, THICKNESS AND IF WATER BEARING

DESCRIPTION (Use additional sheets if needed)	FEET		Check if water bearing
	FROM	TO	
Earth	0	12	
Brown shale	12	34	
gray shale	34	240	

SAMPLE H-9012
NITRATE 21

GROUTING RECORD

WELL HAS BEEN GROUTED YES NO

TYPE OF GROUTING MATERIAL: CEMENT BENTONITE CLAY

NO. OF BAGS: 20 NO. OF POUNDS: 1200
 GALLONS OF WATER: 120
 DEPTH OF GROUT SEAL (to nearest foot) from 0 to 26

CASING RECORD

MAIN CASING TYPE: STEEL CONCRETE PLASTIC OTHER

Nominal diameter top/main casing (nearest inch): 6
 Total depth of main casing (nearest foot): 38

OTHER CASING (if used) diameter inch depth feet from to

EACH CASING

SCREEN RECORD

screen type or open hole: STEEL BRASS OPEN HOLE PLASTIC OTHER

DEPTH (nearest ft.): 38 240

EACH SCREEN

SLOT SIZE

DIAMETER OF SCREEN (NEAREST INCH) from to

PUMPING TEST

HOURS PUMPED (nearest hour): 6
 PUMPING RATE (gal. per min. to nearest gal.): 2
 METHOD USED TO MEASURE PUMPING RATE: JAB
 WATER LEVEL (distance from land surface):
 BEFORE PUMPING: 33
 WHEN PUMPING: 109
 TYPE OF PUMP USED (for test):
 submersible

PUMP INSTALLED

DRILLER WILL INSTALL PUMP YES NO

IF DRILLER INSTALLS PUMP, THIS SECTION MUST BE COMPLETED FOR ALL WELLS EXCEPT HOME USE

TYPE OF PUMP (WRITE APPROPRIATE LETTER IN BOX - SEE ABOVE: (A, C, J, P, R, S, T, O))

CAPACITY: GALLONS PER MINUTE (to nearest gallon)

PUMP HORSE POWER

PUMP COLUMN LENGTH (nearest ft.)

CASING HEIGHT (circle appropriate box and enter casing height)

+ above LAND SURFACE
 - below (nearest foot)

LOCATION OF WELL ON LOT

SHOW PERMANENT STRUCTURE SUCH AS BUILDING, SEPTIC TANKS, AND/OR LANDMARKS AND INDICATE NOT LESS THAN TWO DISTANCES (MEASUREMENTS TO WELL)

CIRCLE APPROPRIATE BOX

A WELL WAS ABANDONED AND SEALED WHEN THIS WELL WAS COMPLETED

E ELECTRIC LOG OBTAINED

P TEST WELL CONVERTED TO PRODUCTION WELL

I HEREBY CERTIFY THAT I HAVE COMPLIED WITH ALL CONDITIONS STATED ON THE ABOVE-CAPTIONED "PERMIT TO DRILL WELL", AND THAT INFORMATION CONTAINED IN THIS REPORT IS TRUE, ACCURATE, AND COMPLETE TO THE BEST OF MY KNOWLEDGE, INFORMATION AND BELIEF.

DRILLER'S IDENT NO. 111

DRILLER'S SIGNATURE: [Signature]

MUST MATCH SIGNATURE ON APPLICATION

STATE SUPERVISOR sign of driller or journeyman responsible for sitework if different from permittee

GRAVEL PACK

IF WELL DRILLED WAS FLOWING WELL CIRCLE BOX

WRA USE ONLY (NOT TO BE FILLED IN BY DRILLER)

T (E.R.O.S.) WQ

TELESCOPE CASING LOG INDICATOR OTHER DATA