
WATER WELL ABANDONMENT-SEALING REPORT FORM

SUBMIT COPIES OF COMPLETED FORM TO:

- * COUNTY ENVIRONMENTAL AGENCY (contact MDE, WMA if address needed)
- * WELL OWNER
- * MDE, WATER MANAGEMENT ADMINISTRATION, WELL PROGRAM

OK
4/24/16 SC

DATE WELL ABANDONED: 2/3/16 (month/day/year)

* PERMIT NUMBER OF ABANDONED WELL (if any) _____

* PERMIT NUMBER OF REPLACEMENT WELL: _____

* PERSON ABANDONING WELL: Robert Copsy

WELL DRILLER'S LICENSE NUMBER: 161


CIRCLE: MWD / MSD / MGD

* OWNER'S NAME: John Neighoff

* WELL LOCATION:

SITE LOCATION MAP

COUNTY: HOWARD COUNTY
NEAREST TOWN: ELLICOTT CITY
TAX MAP 0037 BLOCK _____ PARCEL 0530
SUBDIVISION: 0000
SECTION: _____ LOT: _____
STREET ADDRESS: 6247 WOODCREST DR.
ELLICOTT CITY MD 21043

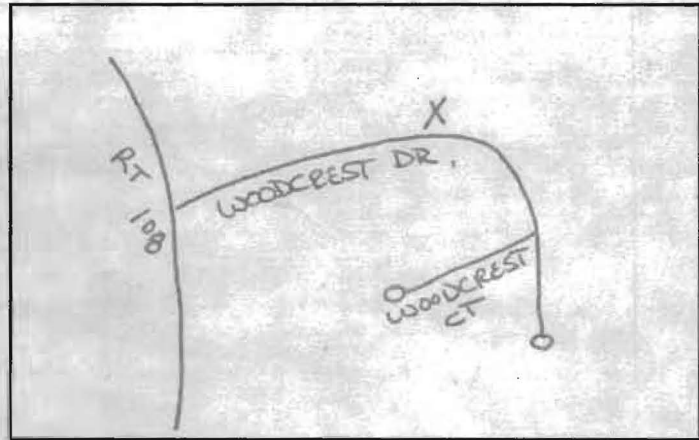

LATITUDE 3 9 . 1 1 5 996 N

LONGITUDE 7 6 . 4 7 3 4 1 7

* TYPE OF WELL BEING ABANDONED:

LOG OF SEALING MATERIAL

- DRILLED
- BORED
- OTHER (specify) _____
- JETTED
- HAND DUG

| MATERIAL | FEET | |
|-------------------------|------|----|
| | FROM | TO |
| Clean gravel | 23 | 5' |
| CONCRETE | 5 | 2' |
| clean fill | 2 | 0 |
| VOLUME OF MATERIAL USED | | |
| | | |

* USE CODE:

- DOMESTIC
- IRRIGATION
- TEST/OBSERVATION
- MUNICIPAL/PUBLIC
- INDUSTRIAL
- GEOTHERMAL

* TYPE OF CASING:

- STEEL
- CONCRETE
- PLASTIC
- OTHER (specify) _____

SIZE OF CASING: 3" INCHES IN DIAMETER

DEPTH OF WELL: 23' FEET DEEP

WAS ANY CASING REMOVED? YES NO

If yes, length removed, in feet: 2

WAS CASING RIPPED OR PERFORATED? YES NO

SIGNATURE-MASTER WELL DRILLER OR SUPERVISING SANITARIAN LICENSE#
Robert Copsy 161

MWD / MSD / MGS

CIRCLE ONE

2/3/16

DATE

COUNTY