

SEQUENCE NO. (MDE USE ONLY) : 9526  
(THIS NUMBER IS TO BE PUNCHED IN COLS. 3-6 ON ALL CARDS)

STATE OF MARYLAND PERMIT TO DRILL WELL please print or type

STATE PERMIT NUMBER

HO-94-1148  
fill in this form completely

Date Received (APA)

5/17/97

OWNER INFORMATION

Owner: SDC  
Last Name: P.O. Box 417  
Street or RFD: Elliott City Md. 21041  
Town: State: Zip:


LOCATION OF WELL

Howard  
COUNTY  
Rego Property  
SUBDIVISION  
SECTION 44 46 LOT C 48 50  
Cooksville  
NEAREST TOWN  
MILES FROM TOWN (enter 0 if in town) 1 MI

DRILLER INFORMATION

Driller's Name: Joseph R. Mayne MS D 024  
License No.:  
Firm Name: Joseph R. Mayne Well Drilling  
Address: 5512 Ridge Rd. Mt. Airy Md. 21771  
Signature: Joseph R. Mayne Date: 5/6/97

DIRECTION OF WELL FROM TOWN (CIRCLE BOX)

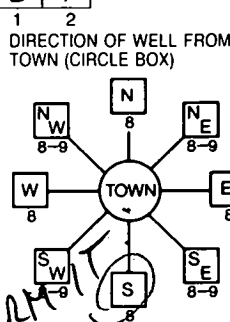

Meadowtree Ct  
NEAR WHAT ROAD  
ON WHICH SIDE OF ROAD (CIRCLE APPROPRIATE BOX)  
NORTH  
WEST EAST  
SOUTH  
DISTANCE FROM ROAD 70 FT  
ENTER FT OR MI  
TAX MAP: BLK: PARCEL:

WELL INFORMATION  
APPROX. PUMPING RATE (GAL. PER MIN.) 5  
AVERAGE DAILY QUANTITY NEEDED (GAL. PER DAY) 500

- USE FOR WATER (CIRCLE APPROPRIATE BOX)  
 HOME (SINGLE OR DOUBLE HOUSEHOLD UNIT ONLY)  
 FARMING (LIVESTOCK WATERING & AGRICULTURAL IRRIGATION)  
 INDUSTRIAL, COMMERCIAL, STATE AND FEDERAL GOV. OTHER (REQUIRES APPROPRIATION PERMIT)  
 PUBLIC OR PRIVATE WATER COMPANY (REQUIRES APPROPRIATION PERMIT AND STATE APPROVAL)  
 TEST, OBSERVATION, MONITORING (MAY REQUIRE APPROPRIATION PERMIT)

EXPIRED TAG & PERMIT DESTROYED & RETURNED

NOT TO BE FILLED IN BY DRILLER HEALTH DEPARTMENT APPROVAL  
Howard Co A 50368  
COUNTY NAME COUNTY NO.  
STATE SIGNATURE INSERT S  
DATE ISSUED 05/15/97 A McMillan 5/15/98  
43 MM DD YY 48 CO SIGNATURE EXP. DATE  
NORTH GRID 540 000 EAST GRID 792 000  
50 55 57 63

APPROXIMATE DEPTH OF WELL 300 FEET  
APPROXIMATE DIAMETER OF WELL 6 INCH NEAREST INCH

METHOD OF DRILLING (circle one)  
BORED (or Augered) - JETTED Jetted & DRIVEN  
AIR-ROTary AIR-PERcussion ROTary (Hydraulic Rotary)  
CABLE REVerse-ROTary DRive-POINT  
other

REPLACEMENT OR DEEPEINED WELLS (CIRCLE APPROPRIATE BOX)  
 THIS WELL WILL NOT REPLACE AN EXISTING WELL  
 THIS WELL WILL REPLACE A WELL THAT WILL BE ABANDONED AND SEALED  
 THIS WELL WILL REPLACE A WELL THAT WILL BE USED AS A STANDBY-CONTACT LOCAL APPROVING AUTHORITY FOR POLICY ON STANDBY WELLS  
 THIS WELL WILL DEEPEIN AN EXISTING WELL  
PERMIT NUMBER OF WELL TO BE REPLACED OR DEEPEINED (IF AVAILABLE) 41

Not to be filled in by driller (MDE OR COUNTY USE ONLY)  
APPROP. PERMIT NUMBER 54 G A P 63  
FORCE AM WRITE INITIALS IN BOX PERMIT No. HO-94-1148  
67 68 70 71 72 73 74 75 76 77 78 79

SPECIAL CONDITIONS  
NOTE - APPROVING AUTHORITIES SHOULD USE SEPARATE SHEET IF NEEDED -

SHOW MAJOR FEATURES OF BOX & LOCATE WELL WITH AN X  
SOURCES OF DRILLING WATER  
1. Well  
2.  
3.  
WRITE THE BOX NUMBER FROM THE MAP HERE  
E 792  
N 540  
000  
000

