

7/27/60
9:30

APPLICATION

A 22732
#2781

SEWAGE DISPOSAL TESTING

MARYLAND STATE DEPARTMENT OF HEALTH

HOWARD COUNTY 750 Gallon Tank

ELLICOTT CITY

located 50 ft or more from the well with caution sewer lines anywhere within a 50 ft radius of the well

DISTRICT 5th
DATE 7/23/60

Dry Well - 300 sq ft sidewalk area below the well located no closer than 75 ft from the well near the

TO: THE COUNTY HEALTH OFFICER
ELLICOTT CITY, MARYLAND

I, HEREBY, APPLY FOR THE NECESSARY TESTS IN ORDER TO CONSTRUCT (OR RECONSTRUCT) A SEWAGE DISPOSAL SYSTEM. area in which the percolation test was made

PROPERTY OWNER John W. Johnson
ADDRESS Highland, Md. PHONE at. 6-2768

PROPERTY LOCATION:

SUBDIVISION _____ LOT NO. _____

ROAD AND DESCRIPTION Mink Hollow Rd. - 1st. house on road or right hand side (name on map)

OCCUPANT Same PHONE _____

PERSON TO CONSTRUCT SYSTEM Cissel

ADDRESS _____ PHONE _____

SIZE OF LOT 1A TYPE BLDG. 2 NUMBER OF BEDROOMS _____

IF NOT SINGLE RESIDENCE DESCRIBE _____

SIGNATURE OF APPLICANT John W. Johnson

APPROVED BY Raymond Hodges FOR Dry Well DATE 8/2/60


REJECTED BY _____ FOR _____ DATE _____

HOLD PENDING FURTHER TESTS _____ DATE _____

REASONS FOR REJECTION OR HOLDING _____

THIS IS NOT A PERMIT

MINK HOLLOW RD

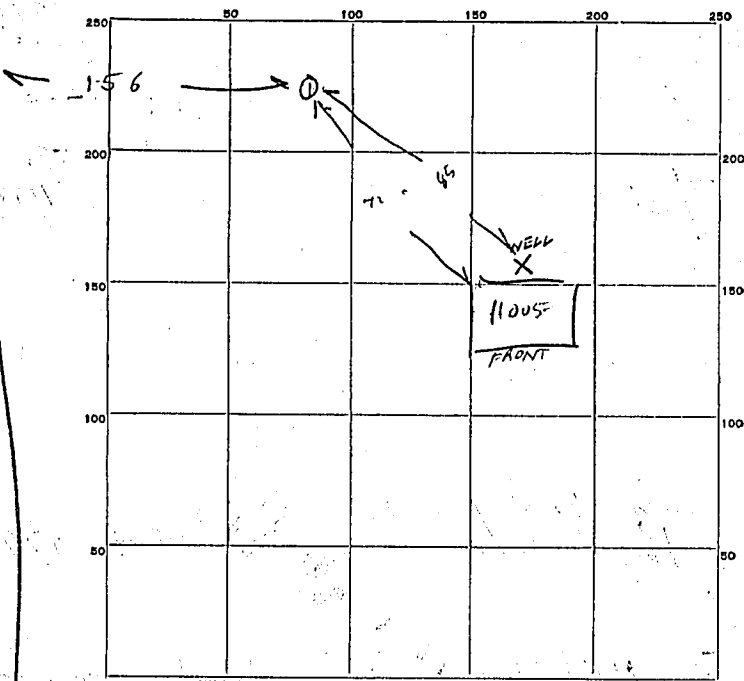

INDICATE NORTH. - NAME ADJOINING ROADWAY AS BASE LINE.

DATE	TEST NO.	DEPTH	PRE-WET		TEST - 1" DROP		TIME
			START	STOP	START	STOP	
2/2/60	1	9	256	300	300	308	8 min

SOIL AUGER FINDING Miss Lead Depth

TESTED BY Raymond Hodges

REMARKS _____

ALSO PRESENT Assembly LOT NO. _____