

Dr. out - 8/19/60

# PERMIT

SEWAGE DISPOSAL SYSTEM

MARYLAND STATE DEPARTMENT OF HEALTH

HOWARD COUNTY

INDEXED

P 02781  
A 02732

ELLCOTT CITY  
DISTRICT 5  
DATE 8/4/60

C. Claude Cissel IS PERMITTED TO INSTALL  ALTER  
ADDRESS Highland PHONE Atlas 6-3326

A SEWAGE DISPOSAL SYSTEM LOCATED AT  
Mink Hollow Rd. 1st house on road on right hand side (name on mail box)

SUBDIVISION \_\_\_\_\_ ROAD \_\_\_\_\_ LOT \_\_\_\_\_

PROPERTY OWNER Johnson, John W.

ADDRESS Highland

SPECIFICATIONS

DRAIN FIELD \_\_\_\_\_ DEPTH \_\_\_\_\_ FEET, BOTTOM AREA \_\_\_\_\_ SQ. FT.

SEEPAGE PITS  ABSORBENT SIDE-WALL AREA 300 SQ. FT. below the inlet located  
no closer than 75 ft. from the well near the area in which the percolation  
SEPTIC TANK CAPACITY 750 GALLONS test was made.

FOR GARBAGE GRINDER, INCREASE DISPOSAL AREA 22% & TANK CAPACITY 50%.


OTHER Locate septic tank - 50 ft. or more from the well with cast iron sewer  
lines anywhere within a 50 ft. radius of the well.

PLANS APPROVED BY Raymond Hodgos DATE 8/2/60

FILL SEPTIC TANK AND DISTRIBUTION BOX WITH WATER BEFORE CALLING FOR AN INSPECTION. COVER NO WORK  
UNTIL INSPECTED AND APPROVED.

NEITHER THE HOWARD COUNTY COMMISSIONERS NOR THE HEALTH DEPARTMENT IS RESPONSIBLE FOR THE  
SUCCESSFUL OPERATION OF ANY SYSTEM.

A 02732

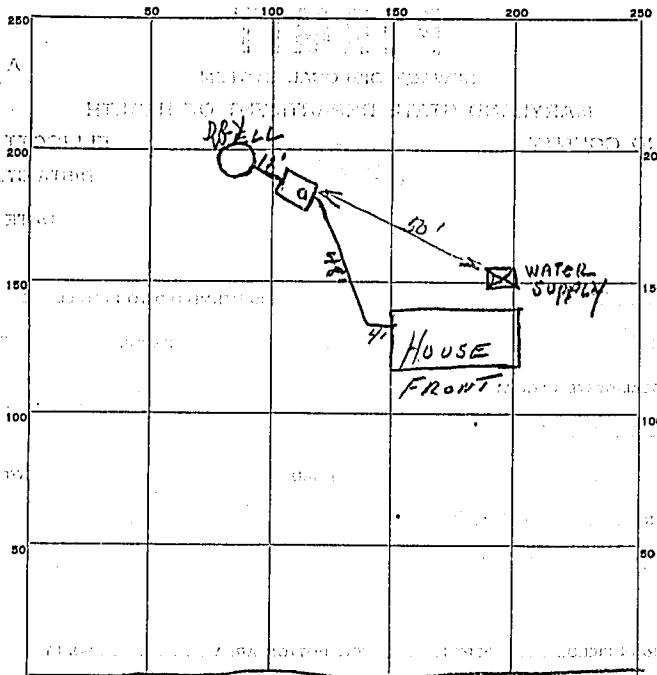

INDICATE NORTH. NAME ADJOINING ROADWAY AS BASE LINE.

MINK HOLLOW ROAD

3.14  
 10  
 31.40  
 10  
 314.00  
 15  
 329

PERMIT CARD yes

SEPTIC TANK, LEVEL DK 750

CLEANOUTS 1 - stand pipe

DISTRIBUTION BOX, LEVEL None

TILE FIELD, DEPTH \_\_\_\_\_ FT. TRENCH WIDTH \_\_\_\_\_ FT.

GRAVEL DEPTH \_\_\_\_\_ IN. TOTAL LENGTH \_\_\_\_\_ FT.

NUMBER OF TRENCHES \_\_\_\_\_ TOTAL BOTTOM AREA \_\_\_\_\_

SEEPAGE PITS, INSIDE DIAMETER 10 FT. DEPTH BELOW INLET 10.5 FT.

ABSORBENT AREA 329 SQ. FT.

REMARKS \_\_\_\_\_

DATE SYSTEM APPROVED 8-19-60

INSPECTOR J. H. Essington