

APPLICATION

SEWAGE DISPOSAL TESTING

MARYLAND STATE DEPARTMENT OF HEALTH

HOWARD COUNTY

ELLICOTT CITY

DISTRICT 5

DATE 7/13/72

A 17206

P _____

*4-12' holes (F)
Preliminary*

*9/27/72
9:30*

TO: THE COUNTY HEALTH OFFICER
ELLICOTT CITY, MARYLAND

I, HEREBY, APPLY FOR THE NECESSARY TESTS IN ORDER TO CONSTRUCT (OR RECONSTRUCT) A SEWAGE DISPOSAL SYSTEM.

PROPERTY OWNER Della L. Oakley

ADDRESS Route #2, Box 329, Finksburg, Md. 21048 PHONE 833-6540

PROPERTY LOCATION:

SUBDIVISION _____ LOT NO. _____

ROAD AND DESCRIPTION Mink Hollow Rd. - South of Highland Rd. - right hand side -
1/4 mile - across from entrance to Cissel Farm

OCCUPANT _____ PHONE _____

PERSON TO CONSTRUCT SYSTEM _____

ADDRESS _____ PHONE _____

SIZE OF LOT 1.482 acres TYPE BLDG. 3 or 4 bedroom
NUMBER OF BEDROOMS

IF NOT SINGLE RESIDENCE DESCRIBE _____

SIGNATURE OF APPLICANT /s/ Della L. Oakley


APPROVED BY _____ FOR _____ DATE _____
(KIND OF SYSTEM)

REJECTED BY _____ FOR _____ DATE _____
(KIND OF SYSTEM)

HOLD PENDING FURTHER TESTS _____ DATE _____

REASONS FOR REJECTION OR HOLDING 7/27/72 Hold ↔ Mr Wine to check + discuss with Oakley (also wants to test later in winter holes possibly).

THIS IS NOT A PERMIT

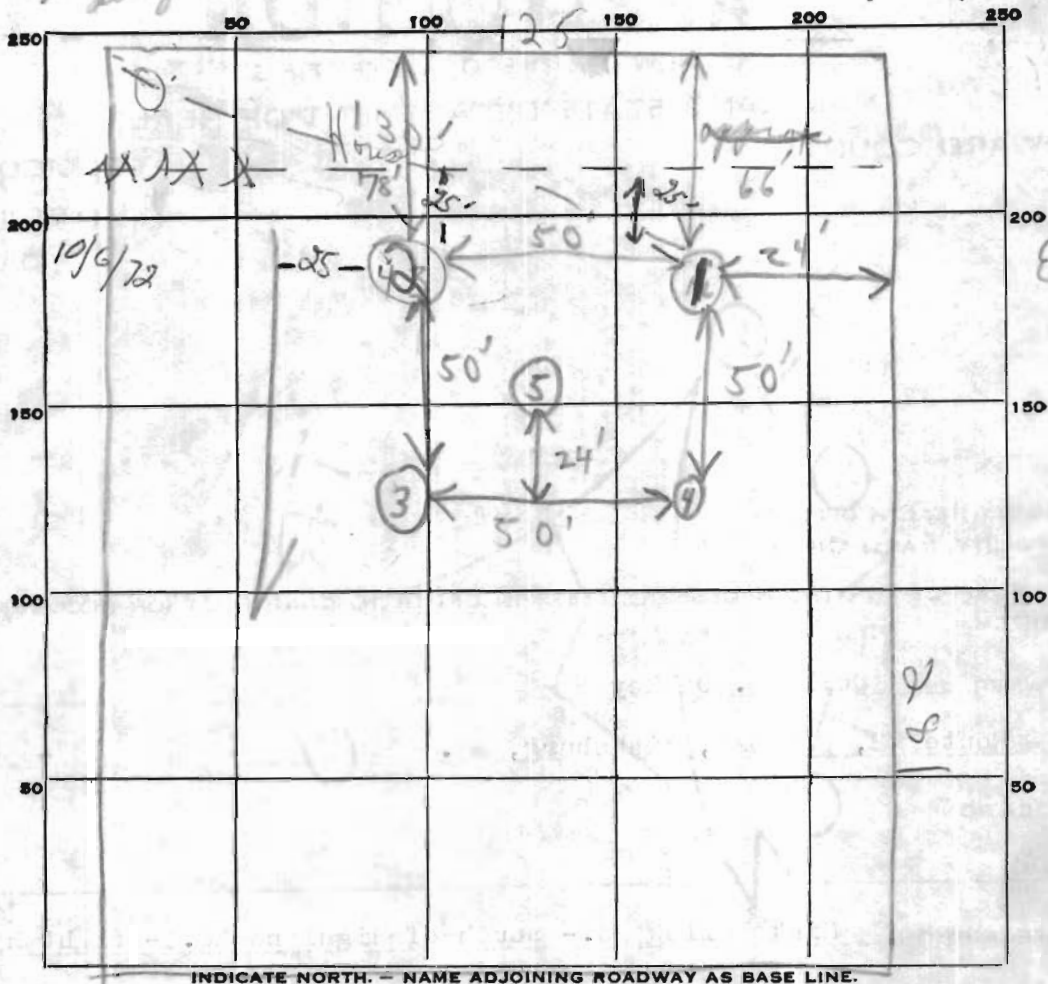

DATE	TEST NO.	DEPTH	PRE-WET		TEST - 1" DROP		TIME
			START	STOP	START	STOP	
9/27/72	1	4'	10:16	10:18	10:18	10:20	2 min
	2	4'	10:17	10:19	10:19	10:21	2 min
	3	4'	10:25	10:27	10:27	10:30	3 min
	4	4'	10:31	10:41	10:41	10:59	18 min
	5	9'	Hit water				
			Bad soil from 4-7				
			Ran test after discussing with ^{Mr. Oakley} Win on phone Ran test - Hold for check with Mr. Win				

SOIL AUGER FINDING

TESTED BY BS

REMARKS

9/27 No test discussed
 situation water at 11' in
 2 highest holes with Mr. Win

FILE

Seaman

DATE REPORTED

6/29/72

PROPERTY OWNER

P.O. ADDRESS

TELEPHONE

DIRECTIONS TO PROPERTY

INFORMANT

Mr Della Oakley 795 3/72

~~Box~~ R 2 Box 329 Fairburg

210-48 is asking about her

property on West Hollow Rd

(in name of Della Oakley at this

time but at time of purchase

CONDITION FOUND

in the name of Francis Smith

she just purchased year for Mrs

Oakley & lost OK to now house

on lot. Mrs Oakley

has a total 2.5 ac now

she wants to divide it in

half & wants to know if

ACTION TAKEN


any more per test are

needed. He talked to someone

here but does not know who

Her husband bought the house Dept. requested
another per.

FINAL DISPOSITION

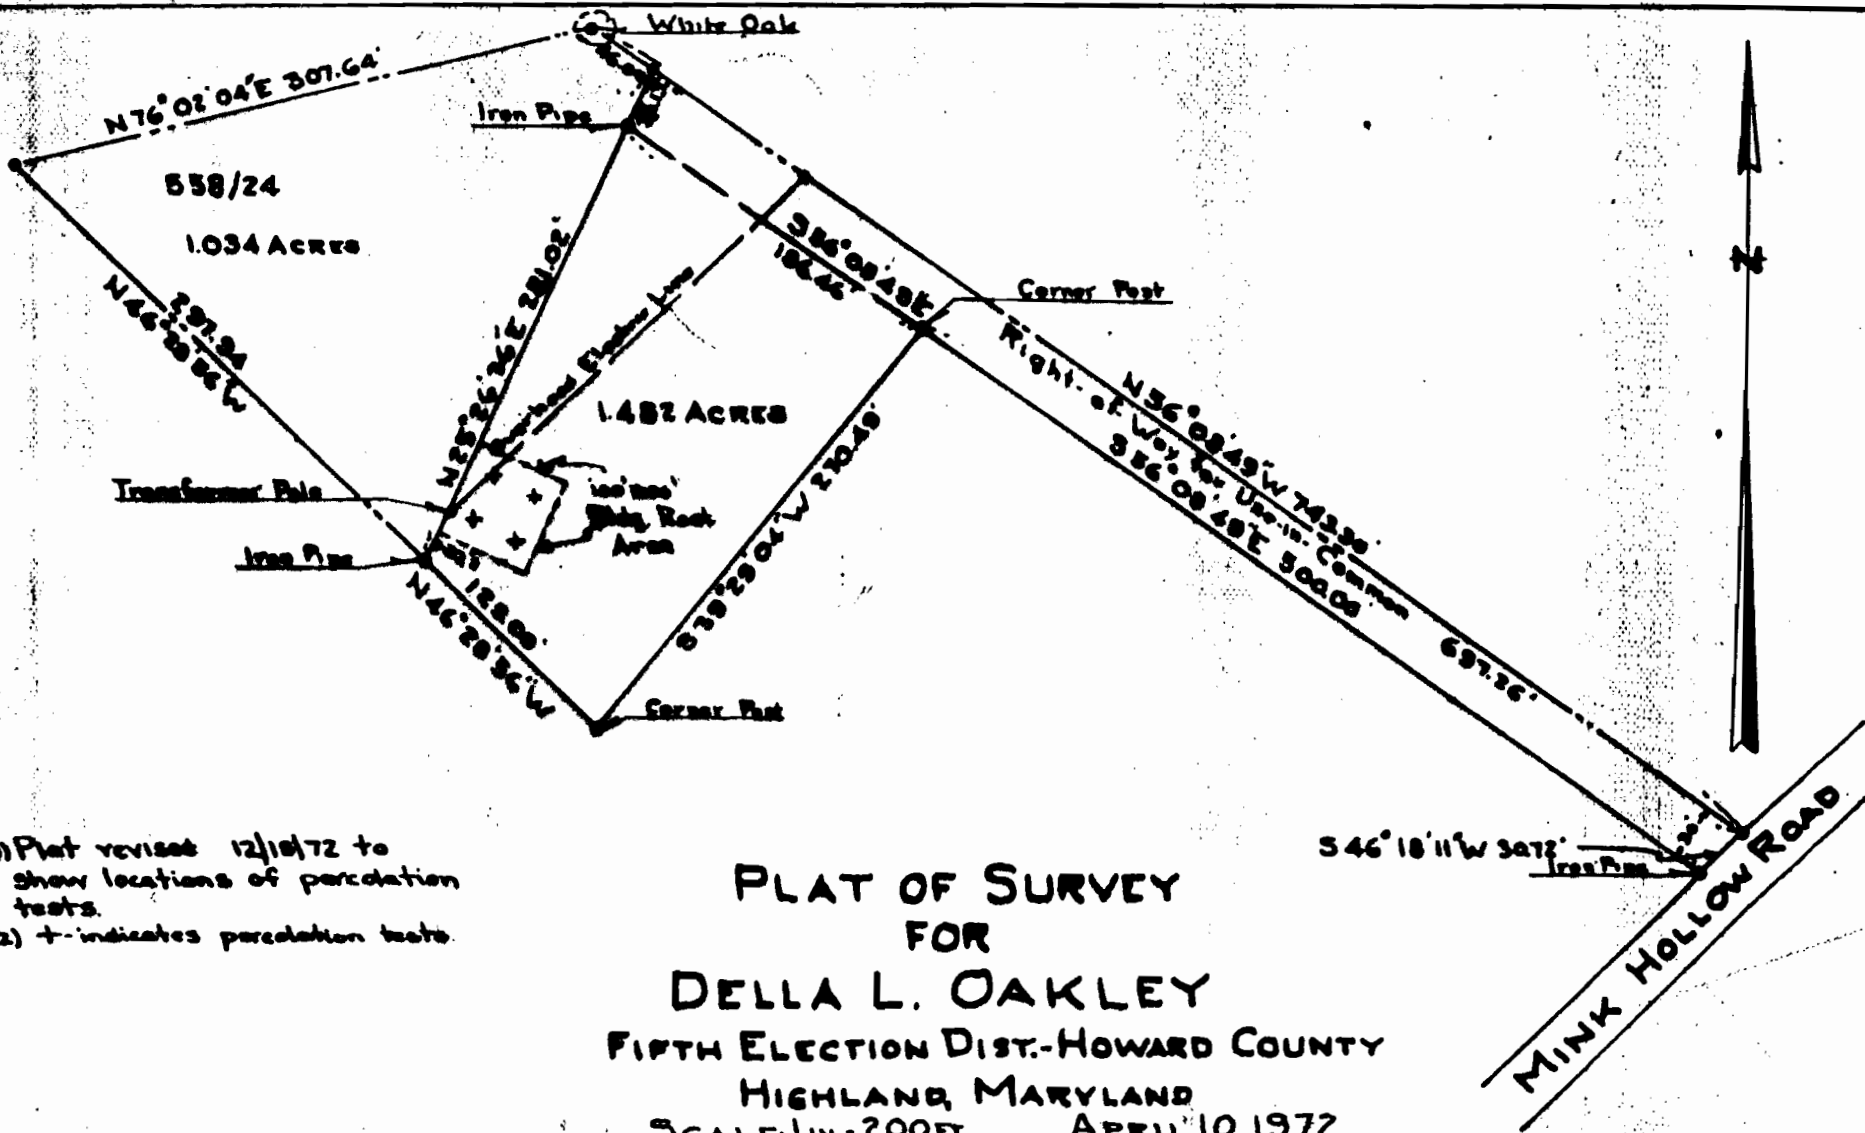

Notes: 1) Plat revised 12/18/72 to show locations of percolation tests.
 2) + indicates percolation tests.

**PLAT OF SURVEY
 FOR
 DELLA L. OAKLEY
 FIFTH ELECTION DIST.-HOWARD COUNTY
 HIGHLAND, MARYLAND
 SCALE: 1 IN. = 200 FT. APRIL 10, 1972.**

Note: The lot shown herein complies with the minimum ownership and lot area as required by the Maryland State Health Department Regulations.


Approved: Private Water Sewerage

Claude M. Skinner, Jr.
 Claude M. Skinner, Jr.
 Reg. Professional Engineer &
 Land Surveyor No. 2237



Howard County Health Officer

Date

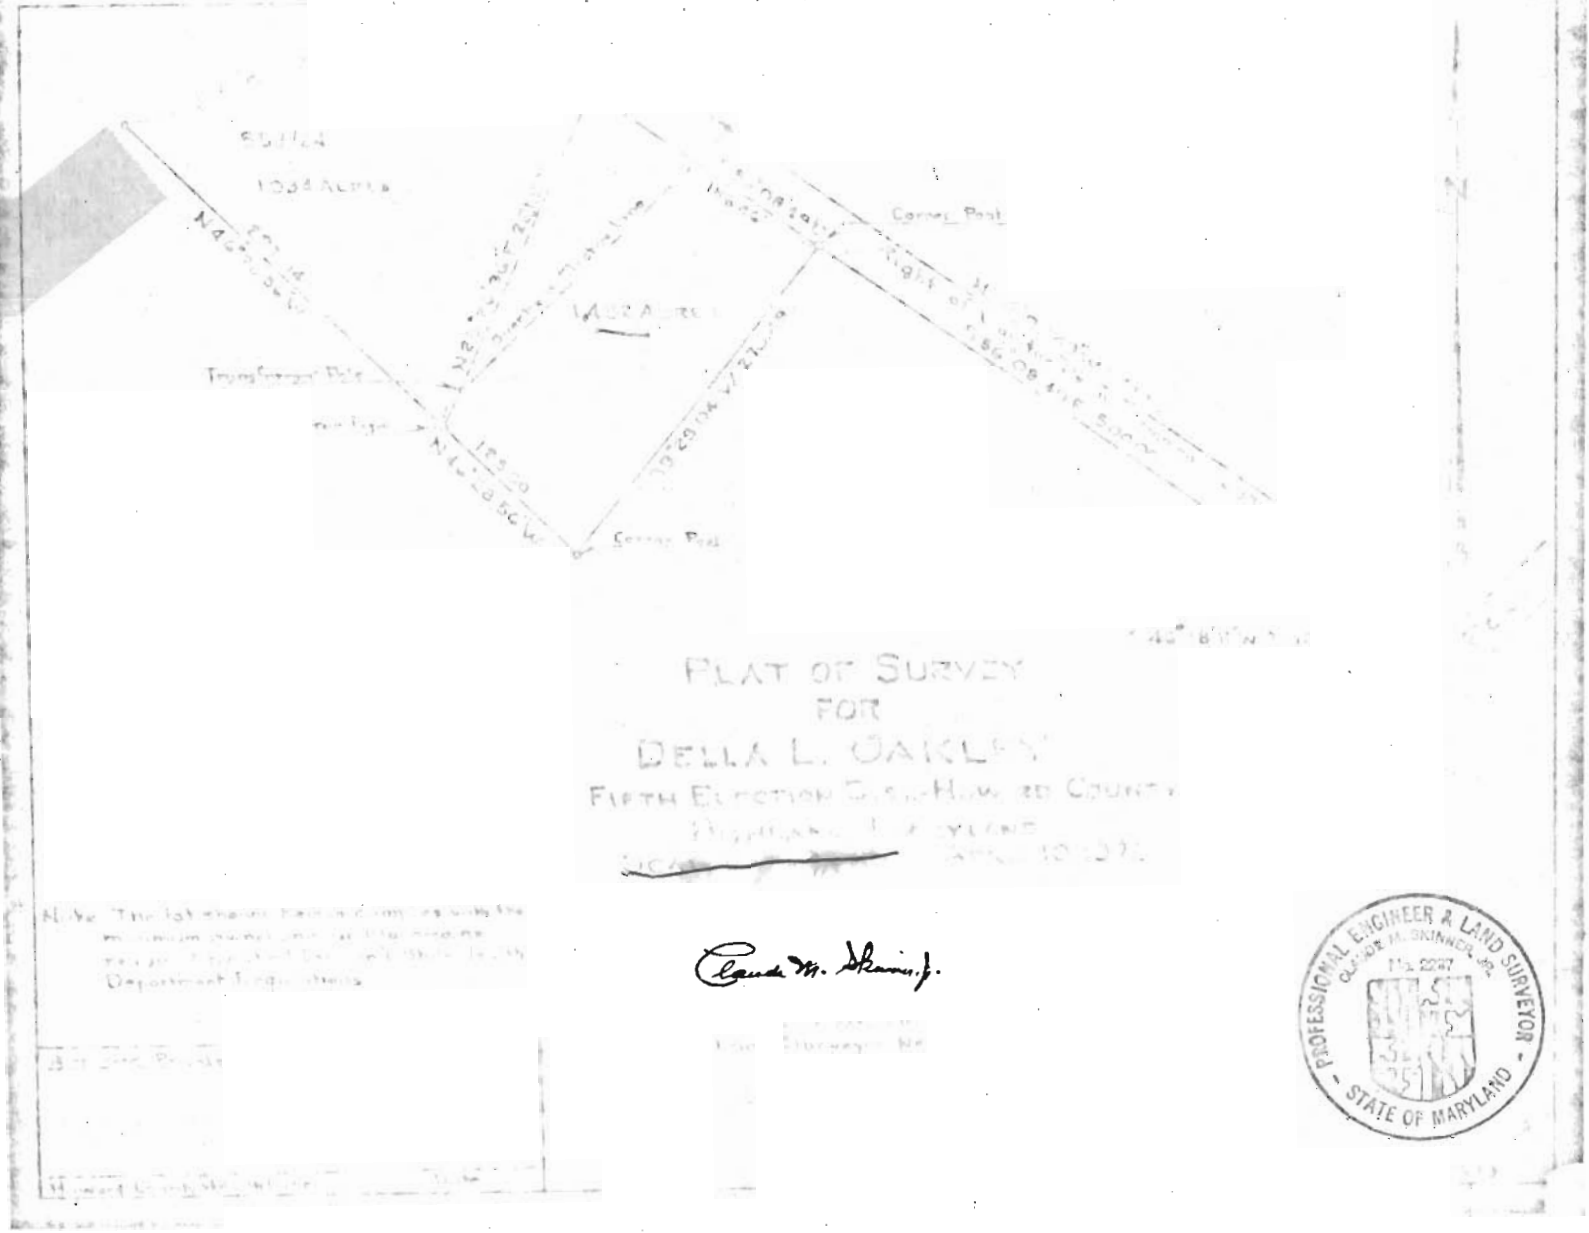

PLAT OF SURVEY
 FOR
 DELLA L. OAKLEY
 FIFTH ELECTION DISTRICT HOWARD COUNTY
 MARYLAND
 BEING THE ENTIRE PLAT OF THE LAND
 BEING THE ENTIRE PLAT OF THE LAND

Note: This plat shows the boundaries with the
 minimum change in the original
 plat as filed with the State Department of
 Department of Indulgences

Claude M. Skinner, Jr.



Pub.

7/7/72

Needs application

Fee \$15.00

4 - 12' holes on
10,000 ft drill

S/P of land

Mrs. Helen
Dakley
Rt. 2 - Box 329
Finksburg, Md.
21048

These specs. could be
still used.

Land being divided.

(Dakley)
Mrs. Ridgely

Someone picked up
plot. Said you had
called them and something
was ~~too~~ wrong with it.