

**HOWARD COUNTY
 PERMIT APPLICATION**

PERMIT NUMBER

13005-8609

Building Address 6890 MINIK HOLLOW RD
HIGHLAND MD 20777

Property Owner's Name PHIL & AMY STEVENS JR

Suite/ Apt. # 05-414512 SDP/WP/Petition #:

Address 3905 NATIONAL DR S-100

Census Tract 60510 Subdivision DRCA TRACK

City BURTONSVILLE State MD Zip Code 20814

Section _____ Area _____ Lot 19

Home Phone 984-5393 Work Phone SAME

Tax ID # 40-308 Parcel 129 Grid 2

Applicant's Name & Mailing Address, (if other than stated hereon):

Zoning DR Map Coordinates 13H13 Lot size 4.685

Phone _____ Fax _____

Existing Use LAND

Contractor Company OWNER

Proposed Use RESIDENTIAL HOME

Contact Person SAMUEL AS ABOVE

Estimated Construction Cost \$ 400,000

Address _____

Description of Work NEW ^{CONTR} 5 FT HIGH

City _____ State _____ Zip Code _____

DECK AND SCREENED PORCH

License No. _____ Phone _____ Fax _____

FINISHED LOWER LEVEL W/ BATH

4 BED 3 1/2 BATHS ATTACHED 2 CAR

Occupant or Tenant OCCUPANTS

Engineer or Architect Company JOHN WILLIAMS

Contact Name PHIL STEVENS

Contact Person _____

Address 3905 NATIONAL DR S-100

Address 6890 MINIK HOLLOW RD

City BURTONSVILLE State MD Zip Code 20814

City HIGHLAND State MD Zip Code 20777

Phone 410-984-5393 Fax 301-421-9051

Phone 301-854-1109 Fax 301-854-1072

BUILDING DESCRIPTION - COMMERCIAL

BUILDING DESCRIPTION - RESIDENTIAL

Building Characteristics

Utilities

Building Characteristics

Utilities

Height: _____
 No. of stories: _____
 Gross area, sq. ft. per floor: _____
 Use group: _____
 Construction type:
 Reinforced Concrete
 Structural Steel
 Masonry
 Wood Frame
 State Certified Modular

Water Supply:
 Public
 Private
 Sewage Disposal:
 Public
 Private
 Electric Yes No
 Gas Yes No
 Heating System:
 Electric Oil
 Natural Gas
 Propane Gas
 Sprinkler system: N/A
 Full
 Partial
 Other Suppression
 # of Heads _____

SF Dwelling SF Townhouse
 Depth _____ Width _____
 1st floor: _____
 2nd floor: N/A 79 51
 Basement: 79 57
 Finished Basement Unfinished Basement
 Crawl space Slab on Grade
 No. of Bedrooms 4
 Height: 32
 Multi-family dwellings:
 No. of efficiency units: _____
 No. of 1 BR units: _____
 No. of 2 BR units: _____
 No. of 3 BR units: _____
 Other Structure: _____
 Dimensions: _____
 Footings: _____
 Roof Height: _____
 State Certified Modular
 Manufactured Home

Water Supply:
 Public
 Private
 Sewage Disposal:
 Public
 Private
 Electric Yes No
 Gas Yes No
 Heating System:
 Electric Oil
 Natural Gas
 Propane Gas
 Sprinkler system: N/A
 NFPA #13D
 NFPA #13R
 Other:


THE UNDERSIGNED HEREBY CERTIFIES AND AGREES AS FOLLOWS: (1) THAT HE/SHE IS AUTHORIZED TO MAKE THIS APPLICATION; (2) THAT THE INFORMATION IS CORRECT; (3) THAT HE/SHE WILL COMPLY WITH ALL REGULATIONS OF HOWARD COUNTY WHICH ARE APPLICABLE THERETO; (4) THAT HE/SHE WILL PERFORM NO WORK ON THE ABOVE REFERENCED PROPERTY NOT SPECIFICALLY DESCRIBED IN THIS APPLICATION; (5) THAT HE/SHE GRANTS COUNTY OFFICIALS THE RIGHT TO ENTER ONTO THIS PROPERTY FOR THE PURPOSE OF INSPECTING THE WORK PERMITTED AND POSTING NOTICES.

Phil
 Applicant's Signature
OWNER
 Title/Company

PHIL STEVENS JR
 Print Name
3/20/06
 Date

Checks payable to: **DIRECTOR OF FINANCE OF HOWARD COUNTY**
**** PLEASE WRITE NEATLY AND LEGIBLY. ****

FOR OFFICE USE ONLY

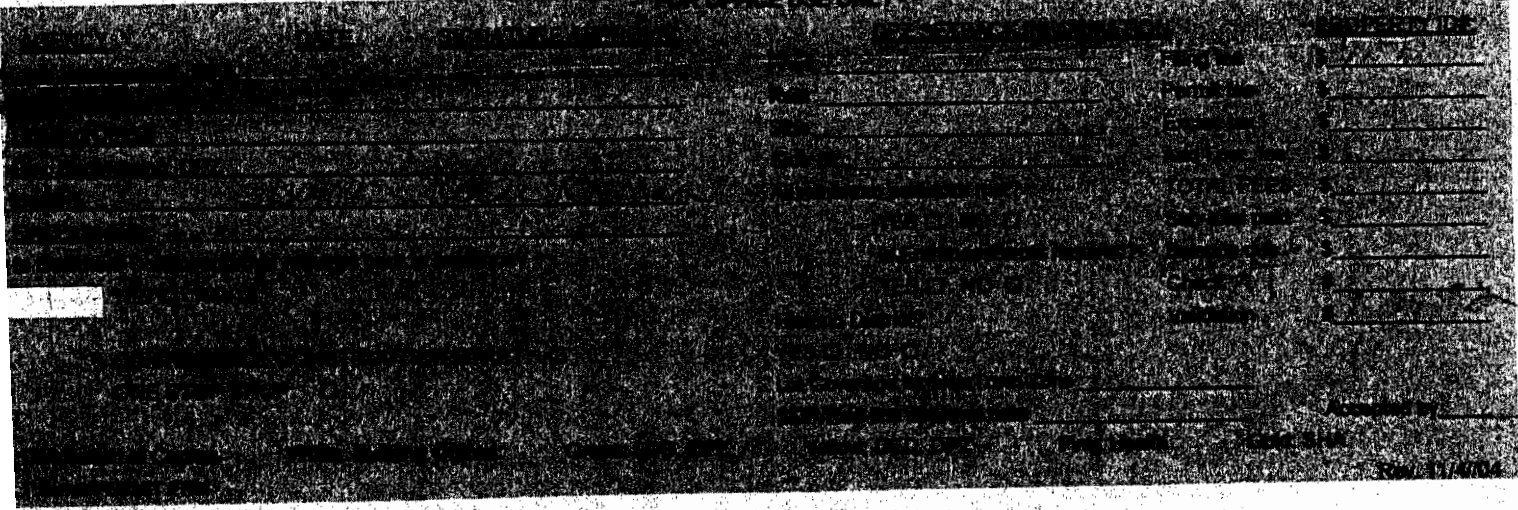

Mr. Spracino Prop or Real Investor Lot

SEPTIC TANK: 3 BEDROOM, 1000 GALLON
4 BEDROOM, 1250 GALLON

Lot 5 Mink Hollow Rd

DRY WELL TO HAVE 120 SQUARE FEET OF SIDEWALL AREA PER BEDROOM.

DRY WELL INLET TO BE MAX. 5 FEET BELOW ORIGINAL GRADE.


DRY WELL BOTTOM (MAXIMUM DEPTH) TO BE 14 FEET BELOW ORIGINAL GRADE.

PLACE THE DRY WELL 250 FEET FROM THE FRONT LOT LINE AND 85 FEET FROM THE LEFT LOT LINE AS SEEN WHEN FACING THE LOT FROM MINK HOLLOW ROAD.

Note THE FRONT LOT LINE IS
359.30' FT long & runs S 66° 37' 55" W
The left lot line is 906.33' long &
runs N 05° 03' 55" W

BLDG. PERMIT SIGNED
AND RETURNED 6/29/78
Serial No. 35758

BLDG. PERMIT SIGNED
AND RETURNED 7/20/78
Horse Barn

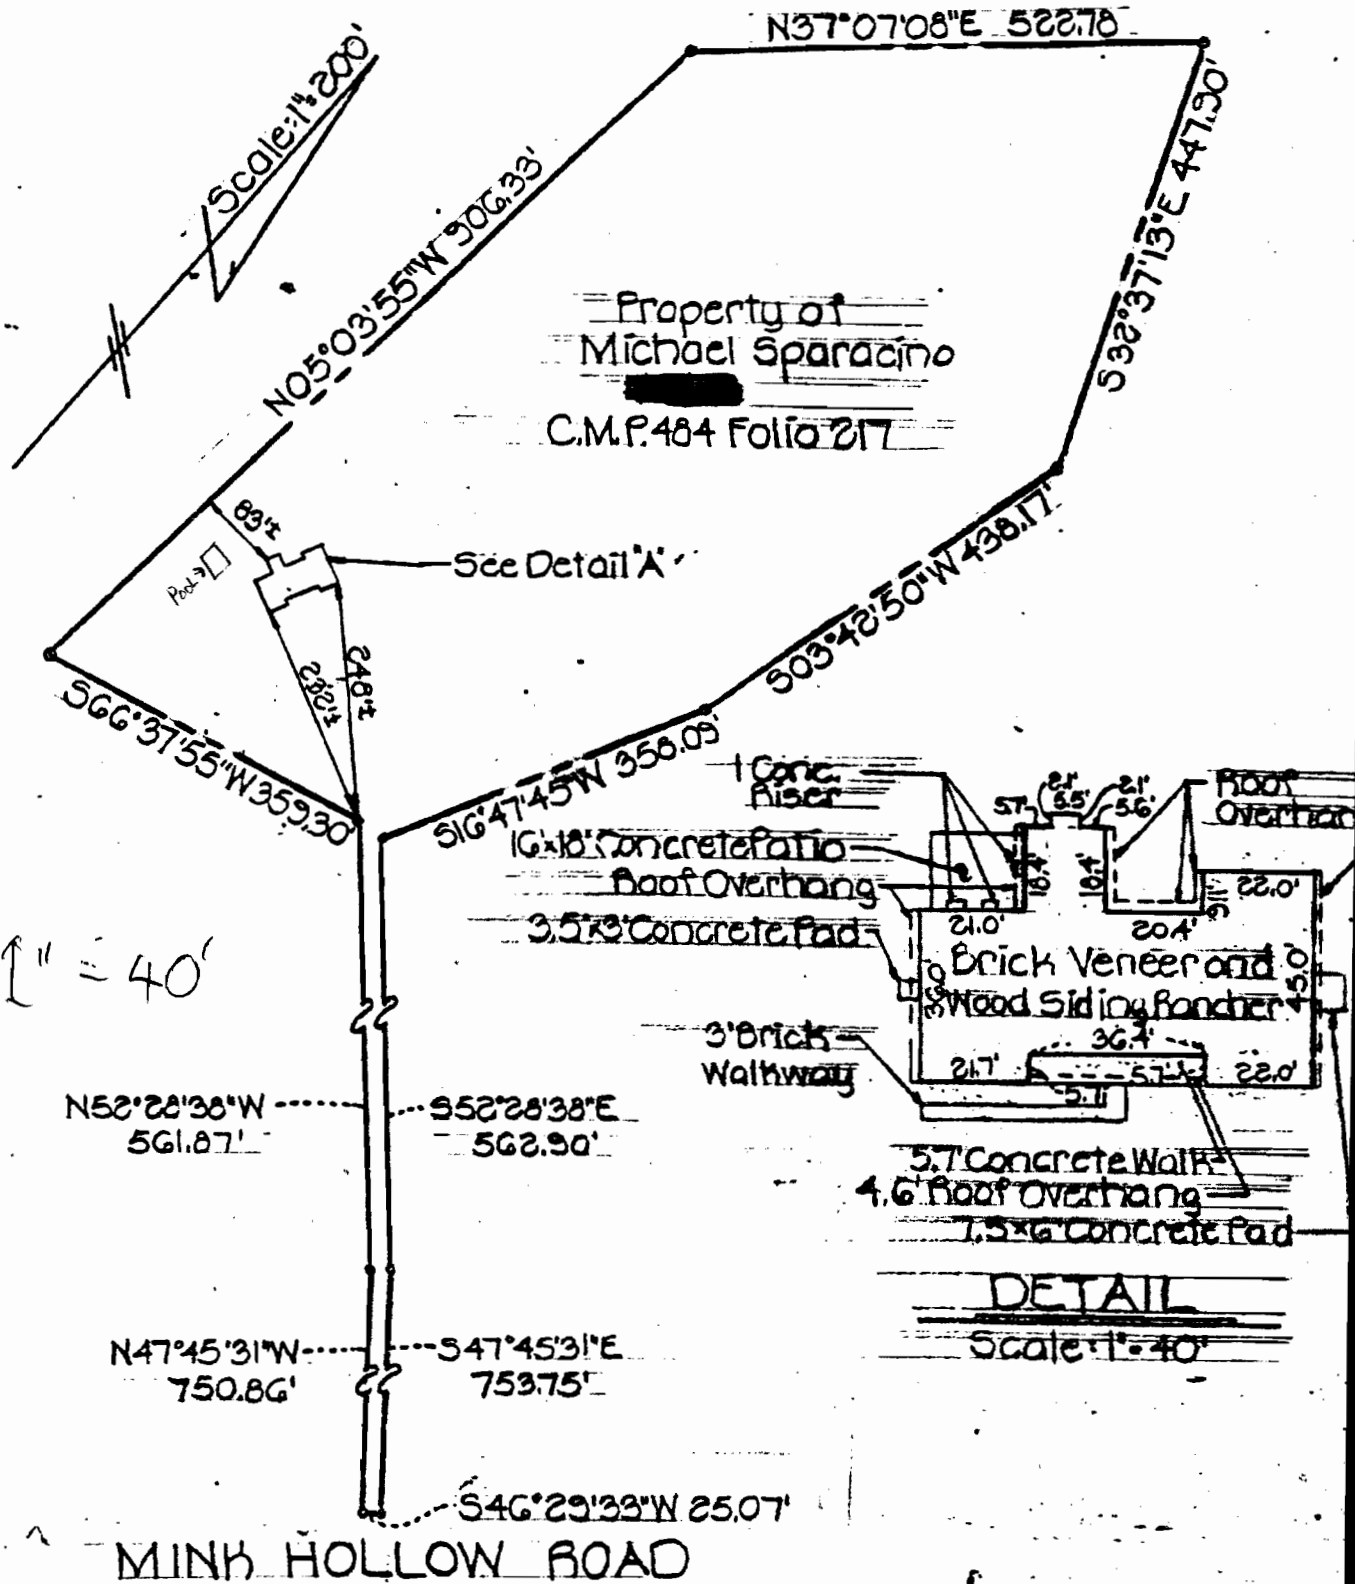

I hereby certify that I have surveyed the property known as Lot 5 Proper of Michael Sparacino, 5th Election District, Howard County, Maryland; for the purpose of locating the improvements thereon and the improvements are located as shown.



WALTER PARK
5160 STAFFORD ROAD
BALTIMORE MARYLAND 21227

Signed this 17th day of September 1979
Walter Park
Walter Park, Land Surveyor
Md. Reg. No. 5539

Note: This plat is not intended for use in the establishment of property lines.