

B 1 7035

SEQUENCE NO. (OEP USE ONLY)

STATE OF MARYLAND PERMIT TO DRILL WELL

OEP PERMIT NUMBER

70-81-7073

(THIS NUMBER IS TO BE PUNCHED IN COLS. 3-6 ON ALL CARDS)

A#514943-A

please print or type

fill in this form completely

Date Received

7/18/85 9:30

OWNER INFORMATION

15 Last Name, Owner, First Name, 36 Street or RFD, 57 Town, 70 State 72, Zip, 76

B 3

LOCATION OF WELL


8 COUNTY, 23 SUBDIVISION, SECTION, LOT, 52 NEAREST TOWN, MILES FROM TOWN

DRILLER INFORMATION

Driller's Name, Firm Name, Address, Signature, Date, 77 License No. 80

B 4

DIRECTION OF WELL FROM TOWN (CIRCLE BOX)

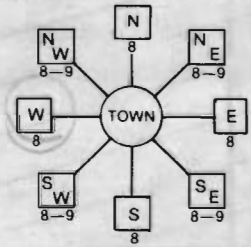

NEAR WHAT ROAD

ON WHICH SIDE OF ROAD (CIRCLE APPROPRIATE BOX)



DISTANCE FROM ROAD, ENTER FT or MI

B 2 WELL INFORMATION

APPROX. PUMPING RATE (GAL. PER MIN.), AVERAGE DAILY QUANTITY NEEDED (GAL. PER DAY)

USE FOR WATER (CIRCLE APPROPRIATE BOX)

- D HOME (SINGLE OR DOUBLE HOUSEHOLD UNIT ONLY)
F FARMING (LIVESTOCK WATERING & AGRICULTURAL IRRIGATION)
I INDUSTRIAL, COMMERCIAL, STATE AND FEDERAL GOV. OTHER (REQUIRES APPROPRIATION PERMIT)
P PUBLIC OR PRIVATE WATER COMPANY (REQUIRES APPROPRIATION PERMIT AND STATE HEALTH DEPARTMENT APPROVAL)
T TEST, OBSERVATION, MONITORING (MAY REQUIRE APPROPRIATION PERMIT)

NOT TO BE FILLED IN BY DRILLER HEALTH DEPARTMENT APPROVAL

COUNTY NAME HOWARD, COUNTY NO., OEP SIGNATURE, DATE ISSUED, CO SIGNATURE, EXP. DATE, NORTH GRID, EAST GRID

APPROXIMATE DEPTH OF WELL FEET

APPROXIMATE DIAMETER OF WELL, NEAREST INCH

METHOD OF DRILLING (circle one)

BORED (or Augered), JETTED, Jetted & DRIVEN, AIR-ROtary, AIR-PERcussion, ROTARY (Hydraulic Rotary), CABLE, REVerse-ROtary, DRive-POINT, other

REPLACEMENT OR DEEPEMED WELLS (CIRCLE APPROPRIATE BOX)


- N THIS WELL WILL NOT REPLACE AN EXISTING WELL
Y THIS WELL WILL REPLACE A WELL THAT WILL BE ABANDONED AND SEALED
S THIS WELL WILL REPLACE A WELL THAT WILL BE USED AS A STANDBY
D THIS WELL WILL DEEPEM AN EXISTING WELL
PERMIT NUMBER OF WELL TO BE REPLACED OR DEEPEMED (IF AVAILABLE)

SHOW MAJOR FEATURES OF BOX & LOCATE WELL WITH AN X

SOURCES OF DRILLING WATER

- 1. well
2.
3.

WRITE THE BOX NUMBER FROM THE MAP HERE

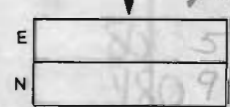

DRAW A SKETCH BELOW SHOWING LOCATION OF WELL IN RELATION TO NEARBY TOWNS AND ROADS AND GIVE DISTANCE FROM WELL TO NEAREST ROAD JUNCTION



Not to be filled in by driller (OEP USE ONLY)

APPROP. PERMIT NUMBER, FORCE, WRITE INITIALS IN BOX, PERMIT No.

SPECIAL CONDITIONS House built 18005

RPS# 367484

514943-A

McCotter Prop

A# 514943-A



7/12/85 ⊕ well site ok. (3rd by hole) 4.5  
40' to right of house & 30' from old well

James M<sup>c</sup> Cotter

6927 Mink Hollow Rd.

854-2686

existing house just moved  
in there

3 children

Easterday

out of water


WORK

699-9300-

SITE INSPECTION SHEET

OWNER: Dwight Wilcox PHONE #: \_\_\_\_\_  
ADDRESS: 6527 Mink Hollow Rd CONTRACTOR: \_\_\_\_\_  
Highland WELL TAG #: \_\_\_\_\_  
SUBDIVISION: \_\_\_\_\_ LOT: \_\_\_\_\_ COUNTY #: \_\_\_\_\_  
PROPOSAL: Site inspection for well and septic locations

LOCATION DIAGRAM

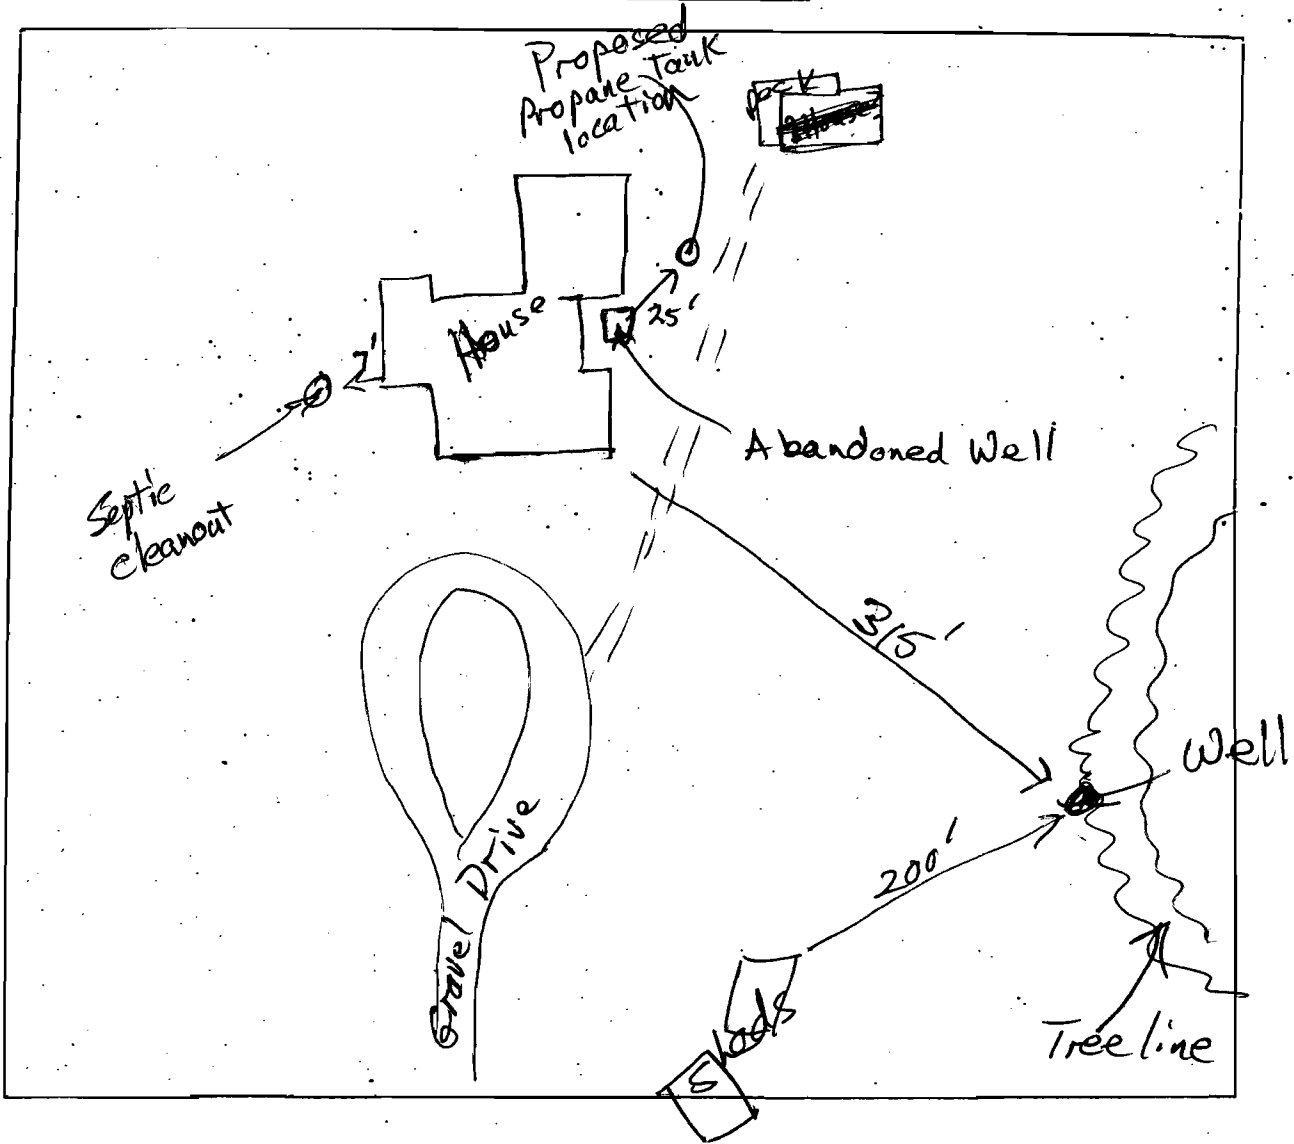

COMMENTS: \_\_\_\_\_  
\_\_\_\_\_  
\_\_\_\_\_