

4/10/64

approved
4/10/64
per

PERMIT

P 08218

SEWAGE DISPOSAL SYSTEM

A 07483

MARYLAND STATE DEPARTMENT OF HEALTH

HOWARD COUNTY

ELLICOTT CITY

INDEXED

DISTRICT 5

DATE 3/30/64

Wilmer Haviland IS PERMITTED TO INSTALL X ALTER

ADDRESS Highland, Maryland PHONE 286-2378

A SEWAGE DISPOSAL SYSTEM LOCATED AT _____

SUBDIVISION Cissel Farm ROAD Mink Hollow LOT 15

PROPERTY OWNER Francis W. Smith

ADDRESS 122 Mink Hollow Road

SPECIFICATIONS 4 bedrooms

DRAIN FIELD _____ DEPTH _____ FEET, BOTTOM AREA _____ SQ. FT.

SEEPAGE PITS _____ ABSORBENT SIDE-WALL AREA _____ SQ. FT.

SEPTIC TANK CAPACITY 1,000 GALLONS

FOR GARBAGE GRINDER, INCREASE DISPOSAL AREA 22% & TANK CAPACITY 50%.

OTHER Dry well - 12 ft. diameter and 11 ft. deep below inlet pipe.

Place dry well about 180 ft. from front lot line and about

21 ft. from left side determined on you face lot from

Mink Hollow Rd.

PLANS APPROVED BY Donald W. Monaghan DATE 10/1/63


FILL SEPTIC TANK AND DISTRIBUTION BOX WITH WATER BEFORE CALLING FOR AN INSPECTION. COVER NO WORK UNTIL INSPECTED AND APPROVED.

NEITHER THE HOWARD COUNTY COMMISSIONERS NOR THE HEALTH DEPARTMENT IS RESPONSIBLE FOR THE SUCCESSFUL OPERATION OF ANY SYSTEM.

A 07483

A# 07483

10/6/63

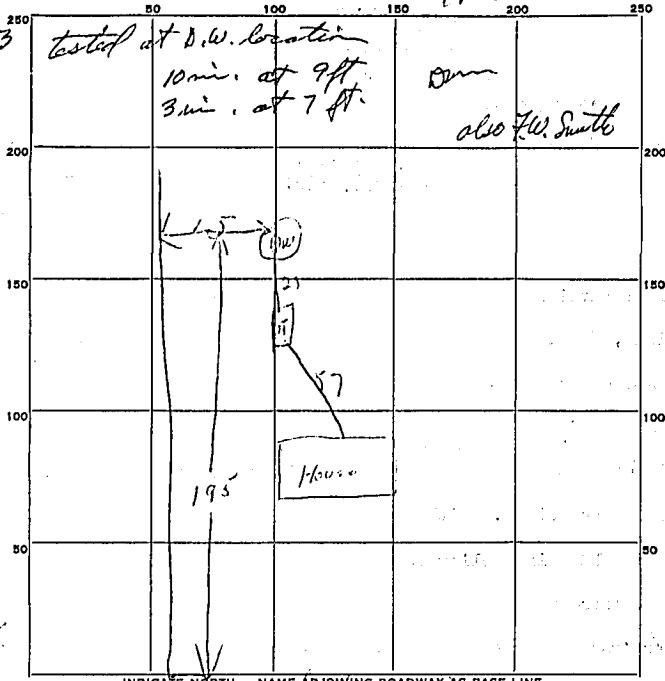

||

65
3

$$\begin{array}{r} 5.16 \\ \underline{6.25} \\ 31.0 \\ \underline{32.6} \\ 1.14 \\ \underline{1.85} \\ 3.96 \\ \underline{37.6} \\ 48.24 \end{array}$$

INDICATE NORTH - NAME ADJOINING ROADWAY AS BASE LINE.

West Hollow Rd

PERMIT CARD not posted

SEPTIC TANK, LEVEL 25 CLEANOUTS 0 12

DISTRIBUTION, BOX, LEVEL _____

TILE FIELD, DEPTH _____ FT. TRENCH WIDTH _____ FT.

GRAVEL DEPTH _____ IN. TOTAL LENGTH _____ FT.

NUMBER OF TRENCHES _____ TOTAL BOTTOM AREA _____

SEEPAGE PITS, INSIDE DIAMETER 10 FT. DEPTH BELOW INLET 11 1/2 FT.

ABSORBENT AREA 432.4 SQ. FT.

REMARKS _____

8/3/79 no visible septic problems. Or ok

(for latrine addition on left side of house)

DATE SYSTEM APPROVED 4/4/64 INSPECTOR [Signature]