

**HOWARD COUNTY
PERMIT APPLICATION**

PERMIT NUMBER
B07001747

Building Address 7029 Mark Hollow Road
Highland MD 20777
Suite/Apt. #: _____ SDP/WP/Petition #: 100
Census Tract 01351 Subdivision 10000000
Section _____ Area _____ Lot 2
Tax Map 40 Parcel 200 Grid 8
Zoning _____ Map Coordinates _____ Lot size 100

Property Owner's Name Andy & Sandy Levy
Address 7029 Mark Hollow Road
City Highland State MD Zip Code 20777
Home Phone 301-854-1416 Work Phone _____
Applicant's Name & Mailing Address, (if other than stated hereon):
Phone _____ Fax _____

Existing Use Single Family Residential
Proposed Use Single Family Residential
Estimated Construction Cost \$ 80,000
Description of Work Excavate area under existing deck, 16'x18' w/ 4" dia. Add 1"

Contractor Company March Construction & Remodeling
Contact Person Ken March
Address P.O. Box 383
City Fallston State MD Zip Code 20789
License No. 23363
Phone 301-776-1176 Fax 301-776-6891

Occupant or Tenant Andy & Sandy Levy
Contact Name Andy Levy
Address 7029 Mark Hollow Road
City Highland State MD Zip Code 20777
Phone 301-854-1416 Fax _____

Engineer or Architect Company Henry R. W. Ward
Contact Person Henry R. W. Ward
Address P.O. Box 186
City Glen Dale State MD Zip Code _____
Phone _____ Fax _____

BUILDING DESCRIPTION - COMMERCIAL

BUILDING DESCRIPTION - RESIDENTIAL

Building Characteristics	Utilities
Height: _____	Water Supply: _____ Public _____ Private _____
No. of stories: _____	Sewage Disposal: _____ Public _____ Private _____
Gross area, sq. ft. per floor: _____	Electric Yes <input type="checkbox"/> No <input type="checkbox"/>
Use group: _____	Gas Yes <input type="checkbox"/> No <input type="checkbox"/>
Construction type: _____ Reinforced Concrete _____ Structural Steel _____ Masonry _____ Wood Frame _____ State Certified Modular _____	Heating System: _____ Electric <input type="checkbox"/> Oil <input type="checkbox"/> Natural Gas <input type="checkbox"/> Propane Gas <input type="checkbox"/> Sprinkler system: <u>N/A</u> <input type="checkbox"/> Full _____ Partial _____ Other Suppression _____ # of Heads _____

Building Characteristics	Utilities
SF Dwelling <input checked="" type="checkbox"/> SF Townhouse <input type="checkbox"/> Depth _____ Width _____ 1st floor: <u>16'</u> <u>18.67'</u> 2nd floor: _____ Basement: _____ Finished Basement <input type="checkbox"/> Unfinished Basement <input type="checkbox"/> Crawl space <input type="checkbox"/> Slab on Grade <input type="checkbox"/> No. of Bedrooms <u>N/A</u> Multi-family dwellings: No. of efficiency units: _____ No. of 1 BR units: _____ No. of 2 BR units: _____ No. of 3 BR units: _____ Other Structure: _____ Dimensions: _____ Footings: _____ Roof: _____ State Certified Modular _____ Manufactured Home _____	Water Supply: _____ Public _____ Private <input checked="" type="checkbox"/> Sewage Disposal: _____ Public _____ Private <input checked="" type="checkbox"/> Electric Yes <input type="checkbox"/> No <input type="checkbox"/> Gas Yes <input type="checkbox"/> No <input type="checkbox"/> Heating System: _____ Electric <input type="checkbox"/> Oil <input type="checkbox"/> Natural Gas <input type="checkbox"/> Propane Gas <input type="checkbox"/> Sprinkler system: <u>N/A</u> <input type="checkbox"/> NFPA #13D _____ NFPA #13R _____ Other: _____

THE UNDERSIGNED HEREBY CERTIFIES AND AGREES AS FOLLOWS: (1) THAT HE/SHE IS AUTHORIZED TO MAKE THIS APPLICATION; (2) THAT THE INFORMATION IS CORRECT; (3) THAT HE/SHE WILL COMPLY WITH ALL REGULATIONS OF HOWARD COUNTY WHICH ARE APPLICABLE THERE TO; (4) THAT HE/SHE WILL PERFORM NO WORK ON THE ABOVE REFERENCED PROPERTY NOT SPECIFICALLY DESCRIBED IN THIS APPLICATION; (5) THAT HE/SHE GRANTS COUNTY OFFICIALS THE RIGHT TO ENTER ONTO THIS PROPERTY FOR THE PURPOSE OF INSPECTING THE WORK PERMITTED AND POSTING NOTICES.


Ken March
Applicant's Signature
March Construction & Remodeling - LLC
Title/Company

Ken March
Print Name
1/27/07
Date

Checks payable to: **DIRECTOR OF FINANCE OF HOWARD COUNTY**


** PLEASE WRITE NEATLY AND LEGIBLY. **

AGENCY	DATE	SIGNATURE APPROVAL	DPZ SETBACK INFORMATION	PROPERTY ID#	
<input checked="" type="checkbox"/> Land Development, DPZ			Front: _____	Filing fee \$ <u>25.00</u>	
<input type="checkbox"/> State Highways			Rear: _____	Permit fee \$ _____	
<input checked="" type="checkbox"/> Building Official			Sides: _____	Excise tax \$ _____	
<input checked="" type="checkbox"/> Dev. Engineering, DPZ			Side St: _____	Add'l per. fee \$ _____	
<input checked="" type="checkbox"/> Health	<u>2/12/07</u>	<u>[Signature]</u>	All minimum setbacks met? YES <input type="checkbox"/> NO <input type="checkbox"/>	TOTAL FEES \$ _____	
<input type="checkbox"/> Fire Protection			Is Entrance Permit required? YES <input type="checkbox"/> NO <input type="checkbox"/>	Subtotal paid \$ _____	
Is Sediment Control approval required prior to issuance? YES <input type="checkbox"/> NO <input type="checkbox"/>			Historic District? YES <input type="checkbox"/> NO <input type="checkbox"/>	Balance due \$ _____	
CONTINGENCY CONSTRUCTION START: <input type="checkbox"/>			Lot Coverage for New Town Zone _____	Check # <u>123456</u>	
ONE STOP SEQOP: <input type="checkbox"/>			SDP/Red-line approval date _____	Validation # _____	
Distribution of Copies -	White: Building Official	Green: LDD, DPZ	Yellow: JRD, DPZ	Pink: Health	Gold: SHA

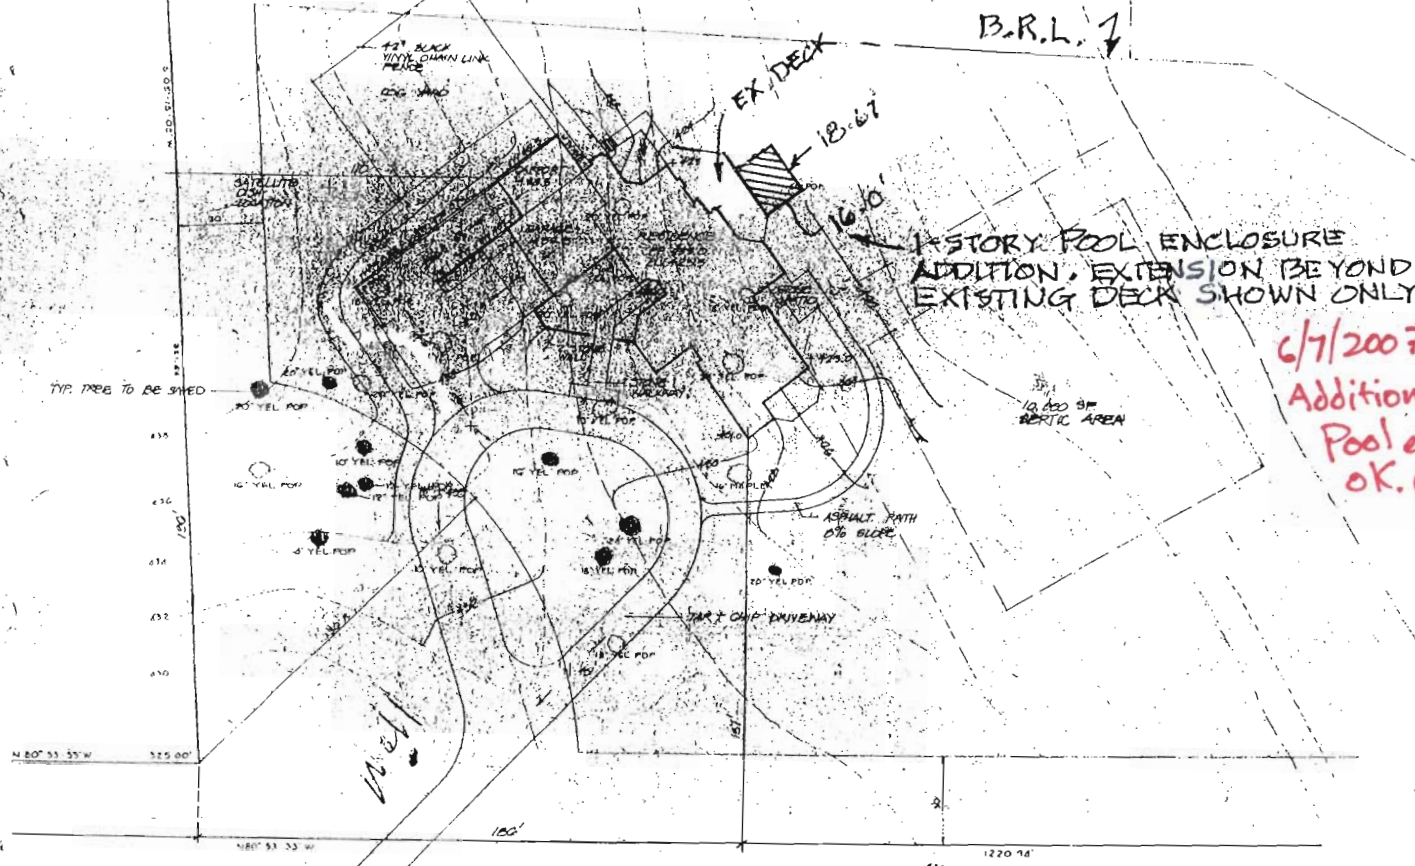

6/7/2007
 Addition for
 Pool enclosure
 OK. (GTC)


SITE PLAN - POOL ENCLOSURE
ADDITION. APRIL, 2007

 COLUMBIA DESIGN COLLECTIVE ARCHITECTURE PLANNING LANDSCAPE ARCHITECTURE 8437 TWIN KNOLLS RD. COLUMBIA, MD. 21046 888-680-BALTO. 686-4054 D.C. 821-8885 VA.	
DATE INC.	REVISION
OWNER DEVELOPER	
PROJECT	
SHEET	
LEVY RESIDENCE	
THE RIEMER GROUP, INC.	
DATE	DESIGNED BY EJM/MS
	DRAWN BY WDS
	PROJECT NO CH1100
	DATE
	SCALE 1"=20'
	DRAWING NO L-1


well 161'

Septic 2077117 21 11:48
to corner of House 20'
to house corner of Addition 26'
to outside " " 25'

2077117
11:48
21
2077117

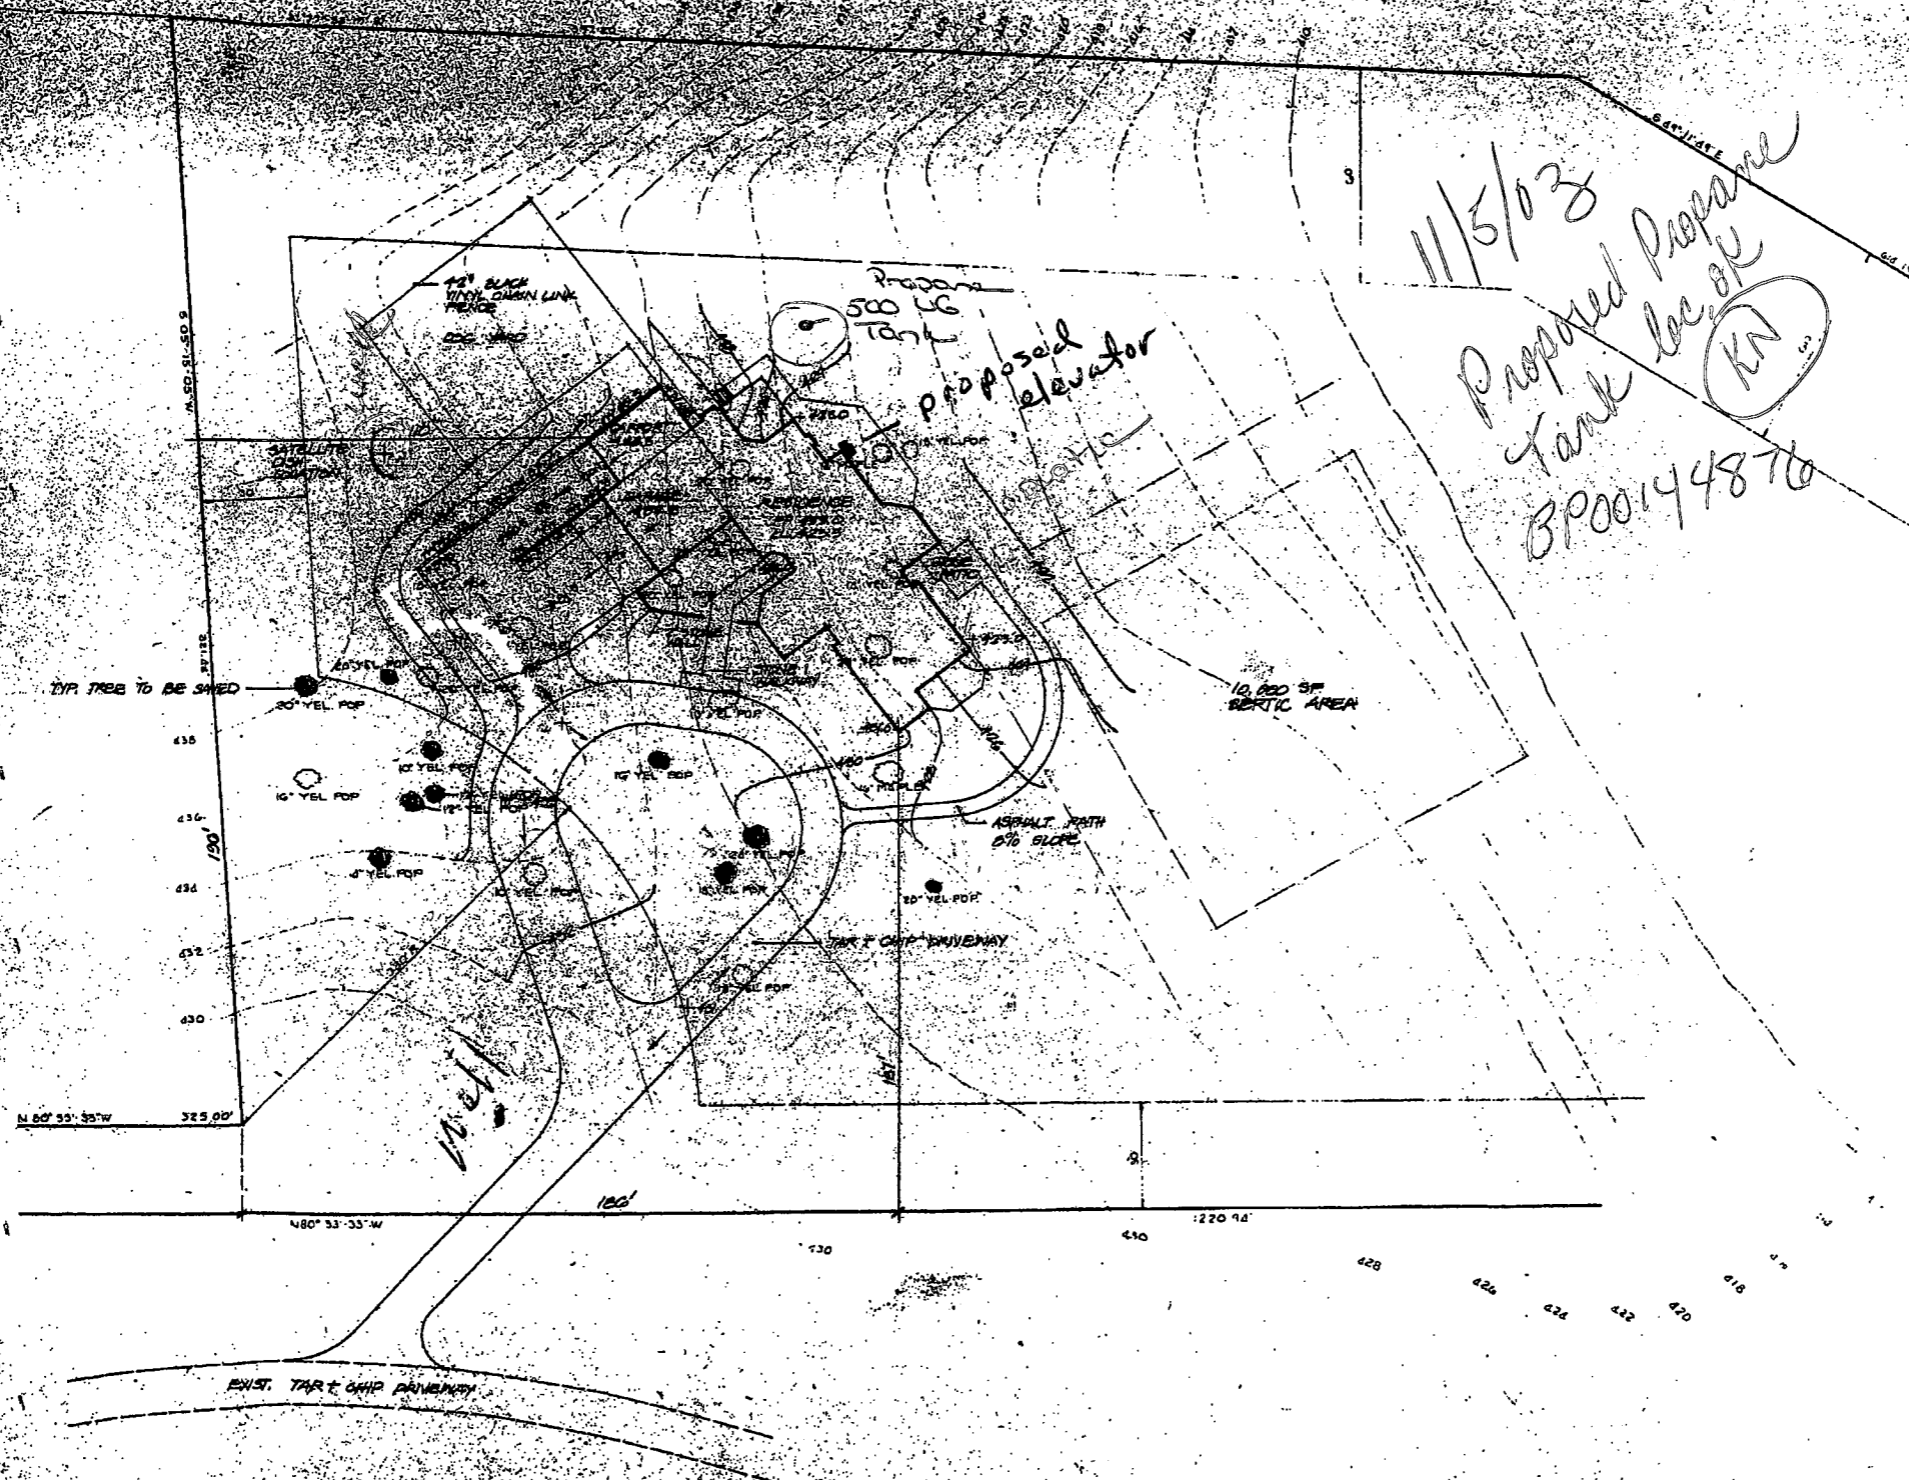

CDG	
COLUMBIA DESIGN COLLECTIVE	
ARCHITECTURE	PLANNING
LANDSCAPE ARCHITECTURE	
5457 TWIN KNOLLS RD. COLUMBIA, MD. 21046 905-4040 BALTO. 800-4094 D.C. 621-8885 VA.	
DATE (NO)	REVISION
OWNER DEVELOPER	
PROJECT	
SHEET	
LEVY RESIDENCE	
THE RIEMER GROUP, INC	
DATE	DESIGNED BY EJM/MS
	DRAWN BY WDS.
	PROJECT NO 011100
	DATE
	SCALE 1" = 20'
	DRAWING NO L-1

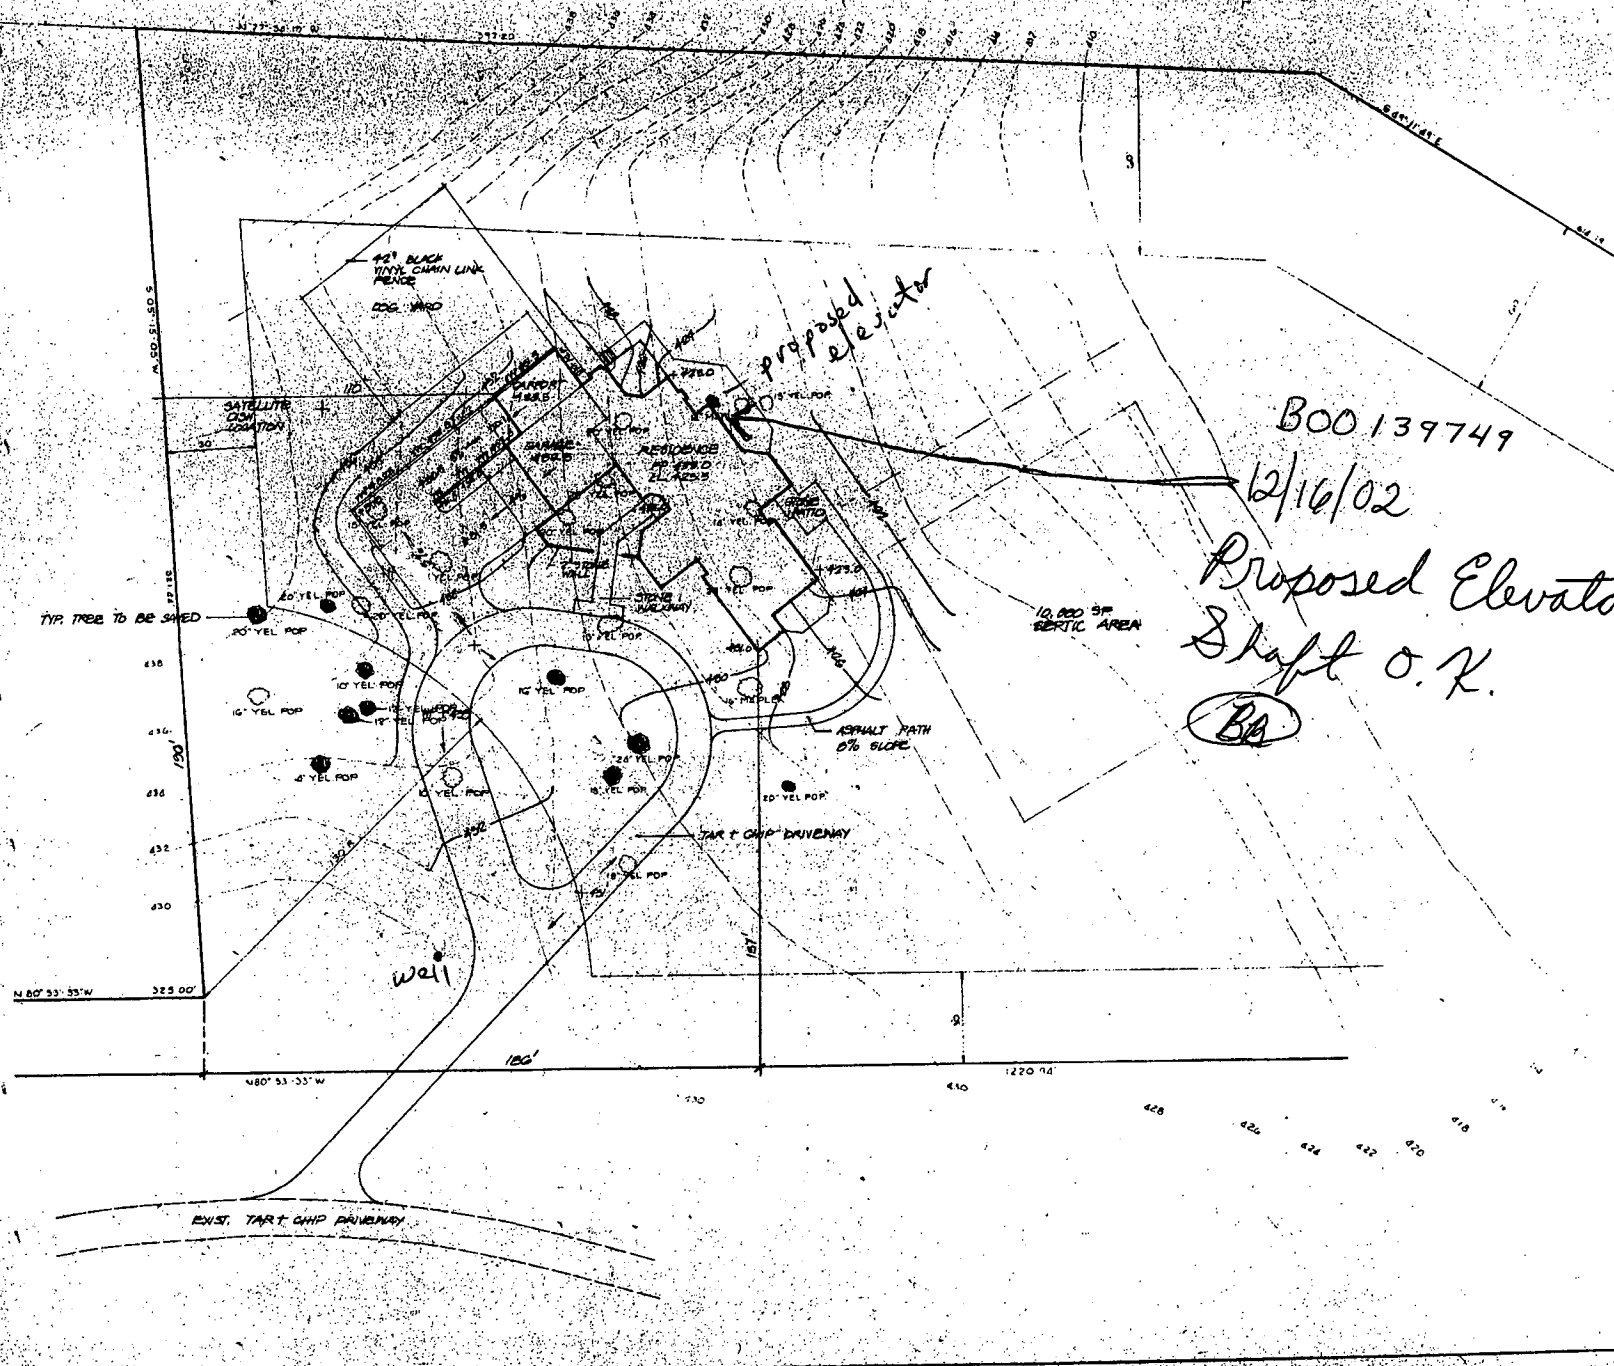

B00139749

12/16/02

Proposed Elevator
Shaft O.K.

BA



CDG
COLUMBIA DESIGN
COLLECTIVE

ARCHITECTURE PLANNING
LANDSCAPE ARCHITECTURE
6457 TWIN KROLLS RD. COLUMBIA, MD. 21046
800-4040 BALTO. 800-4084 D.C. 821-8888 VA.

DATE NO. REVISION
OWNER DEVELOPER

EMPLOYER
DATE

LEVY RESIDENCE
THE RIEMER GROUP, INC.

DATE	DESIGNED BY EJM/MS
	DRAWN BY WDS
	PROJECT NO 011100
	DATE
	SCALE 1"=20'
	DRAWING NO L-1