

REGION \_\_\_\_\_

AREA \_\_\_\_\_

RATING \_\_\_\_\_

ACKNOWLEDGMENT AND CONTROLS	DATE

Howard County Department of Health  
BUREAU OF ENVIRONMENTAL HEALTH

RECORD OF INVESTIGATION

DISPOSITION	DATE

LOCATION 7036 Mink Hollow Rd ZIP \_\_\_\_\_  
 OWNER  Diana Kraus Swann Hill Lot 5 ADDRESS 7036 Mink Hollow Rd PHONE (301) 854-0361  
 OCCUPANT  \_\_\_\_\_ ADDRESS \_\_\_\_\_ PHONE \_\_\_\_\_  
 COMPLAINANT same as above ADDRESS \_\_\_\_\_ PHONE \_\_\_\_\_

REASON FOR INVESTIGATION Stagnant water in backyard since August, not near sept. c system; may be near neighbors. 1 acre lot neighbor to left is Keith & Tracy McLaughlin 7040 Mink Hollow Rd (301) 854-7031 (Swann Hill) Lot 6

RECEIVED BY J. Sherman DATE 10-23-96 ASSIGNED TO M.R. DATE 10-23-96

DATE OF INVESTIGATION 11/1/96 TIME 10:00 WEATHER cloudy, cool, drizzling

REPORT MET OWNER @ SITE. OWNER SHOWED ME PUDDLE OF BLACK H<sub>2</sub>O w/ALGAE ON LEFT SIDE OF PROP NEAR EX. TRENCH; ALSO SHOWED ME SLIGHT RESIDUE NEAR EX. PUMP PIT; EX. PUMP PIT IS 3 MANHOLE RINGS ~ 6' DEEP, w/ONE (ALARM??) FLOAT DISABLED; ~~PUMP~~ PUMP OPERATING; H<sub>2</sub>O FLOWING IN CONSIDERABLE TINDOUSLY FROM PIPE NOT ASSOC. w/PUMP (PERHAPS A 2ND ~~PIPE~~ (GRAVITY FLOW) SATURATED TRENCH); ADVISED OWNER THAT LARGE PUDDLE ON LEFT SIDE IS A SEWAGE DISCHARGE, THAT IMMED. REPAIR NECESSARY (ALLOWED ONE MO. SINCE NOT A COMPAINT SITUATION), BUT THAT <sup>GROUND</sup> H<sub>2</sub>O IS A PROBLEM AND REPAIR WOULD LIKELY BE DIFF. DUE TO LOT SIZE, LAYOUT & TOPO; REQUESTED THAT HE MINIMIZE DISCHARGES BY KEEPING S.T. PUMPED; OWNER TO WORK ON REPAIR LOGISTICS IMMED, & WILL NOTIFY H.D. AS NEEDED MR

DATE SUBMITTED \_\_\_\_\_ SANITARIAN \_\_\_\_\_

11/1/98  
9-10

SITE INSPECTION SHEET

OWNER: Kraus

DATE REQUESTED: \_\_\_\_\_

PHONE #: \_\_\_\_\_


CONTRACTOR: \_\_\_\_\_

ADDRESS: 7036 Mink Hollow Rd

WELL TAG #: \_\_\_\_\_

COUNTY #: \_\_\_\_\_

PROPOSAL: stagnant H<sub>2</sub>O may be sewage

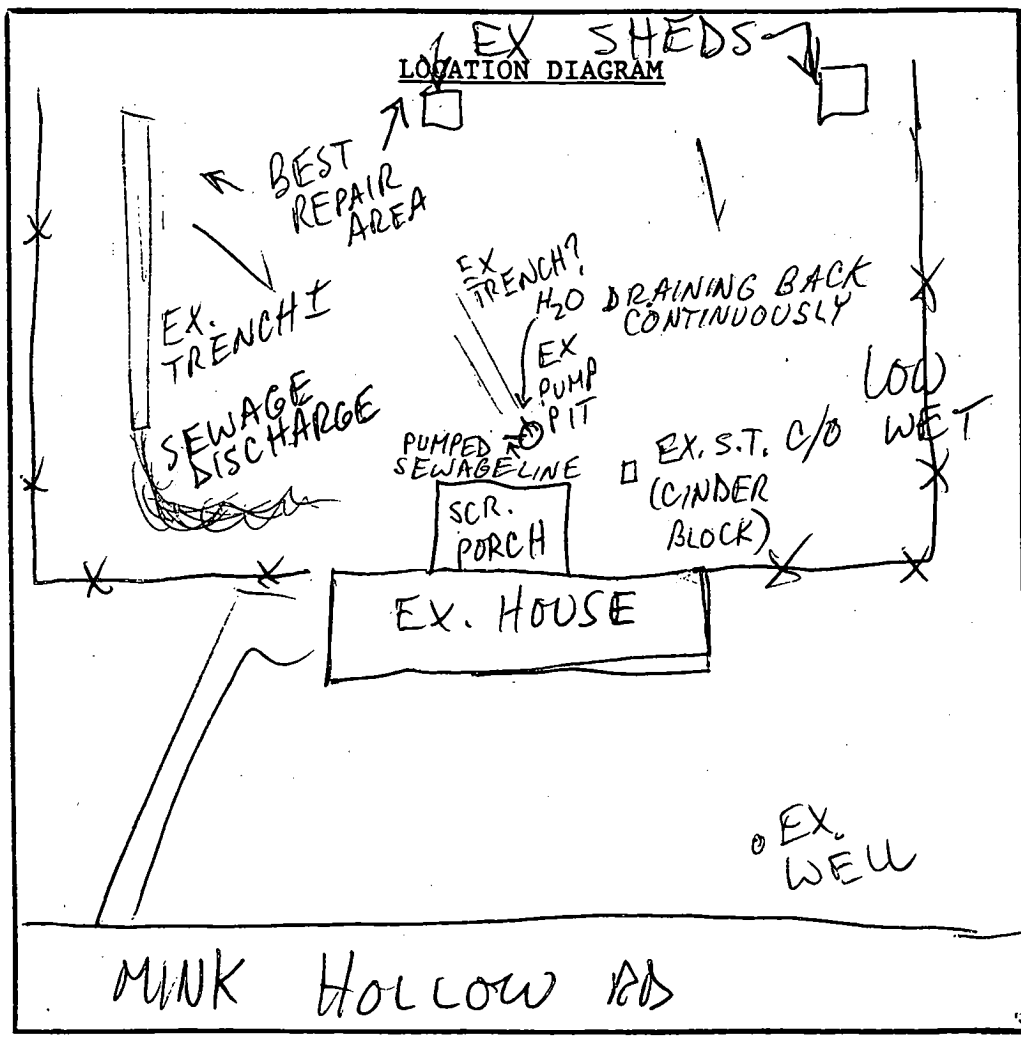

COMMENTS: SEE ATTACHED MR

DATE: \_\_\_\_\_

INSPECTOR: \_\_\_\_\_

Repair  
11 AM  
8/4/89

# PERMIT

P 44803

SEWAGE DISPOSAL SYSTEM

A REPAIR

MARYLAND STATE DEPARTMENT OF HEALTH DISTRICT \_\_\_\_\_

**HOWARD COUNTY**  
BUREAU OF ENVIRONMENTAL HEALTH  
461-9933

DATE 7/31/89

<sup>BP</sup>  
DATE SYSTEM APPROVED 8/7/89

INDEXED

INSPECTOR C Williams

Jim Adair IS PERMITTED TO INSTALL \_\_\_\_\_ ALTER X

ADDRESS 432 Hill View Drive, Linthicum, Maryland 21090 PHONE 789-0789

SUBDIVISION Swann Hill ROAD 7036 Mink Hollow Road LOT 5

PROPERTY OWNER Bernard Heidebach  
ADDRESS 7036 Mink Hollow Road

IF GARBAGE GRINDER IS USED INCREASE SEPTIC TANK CAPACITY BY 50% AND ABSORPTION AREA BY 22%.

GARBAGE GRINDER? YES \_\_\_\_\_ NO \_\_\_\_\_

SEPTIC TANK CAPACITY \_\_\_\_\_ GALLONS NUMBER OF BEDROOMS \_\_\_\_\_

REPAIR - TO ESTABLISH SEPTIC REPAIR CAPACITY TO ACCOMMODATE PROPOSED ADDITION

(Building Permit No. 28099)

RECOMMEND APPROVAL OF BP 28099 FOR PROPOSED GARAGE  
NO FUTURE SEPTIC REPAIR AREA LOST MR 8/7/89

PLANS APPROVED BY C. Williams DATE 7/31/89

COVER NO WORK UNTIL INSPECTED AND APPROVED

NEITHER THE HOWARD COUNTY COUNCIL NOR THE HEALTH DEPARTMENT IS RESPONSIBLE FOR THE SUCCESSFUL OPERATION OF ANY SYSTEM

NOTE: CLEANOUT REQUIRED EVERY 70 FEET OF SEWER LINE AND/OR AT 90° SWEEPS IN LINES FROM HOUSE TO DRAIN FIELDS

NOTE: ALL PARTS OF SEPTIC SYSTEMS (I.E. TANK, DISTRIBUTION BOX, TRENCHES) TO BE 100 FEET FROM WELL (UNLESS OTHERWISE SPECIFICALLY AUTHORIZED)

NOTE: IF DEEP TRENCHES ARE USED CALL FOR INSPECTION BEFORE AND AFTER PLACING GRAVEL IN TRENCHES

NOTE: NO DRY WELL SHALL EXCEED 15 FOOT IN DIAMETER NO ABSORPTION TRENCH TO EXCEED 100 FEET IN LENGTH

NOTE: ALL PIPE FROM HOUSE TO SEPTIC TANK MUST BE CAST IRON OR SCHEDULE 40 PVC OR ABS

PERMIT VOID AFTER TWO YEARS

NOTE: INSTALL STAND PIPE ON SEPTIC TANK AND DRY WELL. STAND PIPES MUST BE 6 INCHES IN DIAMETER. CAST IRON, CONCRETE OR TERRA COTTA OR PVC OR ABS ACCEPTED. IF TOP OF SEPTIC TANK IS DEEPER THAN 3 FEET, MANHOLE TO GRADE REQUIRED

NOTE: DISTRIBUTION BOXES MUST HAVE BAFFLES

END OF PERMIT SIGNED  
AND RETURNED 8/7/89  
Serial # 28099

**\*INSTALLER IS RESPONSIBLE FOR OBTAINING FINAL APPROVAL ON THIS PERMIT**

\*CALL 461-9933 FOR INSPECTION OF SEPTIC SYSTEMS.

*2 car garage*

*PH 803*

# HOWARD COUNTY HEALTH DEPARTMENT

JOYCE M. BOYD, M.D., M.P.H.  
COUNTY HEALTH OFFICER



Bureau of Environmental Health  
3525 Ellicott Mills Drive  
Ellicott City, Maryland 21043

Director - 461-9956  
Water & Sewerage, Permits - 461-9933  
Community Environmental Health - 461-9944  
Technical Services - 461-9955

July 25, 1989

Mr. Bernard Heidelberg, III  
7036 Mink Hollow Road  
Clarksville, Maryland 21025

RE: Building Permit Application  
Serial No. 28099  
Proposed Garage  
7036 Mink Hollow Road

Dear Mr. Heidelberg:

This is to advise that this office cannot recommend approval of the above referenced building permit application at this time.

The proposed garage location conflicts with area needed for future septic repair.

Please contact me at this office (461-9933) to discuss possible remedies to this problem.

Thank you.

Very truly yours,

A handwritten signature in cursive script that reads "Craig Williams".

Craig Williams, Director  
Water and Sewerage Program


CW:JR

cc: Ms. Avis Corbin, Chief  
Bureau of Licenses and Permits


Mr. James Adair  
File

7036 MINK HOLLOW ROAD  
 CLARKSVILLE, MARYLAND

7-17-89 Pump tank  
 and well as shown  
 on plat. Stop work  
 order on garage  
 foundation.  $\frac{1}{2}$  structure.  
 Could not see any  
 problem w/ trench.  
 Garage may be  
 on part of  
 repair area.  
 JENadeau

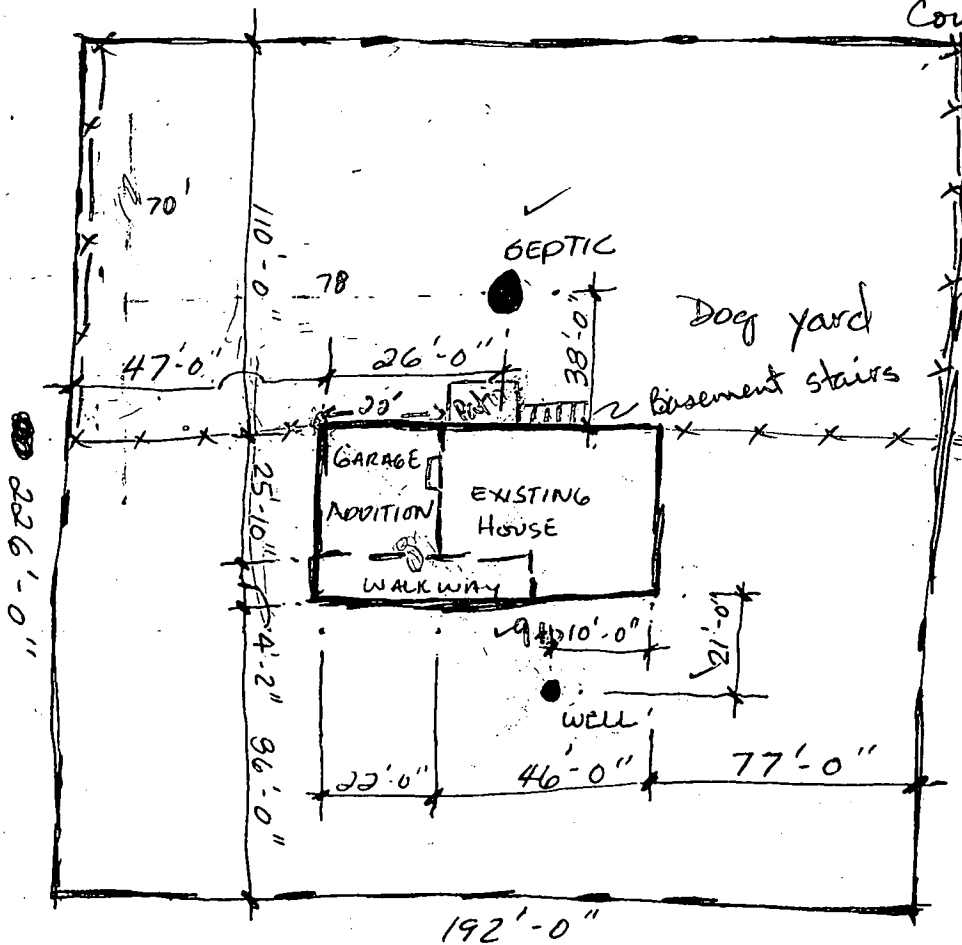

21  
 38  
 30  
 89

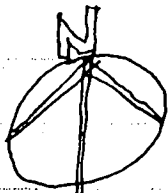

MINK Hollow ROAD

13791 Highland Road, Zepp Property - Lot 4

8/14/87

Sight eval. to issue temporary deviation revealed

1) well in the middle of horse field - unprotected  
w/ plenty of evidence of manure / contamination

Results of H<sub>2</sub>O sample(s) +

2) C/O on septic not properly fitting.

Deviation OK'd pending correction to these matters

8/27/87

Follow up check up (no one home)

1) still no fence around well - horses still present in field

2) C/O on septic - dirt now filled in around cap.  
Not sure if properly fitting, looks to be same cap as was at initial visit

11/30/87 (B)

CAPSD11 5.42 AC

$N10^{\circ}19'17''E \cdot 245.15'$

JOSEPH R. BRUNG  
707/530  
5.865 AC+

ZEPP 8.44 AC

WELL PERMIT #  
HO-73-1744

EXISTING  
WELL 300' DEEP

$S73^{\circ}06'54''E$   
 $163.91'$

$S74^{\circ}39'06''E$   
 $181.00'$

EXISTING  
DRYWELL  
EXISTING  
SEPTIC

FF 22  
BASE 14  
9'  
NEW HOUSE  
WILL BE  
CONSTRUCTED  
ON EXISTING  
FOOTINGS

ok to dig  
8/80  
DI #10004  
2-11-87

$S30^{\circ}52''$   
 $24.87'$

13791 HIGHLAND RD.  
LOT 4  
PARCEL 334 BLOCK 2  
ZONE R ZONE MAP 34  
FIFTH ELECTION DISTRICT

$S30^{\circ}$   
 $28.00'$

7521/545  
83/43A  
P 292

J.E.  
K.R.