

MARYLAND DEPARTMENT OF THE ENVIRONMENT, WATER MANAGEMENT ADMINISTRATION
 1800 Washington Blvd., Baltimore, Maryland 21230 (410) 537-3784

 WATER WELL ABANDONMENT-SEALING REPORT FORM

SUBMIT COPIES OF COMPLETED FORM TO:

- * COUNTY ENVIRONMENT AGENCY (contact MDE, WMA if address needed)
- * WELL OWNER
- * MDE, WATER MANAGEMENT ADMINISTRATION, WELL PROGRAM

DATE WELL ABANDONED: MARCH 24-2011 (month/day/year)

* PERMIT NUMBER OF ABANDONED WELL (if any) NONE

NONE

* PERMIT NUMBER OF REPLACEMENT WELL NONE

NONE

* PERSON ABANDONING WELL: RONALD BYRER


WELL DRILLERS LICENSE NUMBER: 296

CIRCLE: MWD/MSD/MGD

* OWNER'S NAME: JAMES FERGUSON

SITE LOCATION MAP

* WELL LOCATION:
 COUNTY: HOWARD
 NEAREST TOWN: GIBSON
 TAX MAP _____ BLOCK _____ PARCEL _____
 SUBDIVISION: _____
 SECTION: _____ LOT: _____
 NEAREST ROAD: 16130 FREDERICK RD

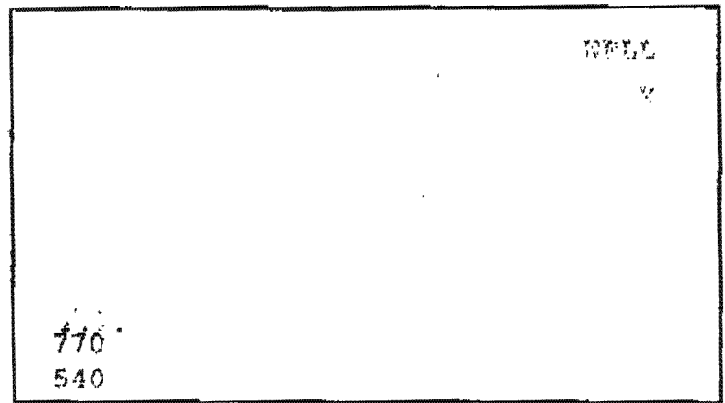

* TYPE OF WELL BEING ABANDONED:

- DRILLED JETTED
- BORED/AUGERED HAND DUG
- OTHER (specify) _____

LOG OF SEALING MATERIAL

MATERIAL	FEET	
	FROM	TO
CONCRETE	0	101
VOLUME OF MATERIAL USED		

* USE CODE:

- DOMESTIC MUNICIPAL/PUBLIC
- IRRIGATION INDUSTRIAL
- TEST/OBSERVATION GEOTHERMAL

* TYPE OF CASING:

- STEEL PLASTIC
- CONCRETE OTHER (specify) _____

* SIZE OF CASING: 6 INCHES IN DIAMETER

* DEPTH OF WELL: 101 FEET DEEP

* WAS ANY CASING REMOVED? YES NO
 If yes, length removed, in feet: _____

* WAS CASING RIPPED OR PERFORATED? YES NO

Ronald Byrer
 SIGNATURE - MASTER WELL DRILLER OR SUPERVISING SANITARIAN
 DENV 828 JULY 1997

296 LICENSE # MWD/MSD/MGD CIRCLE ONE 3-24-11 DATE

2) COUNTY ENVIRONMENTAL AGENCY
 WESTMINSTERWELLDRIILL