

PRELIMINARY -

APPLICATION

19478

SEWAGE DISPOSAL TESTING

STATE OF MARYLAND - DEPARTMENT OF HEALTH AND MENTAL HYGIENE

HOWARD COUNTY HEALTH DEPARTMENT
ENVIRONMENTAL HEALTH SERVICES
P. O. BOX 476, ELLICOTT CITY, MARYLAND 21043
TELEPHONE: 465-5000, EXT. 386

P _____

DISTRICT 5th

DATE 1/29/73

TO: THE COUNTY HEALTH OFFICER
ELLICOTT CITY, MARYLAND

I, HEREBY, APPLY FOR THE NECESSARY TEST IN ORDER TO CONSTRUCT (OR RECONSTRUCT) A SEWAGE DISPOSAL SYSTEM.

PROPERTY OWNER Russell B. Zepp

ADDRESS Highland Road, Clarksville, Maryland PHONE 286-2797

PROPERTY LOCATION:

SUBDIVISION _____ LOT NO. #4

ROAD AND DESCRIPTION Highland Road - Macadam
Corner of Highland Road and Triadelphia Mill Road

SIZE OF LOT 5.865 Acres TYPE BLDG. 3 or 4 bedrooms
NUMBER OF BEDROOMS

IF NOT SINGLE RESIDENCE DESCRIBE _____

THE SYSTEM INSTALLED UNDER THIS APPLICATION IS ACCEPTABLE ONLY UNTIL PUBLIC FACILITIES BECOME AVAILABLE.

SIGNATURE OF APPLICANT _____

APPROVED BY _____ FOR _____ DATE _____
(KIND OF SYSTEM)

REJECTED BY _____ FOR _____ DATE _____
(KIND OF SYSTEM)

HOLD PENDING FURTHER TESTS _____ DATE _____


REASONS FOR REJECTION OR HOLDING _____

THIS IS NOT A PERMIT

857-2

243'

-VALLEY

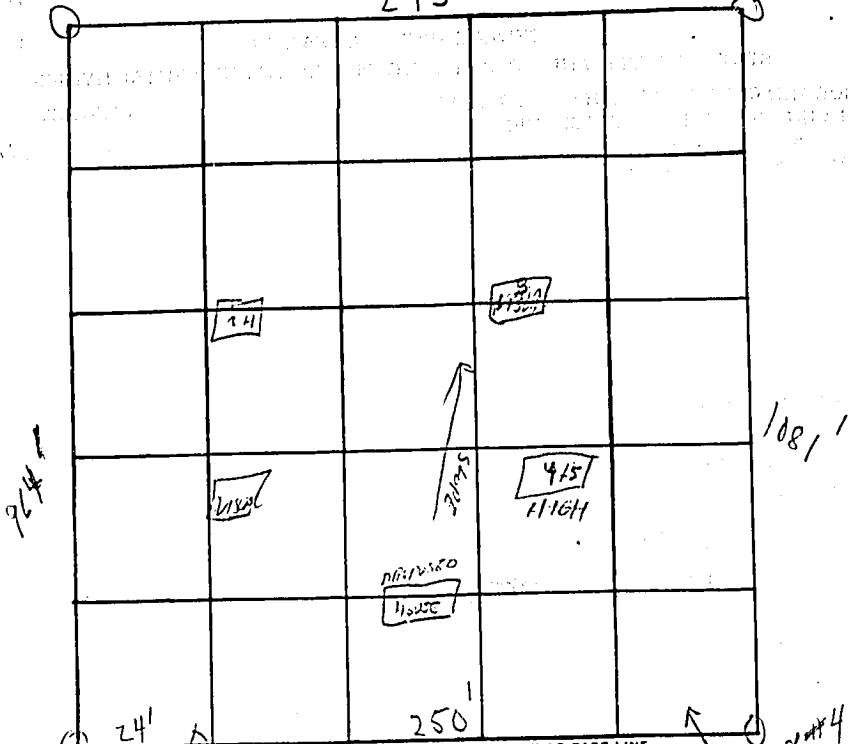

INDICATE NORTH - NAME ADJOINING ROADWAY AS BASE LINE

Highland Rd

DATE	TEST NO.	DEPTH	PRE-WET		TEST - 1" DROP		TIME
			START	STOP	START	STOP	
3/5/74	1	11'	10:30	10:32	10:37	10:36	4 MIN
	2	4'	10:30	10:32	10:37	10:37	4 MIN
	3	11'	Vertical similar to		142		
	4	12'	10:35	10:37	10:37	10:40	3 MIN
	5	4'	10:35	10:40	10:40	10:41	6 MIN
	6	11'	Vertical similar to		445		

REMARKS

Certain holes

TYPE OF SOIL

11

4

5

5 MIN
SUL