
WATER WELL ABANDONMENT-SEALING REPORT FORM

SUBMIT COPIES OF COMPLETED FORM TO:

- * COUNTY ENVIRONMENTAL AGENCY (contact MDE, WMA if address needed)
- * WELL OWNER
- * MDE, WATER MANAGEMENT ADMINISTRATION, WELL PROGRAM

OK
8/12/16 SC

DATE WELL ABANDONED: 12-12-12 (month/day/year)

* PERMIT NUMBER OF ABANDONED WELL (if any) _____

* PERMIT NUMBER OF REPLACEMENT WELL: _____

* PERSON ABANDONING WELL: Allen Compton WELL DRILLER'S LICENSE NUMBER: 009

CIRCLE: MWD / MSD / MGD

* OWNER'S NAME: Schooley Mill Baker, LLC

* WELL LOCATION:
COUNTY: Howard

SITE LOCATION MAP


NEAREST TOWN: Highland

TAX MAP 0040 BLOCK 0010 PARCEL 0115

SUBDIVISION: Schooley Mill Farm

SECTION: _____ LOT: 7

STREET ADDRESS: 12889A Hall Shop rd

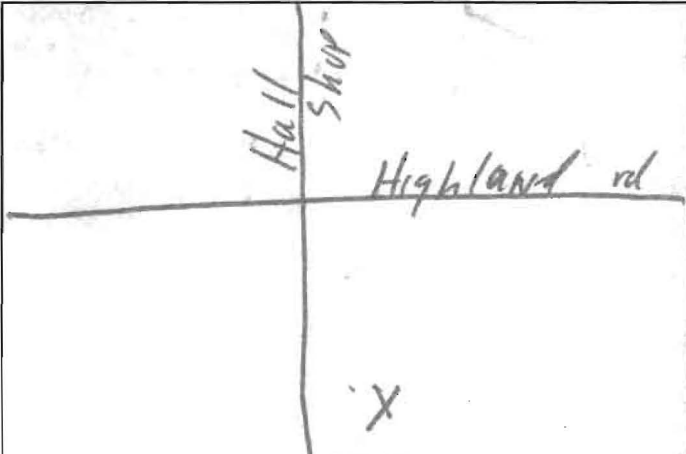

LATITUDE 3 9.1687469

LONGITUDE 7 6.9569168

Allen Compton

* TYPE OF WELL BEING ABANDONED:
 DRILLED JETTED
 BORED HAND DUG
 OTHER (specify) _____

LOG OF SEALING MATERIAL

* USE CODE: DOMESTIC MUNICIPAL/PUBLIC
 IRRIGATION INDUSTRIAL
 TEST/OBSERVATION GEOTHERMAL

MATERIAL	FEET	
	FROM	TO
<u>CEMENT</u>	<u>4</u>	<u>61</u>

* TYPE OF CASING:
 STEEL PLASTIC
 CONCRETE OTHER (specify) _____

SIZE OF CASING: 4" INCHES IN DIAMETER

DEPTH OF WELL: 61' FEET DEEP

WAS ANY CASING REMOVED? YES NO
If yes, length removed, in feet: _____

WAS CASING RIPPED OR PERFORATED? YES NO

VOLUME OF MATERIAL USED

1 yard

