

\*\*\*\*\*  
 WATER WELL ABANDONMENT-SEALING REPORT FORM  
 \*\*\*\*\*

SUBMIT COPIES OF COMPLETED FORM TO:

- \* COUNTY ENVIRONMENTAL AGENCY (contact MDE, WMA if address needed)
- \* WELL OWNER
- \* MDE, WATER MANAGEMENT ADMINISTRATION, WELL PROGRAM

OK  
 8/12/16 SC

DATE WELL ABANDONED: 12-12-12 (month/day/year)

\* PERMIT NUMBER OF ABANDONED WELL (if any) \_\_\_\_\_


\* PERMIT NUMBER OF REPLACEMENT WELL: \_\_\_\_\_

\* PERSON ABANDONING WELL: Allen Compton WELL DRILLER'S LICENSE NUMBER: 009  
 CIRCLE: MWD / MSD / MGD

\* OWNER'S NAME: Schooley Mill Baker, LLC

\* WELL LOCATION:  
 COUNTY: Howard  
 NEAREST TOWN: Highland  
 TAX MAP 0040 BLOCK 0010 PARCEL 0115  
 SUBDIVISION: Schooley Mill Farm  
 SECTION: \_\_\_\_\_ LOT: \_\_\_\_\_  
 STREET ADDRESS: 1288 1288 38 Hall Shop rd

SITE LOCATION MAP

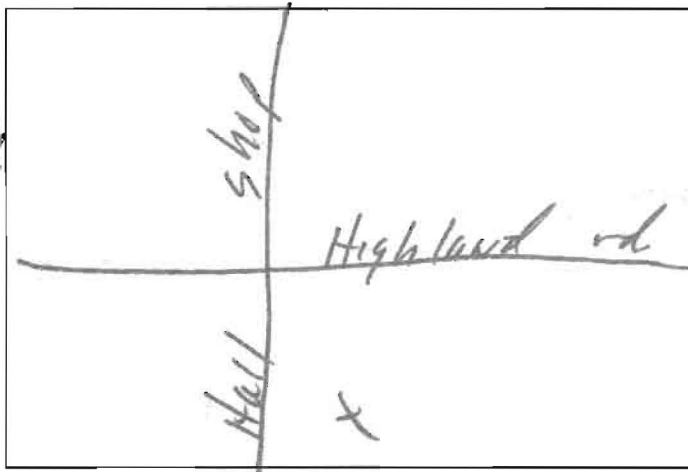

LATITUDE 3 9. 17 0 1 9 6 5

LONGITUDE 7 6. 9 5 8 4 1 9 8

Allen Compton

\* TYPE OF WELL BEING ABANDONED:  
 DRILLED  JETTED  
 BORED  HAND DUG  
 OTHER (specify) \_\_\_\_\_

LOG OF SEALING MATERIAL

\* USE CODE: DOMESTIC  IRRIGATION  MUNICIPAL/PUBLIC  
 TEST/OBSERVATION  INDUSTRIAL  
 \_\_\_\_\_  GEOTHERMAL

\* TYPE OF CASING:  
 STEEL  PLASTIC  
 CONCRETE  OTHER (specify) \_\_\_\_\_

MATERIAL	FEET	
	FROM	TO
<u>CEMENT</u>	<u>-6</u>	<u>100</u>
VOLUME OF MATERIAL USED		
<u>1.5 yards</u>		

SIZE OF CASING: 6" INCHES IN DIAMETER

DEPTH OF WELL: 100' FEET DEEP

WAS ANY CASING REMOVED?  YES  NO  
 If yes, length removed, in feet: \_\_\_\_\_

WAS CASING RIPPED OR PERFORATED?  YES  NO

