
 WATER WELL ABANDONMENT-SEALING REPORT FORM

SUBMIT COPIES OF COMPLETED FORM TO:

- * COUNTY ENVIRONMENTAL AGENCY (contact MDE, WMA if address needed)
- * WELL OWNER
- * MDE, WATER MANAGEMENT ADMINISTRATION, WELL PROGRAM

OK
 8/12/16 SC

DATE WELL ABANDONED: 12-12-12 (month/day/year)

* PERMIT NUMBER OF ABANDONED WELL (if any) _____

* PERMIT NUMBER OF REPLACEMENT WELLS: _____


* PERSON ABANDONING WELL: Allen Compton WELL DRILLER'S LICENSE NUMBER: 009

CIRCLE: MWD / MSD / MGD

* OWNER'S NAME: Schooley Mill Baker, LLC

* WELL LOCATION:
 COUNTY: Howard
 NEAREST TOWN: Highland
 TAX MAP 0040 BLOCK 0011 PARCEL 0149
 SUBDIVISION: Schooley Mill Farm
 SECTION: _____ LOT: 1
 STREET ADDRESS: 12835 Hall Shop rd.

SITE LOCATION MAP

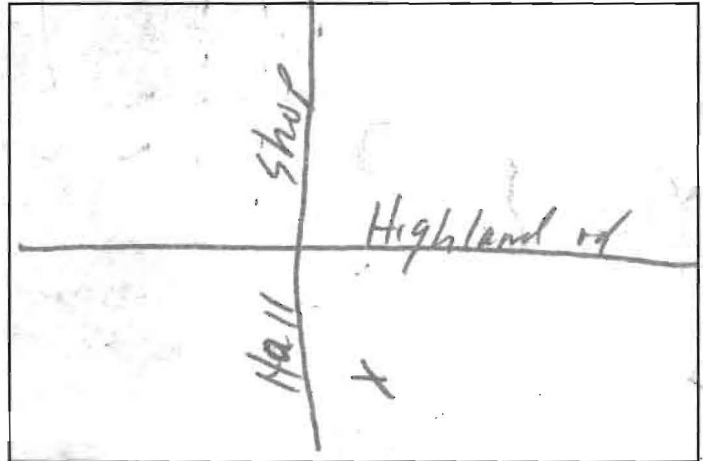

LATITUDE 3 9.1707458

LONGITUDE 7 6.9568329

Allen Compton

* TYPE OF WELL BEING ABANDONED:

- DRILLED JETTED
- BORED HAND DUG
- OTHER (specify) _____

* USE CODE: DOMESTIC

- IRRIGATION MUNICIPAL/PUBLIC
- TEST/OBSERVATION INDUSTRIAL
- _____ GEOTHERMAL

* TYPE OF CASING:

- STEEL PLASTIC
- CONCRETE OTHER (specify) Terra cotta

SIZE OF CASING: 6" INCHES IN DIAMETER

DEPTH OF WELL: 62' FEET DEEP

WAS ANY CASING REMOVED? YES NO

If yes, length removed, in feet: _____

WAS CASING RIPPED OR PERFORATED? YES NO

LOG OF SEALING MATERIAL

MATERIAL	FEET	
	FROM	TO
<u>CEMENT</u>	<u>-6</u>	<u>62</u>
VOLUME OF MATERIAL USED		
<u>1 yard</u>		

