

app 12-10-71
DWM

12/9/71
parted 012

12/10/71
around 10:30
to 11 am

INDEXED

PERMIT

SEWAGE DISPOSAL SYSTEM

MARYLAND STATE DEPARTMENT OF HEALTH

HOWARD COUNTY

ELLCOTT CITY

DISTRICT 5

DATE 12/7/71

P 16549

A _____

Jack Fyock IS PERMITTED TO INSTALL ALTER X

ADDRESS Ten Oaks Road, Glenelg, Md. PHONE 286-2636

A SEWAGE DISPOSAL SYSTEM LOCATED AT _____

SUBDIVISION _____ ROAD 7036 Mink Hollow Rd LOT

PROPERTY OWNER Joseph Bruno 531-5484

ADDRESS _____

SPECIFICATIONS

DRAIN FIELD _____ DEPTH _____ FEET, BOTTOM AREA _____ SQ. FT.

SEEPAGE PITS _____ ABSORBENT SIDE-WALL AREA _____ SQ. FT.

SEPTIC TANK CAPACITY _____ GALLONS

FOR GARBAGE GRINDER, INCREASE DISPOSAL AREA 22% & TANK CAPACITY 50%.

OTHER REPAIR - Call for inspection when ground is opened up and Sanitarian will recommend repair system.

12-9-71 - trench 70 ft long 2 ft wide - 66 7/8 deep - 5 ft of gravel under pipe. Pump to be installed with water proofed pump pit
DWM

PLANS APPROVED BY Palmer F. Wine DATE 12/7/71


FILL SEPTIC TANK AND DISTRIBUTION BOX WITH WATER BEFORE CALLING FOR AN INSPECTION. COVER NO WORK UNTIL INSPECTED AND APPROVED.

NEITHER THE HOWARD COUNTY COMMISSIONERS NOR THE HEALTH DEPARTMENT IS RESPONSIBLE FOR THE SUCCESSFUL OPERATION OF ANY SYSTEM.

70
5
350 ft total

16549

15 11
BT 11

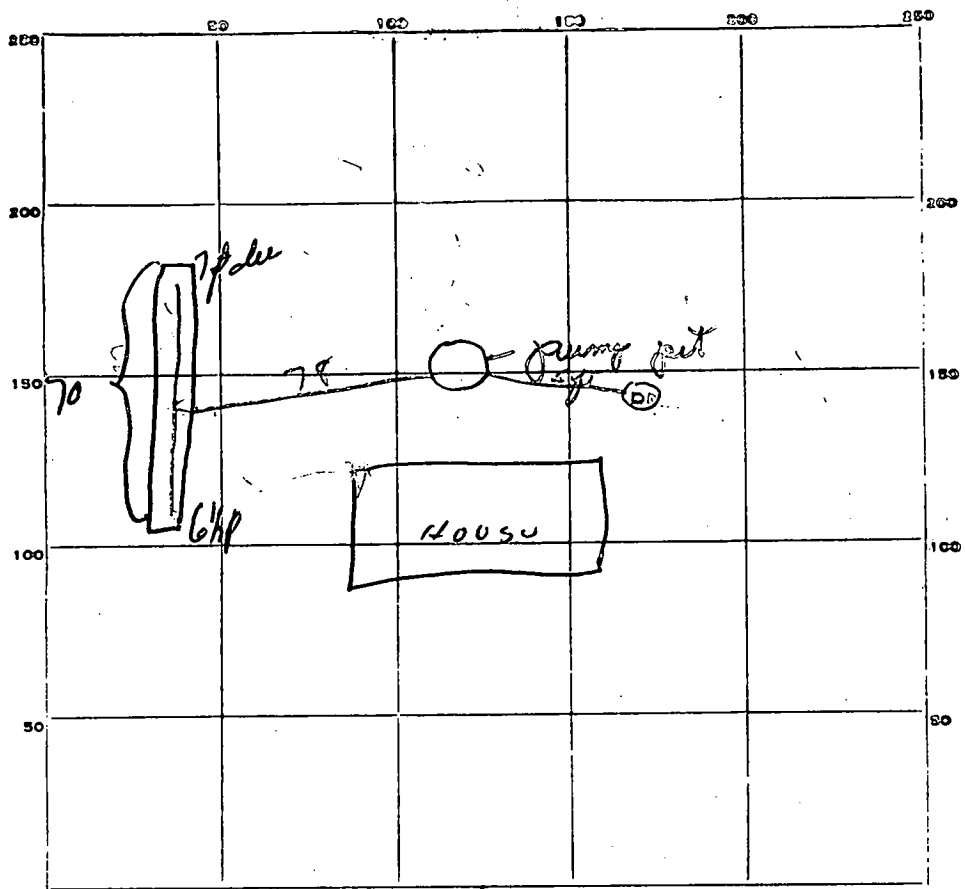

INDICATE NORTH - NAME ADJOINING ROADWAY AS BASE LINE.

Milk Hollow Rd

PERMIT CARD OK

SEPTIC TANK, LEVEL _____ CLEANOUTS _____

DISTRIBUTION BOX, LEVEL _____

TILE FIELD, DEPTH _____ FT. TRENCH WIDTH _____ FT.

GRAVEL DEPTH _____ IN. TOTAL LENGTH _____ FT.

NUMBER OF TRENCHES _____ TOTAL BOTTOM AREA _____

SEEPAGE PITS, INSIDE DIAMETER _____ FT. DEPTH BELOW INLET _____ FT.

ABSORBENT AREA _____ SQ. FT.

REMARKS *AM 12-9-71 - OK to put gravel in trench*
PM 12-9-71 - OK to cover trench - call for final insip
when pump pit etc is ready DWm

DATE SYSTEM APPROVED 12-10-71

INSPECTOR *DW Monaghan*