

3/1/77
3/5/77

PERMIT

P 25268
A 19478

SEWAGE DISPOSAL SYSTEM

MARYLAND STATE DEPARTMENT OF HEALTH

HOWARD COUNTY

Approved
HB
3-15-77

ELLICOTT CITY

DISTRICT 5th

DATE 2/23/77

INDEXED

Jack Fyock

IS PERMITTED TO INSTALL ALTER

ADDRESS 13775 Triadelphia Road, Glenelg, MD, PHONE 988-9270

A SEWAGE DISPOSAL SYSTEM LOCATED AT

SUBDIVISION ROAD Highland Road-Macadam LOT 4

PROPERTY OWNER Joseph Bruno

ADDRESS 7036 Mink Hollow Road, Highland, MD. 20777

SPECIFICATIONS 4 bedrooms

DRAIN FIELD _____ DEPTH _____ FEET, BOTTOM AREA _____ SQ. FT.

SEEPAGE PITS _____ ABSORBENT SIDE-WALL AREA _____ SQ. FT.

SEPTIC TANK CAPACITY 1250 GALLONS

FOR GARBAGE GRINDER, INCREASE DISPOSAL AREA 22% & TANK CAPACITY 50%.

OTHER DRY WELL-to have 115 sq. feet effective absorbent sidewall area per bedroom below inlet. Inlet to be 4 feet below original grade and maximum depth of 12 feet. Location to be 328 feet from front property line and 118 feet from left property when facing lot from Highland Road.

NOTE: ALL PIPE FROM HOUSE TO DISPOSAL AREA MUST BE CAST IRON. PERMIT VOID AFTER THREE YEARS.


NOTE: INSTALL STAND PIPE ON SEPTIC TANK AND DRY WELL. STAND PIPES MUST BE 6 INCHES IN DIAMETER. CAST IRON, CONCRETE OR TERRA COTTA ACCEPTED.

PLANS APPROVED BY Harry J. Zbar DATE 3/22/74

FILL SEPTIC TANK AND DISTRIBUTION BOX WITH WATER BEFORE CALLING FOR AN INSPECTION. COVER NO WORK UNTIL INSPECTED AND APPROVED.

NEITHER THE HOWARD COUNTY COMMISSIONERS NOR THE HEALTH DEPARTMENT IS RESPONSIBLE FOR THE SUCCESSFUL OPERATION OF ANY SYSTEM.

19478

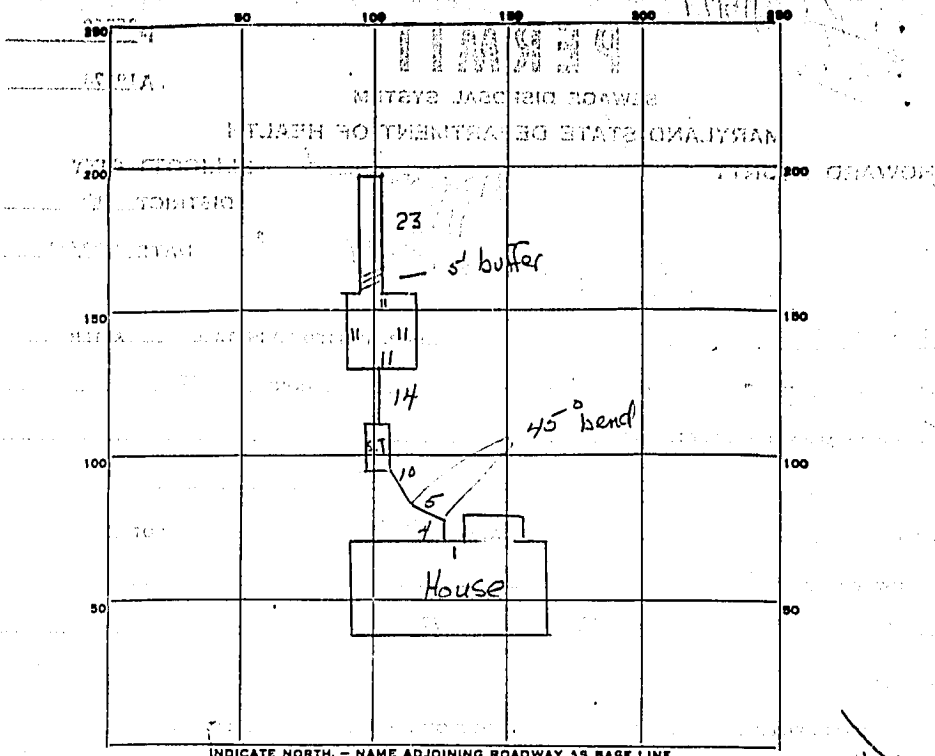

INDICATE NORTH - NAME ADJOINING ROADWAY AS BASE LINE.

Highland Bay ST DW

PERMIT CARD not soon

SEPTIC TANK, LEVEL 1250

ST	DW
yes	yes

DISTRIBUTION BOX, LEVEL _____

TILE FIELD, DEPTH 12 FT. TRENCH WIDTH 2 FT.

GRAVEL DEPTH 7 IN. TOTAL LENGTH 23 FT.

NUMBER OF TRENCHES 1 TOTAL BOTTOM AREA 161 ^{one side}

SEEPAGE PITS, INSIDE DIAMETER 44 ^{Permit} FT. DEPTH BELOW INLET 7 1/2 FT.

DW = 330 π

Total ABSORBENT AREA 491 SQ. FT.

REMARKS 37-77-ok to cover ST-line from S.T. to DW - DW + Trench - need to see sewer line from house to S.T. HR

DATE SYSTEM APPROVED March 15 '77 INSPECTOR Hal Benson