

THIS PLAT CAN NOT BE USED TO ESTABLISH PROPERTY LINES OR CORNERS.

ONE GLENWOOD ESTATES

496

SECTION D DISTRICT  
TOWNSHIP AND COUNTY, MD

LOT 28

# LOCATION SURVEY PLAT

## CERTIFICATION

This is to certify that I have surveyed the property known as:  
1429 MUSTANG PATH  
for the purpose of locating the improvements thereon, and the improvements are located as shown.

## SEAL




*Walter Park*

PHONE 828-9060 TOWSON  
828-9060 COLUMBIA

HUDKINS ASSOCIATES, INC.  
Surveyors and Subdivision Designers

SUITE 231, JOSEPH SQUARE  
5485 HARPERS FARM ROAD  
COLUMBIA, MARYLAND 21044  
#5539

SCALE 1"=100' DATE 4-28-1986

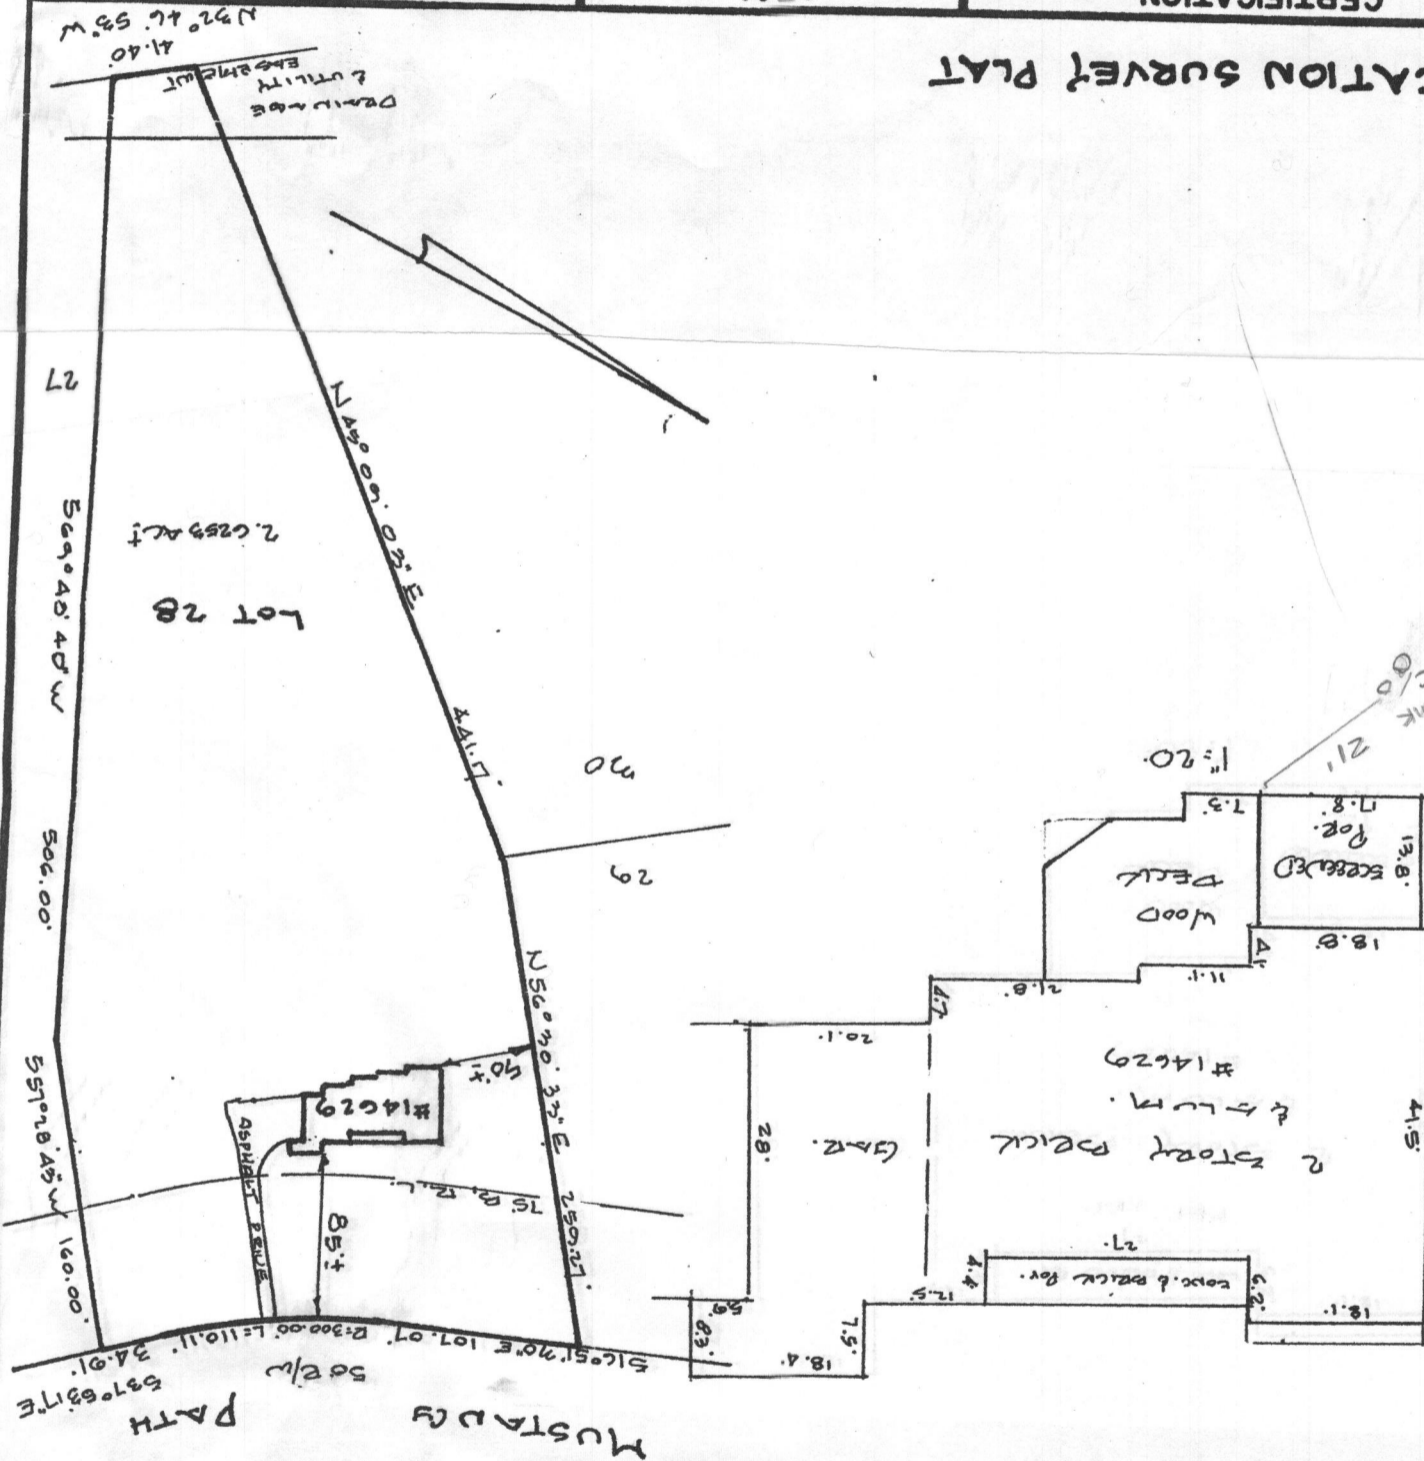

Bank C/O  
21'