



Bureau of Environmental Health

8930 Stanford Blvd, Columbia, MD 21045
Main: 410-313-2640 | Fax: 410-313-2648
TDD 410-313-2323 | Toll Free 1-866-313-6300
www.hchealth.org

Maura J. Rossman, M.D., Health Officer

MEMORANDUM

TO: David Woessner
(sent to dwoessner@bohlereng.com on 9/1/16)

FROM: Sarah Collins, L.E.H.S. SEC
Howard County Health Department
Well and Septic Program

DATE: September 1, 2016

RE: **10778 Frederick Road**
Ellicott City, MD 21042
Map 16, Grid 23, Parcel 17
(Demolition of existing structure)

This is to advise that the Howard County Health Department recommends issuance of the demolition permit for the above referenced property.

The property was served by a drilled well, #HO-73-3577. Fogle's Well Drilling abandoned the well on 8/18/16. The Health Department received documentation describing the well abandonment.

The property had septic system. Fogle's Septic and Portables abandoned the tank on 8/19/16. The Health Department received documentation describing the septic abandonment.

Future buildings on the property will be served by public water and sewer per Howard County regulations.

IF ANY ADDITIONAL WELL OR SEPTIC COMPONENTS ARE FOUND DURING SITE WORK, PLEASE NOTIFY THE HOWARD COUNTY HEALTH DEPARTMENT IMMEDIATELY.

Cc: File



Howard County Health Department

ATTENTION KEVIN WOLF

Bureau of Environmental Health
7178 Gateway Drive Columbia, MD 21046
(410) 313-2640 Fax (410) 313-2648
TDD (410) 313-2323 Toll Free 1-866-313-6300
website: www.hchealth.org

Dr. Peter Beilenson, M.D., M.P.H., Health Officer

DEMOLITION REQUEST FORM

(Please fill in all blanks)

Information of Property to be Demolished:

DAVID WRESSNER

Current Owner's Name

10778 FREDERICK ROAD

Property Address

TERRY'S PLACE

Subdivision (if applicable)

2

Lot #

JOHN COOK

All Prior Owners' Names (if requested or known)

16

Tax Map

17

Parcel #

02-275511

Tax ID #

SUBDIVISION REQUIRES DEMOLITION OF EXISTING HOUSE

Purpose/Reason for Demolition

RE BUILD NEW HOUSE ON PUBLIC WATERSEWER

Future plans of property after demo (i.e. subdivision, parking lot, re-build new house, etc...)

If a subdivision, SDP# 16-062

Has the structure(s) been deemed unsafe by DILP YES NO

UTILITY RECORDS:

Property currently connected to public water YES NO

WATER AND SEWER CONNECTIONS AVAILABLE, BUT NOT CONNECTED

Property currently connected to public sewer YES NO

Does the property currently have any wells and/or septic systems YES NO

Explain: THERE IS A WELL AND SEPTIC SYSTEM SERVING THE HOUSE I NEED TO ABANDON THEM.

*Note: Any wells and/or septic systems that are to remain may require an approved percolation certification plan under Howard County Code Sec. 3.805

*Note: Any septic systems that are to be abandoned must be done by a septic contractor with documentation of the process.

*Note: All abandoned wells are to be sealed by a well driller licensed by the Maryland State Board of Well Drillers COMAR Sec 26.04.04.11 Abandonment Standards D (3)

COMMENTS:

DAVID WRESSNER

Applicant's Name (please print)

443 823 3239

Applicant's Phone #

dwoessner@bohlereng.com

Applicant's Email

NONE

Applicant's Fax #

[Signature]

Applicant's Signature

6/16/2016

Date

WATER WELL ABANDONMENT-SEALING REPORT FORM

SUBMIT COPIES OF COMPLETED FORM TO:

- * COUNTY ENVIRONMENTAL AGENCY (contact MDE, WMA if address needed)
- * WELL OWNER
- * MDE, WATER MANAGEMENT ADMINISTRATION, WELL PROGRAM

OK
9/1/16 SC

DATE WELL ABANDONED: 8-18-16 (month/day/year)

* PERMIT NUMBER OF ABANDONED WELL (if any)

HO - 73 - 3577

* PERMIT NUMBER OF REPLACEMENT WELL:


* PERSON ABANDONING WELL: Andrew Houseman WELL DRILLER'S LICENSE NUMBER: 224

CIRCLE: MWD / MSD / MGD

* OWNER'S NAME: David Woessner

SITE LOCATION MAP

* WELL LOCATION:

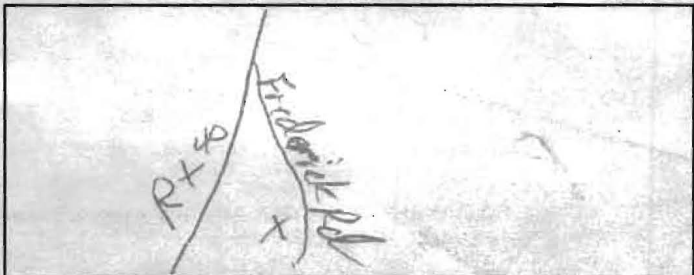

COUNTY: Howard
NEAREST TOWN: Ellicott City
TAX MAP 0016 BLOCK 0023 PARCEL 0017
SUBDIVISION: COOK PROPERTY
SECTION: _____ LOT: _____
STREET ADDRESS: 10778 Frederick Rd.

LATITUDE 3 9.284290

LONGITUDE 7 6.885673

LOG OF SEALING MATERIAL

MATERIAL	FEET	
	FROM	TO
<u>Bentonite</u>	<u>145</u>	<u>0</u>
VOLUME OF MATERIAL USED		
<u>1750/lbs Bentonite</u>		

* TYPE OF WELL BEING ABANDONED:

- DRILLED JETTED
- BORED HAND DUG
- OTHER (specify) _____

* USE CODE:

- DOMESTIC MUNICIPAL/PUBLIC
- IRRIGATION INDUSTRIAL
- TEST/OBSERVATION GEOTHERMAL

* TYPE OF CASING:

- STEEL PLASTIC
- CONCRETE OTHER (specify) _____

SIZE OF CASING: 6 INCHES IN DIAMETER

DEPTH OF WELL: 145 FEET DEEP

WAS ANY CASING REMOVED? YES NO

If yes, length removed, in feet: _____

WAS CASING RIPPED OR PERFORATED? YES NO

Andrew Houseman
SIGNATURE-MASTER WELL DRILLER OR SUPERVISING SANITARIAN LICENSE#

224

MWD / MSD / MGS

CIRCLE ONE

DATE

COUNTY

Pursuant to § 10-624 of the State Govt. Article of the Maryland Code, personal info requested on this form is used in processing this form pursuant to COMAR 26.04.04. Failure to provide the info may result in this form not being processed. You have the right to inspect, amend, or correct this form. The Maryland Department of the Environment is subject to the Maryland Public Information Act. This form may be made available on the Internet via MDE's website and is subject to inspection or copying, in whole or in part, by the public and other governmental agencies, if not protected by federal or State Law.

Fogle's Septic Clean Inc.

Fogle's Portable Toilets • Fogle's Well Drilling LLC • Fogle's Excavating, LLC



August 22, 2016

Howard Co Dept of Environmental Health
8930 Stanford Blvd
Columbia, Md 21045

To Whom it may concern,

On August the 19th 2016 Fogle's Septic Clean Inc, has crushed to abandon the septic tank located at 10778 Frederick Rd in Ellicott City for David Woessner. The system consisted of a 1500 gal 2 compartment concrete tank with a trench, we also crushed in the distribution box. If you have any questions please call me at the office 410-795-5670.

Sincerely,

A handwritten signature in cursive script that reads "Kurt Cassell".

Kurt Cassell
Fogle's Septic Clean, Inc.