



Bureau of Environmental Health

8930 Stanford Blvd, Columbia, MD 21045
Main: 410-313-2640 | Fax: 410-313-2648
TDD 410-313-2323 | Toll Free 1-866-313-6300
www.hchealth.org

Maura J. Rossman, M.D., Health Officer

MEMORANDUM

TO: Howard County Housing
John E. King

FROM: Sarah Collins, L.E.H.S. SEC
Howard County Health Department
Well and Septic Program

DATE: September 1, 2016

RE: **8120 Hicks Road**
Jessup, MD 20794
Map 43, Grid 14, Parcel 491
(Demolition of existing structures at 8120-A, 8210-B, 8210-C)

This is to advise that the Howard County Health Department recommends issuance of the demolition permit for the above referenced property.

The property was connected to public water. There was an old drilled well on the property that L.F. Easterday, Inc. abandoned on 8/26/16. The Health Department received documentation describing the well abandonment.

The property was connected to public sewer. The connection has been capped off.

Future buildings on the property will be served by public water and sewer per Howard County regulations.

IF ANY ADDITIONAL WELL OR SEPTIC COMPONENTS ARE FOUND DURING SITE WORK, PLEASE NOTIFY THE HOWARD COUNTY HEALTH DEPARTMENT IMMEDIATELY.



Bureau of Environmental Health
 7178 Columbia Gateway Drive, Columbia, MD 21046-2147
 Main: 410-313-2640 | Fax: 410-313-2648
 TDD 410-313-2323 | Toll Free 1-866-313-6300
 www.hchealth.org
 Facebook: www.facebook.com/hocohealth
 Twitter: HowardCoHealthDep

Maura J. Rossman, M.D., Health Officer

DEMOLITION REQUEST FORM

(Please fill in all blanks)

Information of Property to be Demolished:

Howard County Housing
 Current Owner's Name

A.B.
8120 Hicks Rd Jessap Md 20794
 Property Address

0000
 Subdivision (if applicable)

19
 Lot #

ARTHUR HICKS JR
 All Prior Owners' Names (if requested or known)

0491
 Tax Map Parcel # Tax ID #

REMOVAL TO MAKE WAY FOR FUTURE NEW HOUSING
 Purpose/Reason for Demolition

FUTURE HOUSING
 Future plans of property after demo (i.e. subdivision, parking lot, re-build new house, etc...)

If a subdivision, SDP# _____ Has the structure(s) been deemed unsafe by DILP YES NO

UTILITY RECORDS:

Property currently connected to public water YES NO

Property currently connected to public sewer YES NO

Does the property currently have any wells and/or septic systems YES NO 1 WELL 8120 B.
 → Explain:

*Note: Any wells and/or septic systems that are to remain may require an approved percolation certification plan under *Howard County Code Sec. 3.805*
 *Note: Any septic systems that are to be abandoned must be done by a septic contractor with documentation of the process.
 *Note: All abandoned wells are to be sealed by a well driller licensed by the Maryland State Board of Well Drillers *COMAR Sec 26.04.04.11 Abandonment Standards D (3)*

COMMENTS:

John E Kijak
 Applicant's Name (please print)

ELL
410-335-0660 443-324-3558
 Applicant's Phone #

John@BARCOENT.COM
 Applicant's Email

410-335-0790
 Applicant's Fax #

John E Kijak
 Applicant's Signature

 Date

 WATER WELL ABANDONMENT-SEALING REPORT FORM

SUBMIT COPIES OF COMPLETED FORM TO:

- * COUNTY ENVIRONMENTAL AGENCY (contact MDE, WMA if address needed)
- * WELL OWNER
- * MDE, WATER MANAGEMENT ADMINISTRATION, WELL PROGRAM

DATE WELL ABANDONED: 8-26-14 (month/day/year)

OK
 8/31/16 SC

* PERMIT NUMBER OF ABANDONED WELL (if any) _____

* PERMIT NUMBER OF REPLACEMENT WELL: _____


* PERSON ABANDONING WELL: George Easterday WELL DRILLER'S LICENSE NUMBER: 040

CIRCLE MWD / MSD / MGD

* OWNER'S NAME: Banco Enterprises

SITE LOCATION MAP

* WELL LOCATION:
 COUNTY: Howard
 NEAREST TOWN: Jessup
 TAX MAP _____ BLOCK _____ PARCEL _____
 SUBDIVISION: _____
 SECTION: _____ LOT: _____
 STREET ADDRESS: 8120-15 Hicks Road

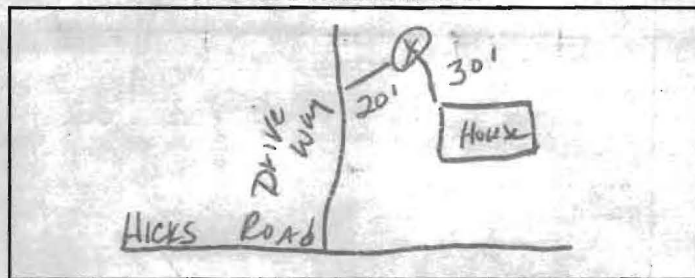

LATITUDE 3 9.166072

LONGITUDE 7 6.791454

LOG OF SEALING MATERIAL

* TYPE OF WELL BEING ABANDONED:
 DRILLED JETTED
 BORED HAND DUG
 OTHER (specify) _____

MATERIAL	FEET	
	FROM	TO
Bentonite	0	62'

* USE CODE:
 DOMESTIC MUNICIPAL/PUBLIC
 IRRIGATION INDUSTRIAL
 TEST/OBSERVATION GEOTHERMAL

VOLUME OF MATERIAL USED

200 # Bentonite as slurry

* TYPE OF CASING:
 STEEL PLASTIC
 CONCRETE OTHER (specify) _____

SIZE OF CASING: 6 INCHES IN DIAMETER

DEPTH OF WELL: 62 FEET DEEP

WAS ANY CASING REMOVED? YES NO
 If yes, length removed, in feet: 1.5

WAS CASING RIPPED OR PERFORATED? YES NO

SIGNATURE-MASTER WELL DRILLER OR SUPERVISING SANITARIAN LICENSE#
George F. Easterday 040

CIRCLE ONE MWD / MSD / MGS 8-26-14
 DATE



Pursuant to § 10-624 of the State Govt. Article of the Maryland Code, personal info requested on this form is used in processing this form pursuant to COMAR 26.04.04. Failure to provide the info may result in this form not being processed. You have the right to inspect, amend, or correct this form. The Maryland Department of the Environment is subject to the Maryland Public Information Act. This form may be made available on the Internet via MDE's website and is subject to inspection or copying, in whole or in part, by the public and other governmental agencies, if not protected by federal or State Law.

8120 Hicks Road
8/31/16 Abandoned well location (red dot)

