

4-12' Loles
Preliminary

APPLICATION

A 19279

SEWAGE DISPOSAL TESTING

P _____

STATE OF MARYLAND - DEPARTMENT OF HEALTH AND MENTAL HYGIENE

HOWARD COUNTY HEALTH DEPARTMENT
ENVIRONMENTAL HEALTH SERVICES
P. O. BOX 476, ELLICOTT CITY, MARYLAND 21043
TELEPHONE: 468-8000, EXT. 356

DISTRICT 5

DATE 11/2/73

4 Br.

*Septic Tank - 1200 gal.
Dry Well - 400 sq ft absorbent sidewall area to begin below the first
6" of orig. grade. Max. depth permitted for DW is 13' below orig. grade.
Place Dry Well 200' from rear lot line and 100' from right side line
as seen when facing from the front.
use 300 sq ft sew - 150 sq ft trench (one inch)*

TO: THE COUNTY HEALTH OFFICER
ELLICOTT CITY, MARYLAND

I, HEREBY, APPLY FOR THE NECESSARY TEST IN ORDER TO CONSTRUCT (OR RECONSTRUCT) A SEWAGE DISPOSAL SYSTEM.

PROPERTY OWNER Richard Hallowell (contract owner) *Glen Drew*

ADDRESS 7131 Mink Hollow Rd, Highland, Md. *7501 Democracy Blvd. Bethesda, Md. 20814*
PHONE _____ *286-2988*

PROPERTY LOCATION:

SUBDIVISION 7077 Mink Hollow Road *Parcel*
LOT NO. 12

ROAD AND DESCRIPTION On E. side of Mink Hollow Rd approximately

400' N. of Gardner Lane.

SIZE OF LOT #12 - - 6.514 acres TYPE BLDG. 4
NUMBER OF BEDROOMS _____

IF NOT SINGLE RESIDENCE DESCRIBE _____

THE SYSTEM INSTALLED UNDER THIS APPLICATION IS ACCEPTABLE ONLY UNTIL PUBLIC FACILITIES BECOME AVAILABLE.

SIGNATURE OF APPLICANT *Richard Hallowell*


APPROVED BY *[Signature]* FOR *Dry Well & Trench* DATE *1-21-74*
(KIND OF SYSTEM)

REJECTED BY _____ FOR _____ DATE _____
(KIND OF SYSTEM)

HOLD PENDING FURTHER TESTS _____ DATE _____

REASONS FOR REJECTION OR HOLDING _____

THIS IS NOT A PERMIT

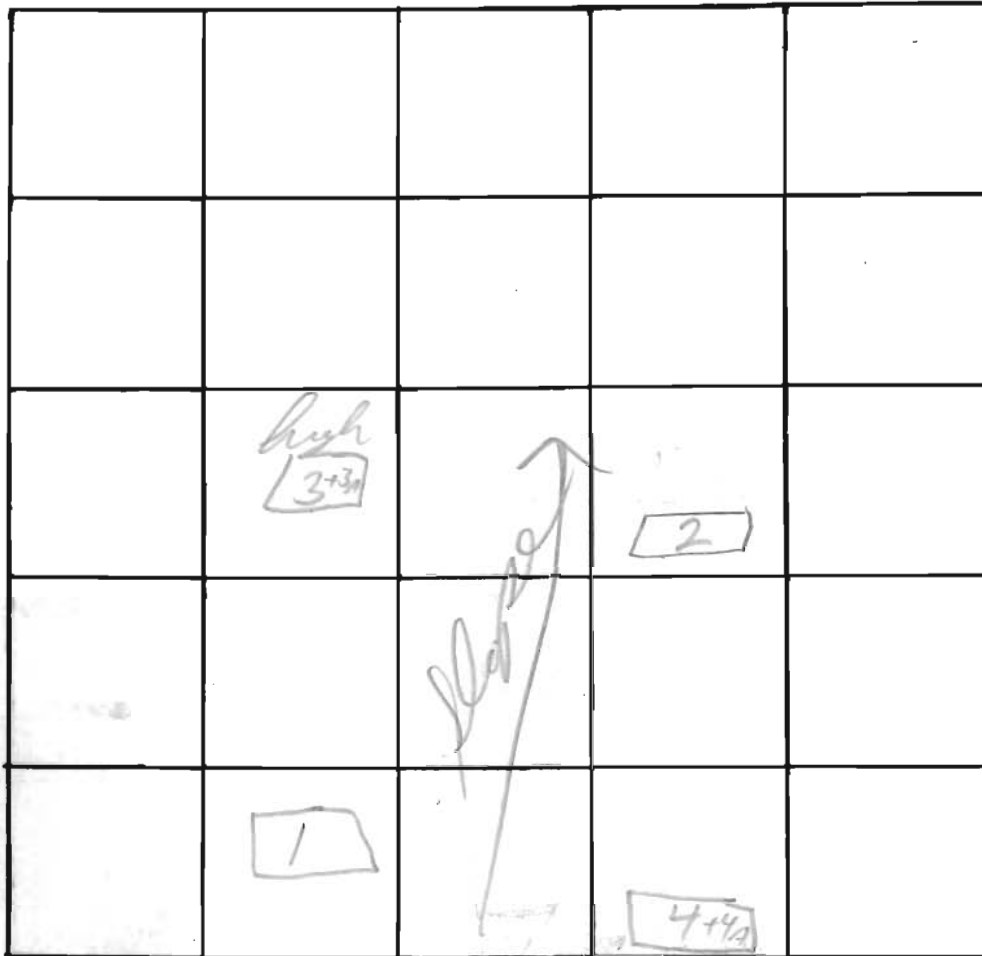


INDICATE NORTH. - NAME ADJOINING ROADWAY AS BASE LINE.

DATE	TEST NO.	DEPTH	PRE-WET		TEST - 1" DROP		TIME
			START	STOP	START	STOP	
	1 VISUAL	12'		OK			
	2	11'		VISUAL		OK	
	3	13'	243	248	248	253	5min
	3A	7'	243	246	246	250	4min
	4	11'	253	257	257	259	2min
	4A	4'	255	300	300	305	5min

REMARKS

Certified Soil

TYPE OF SOIL

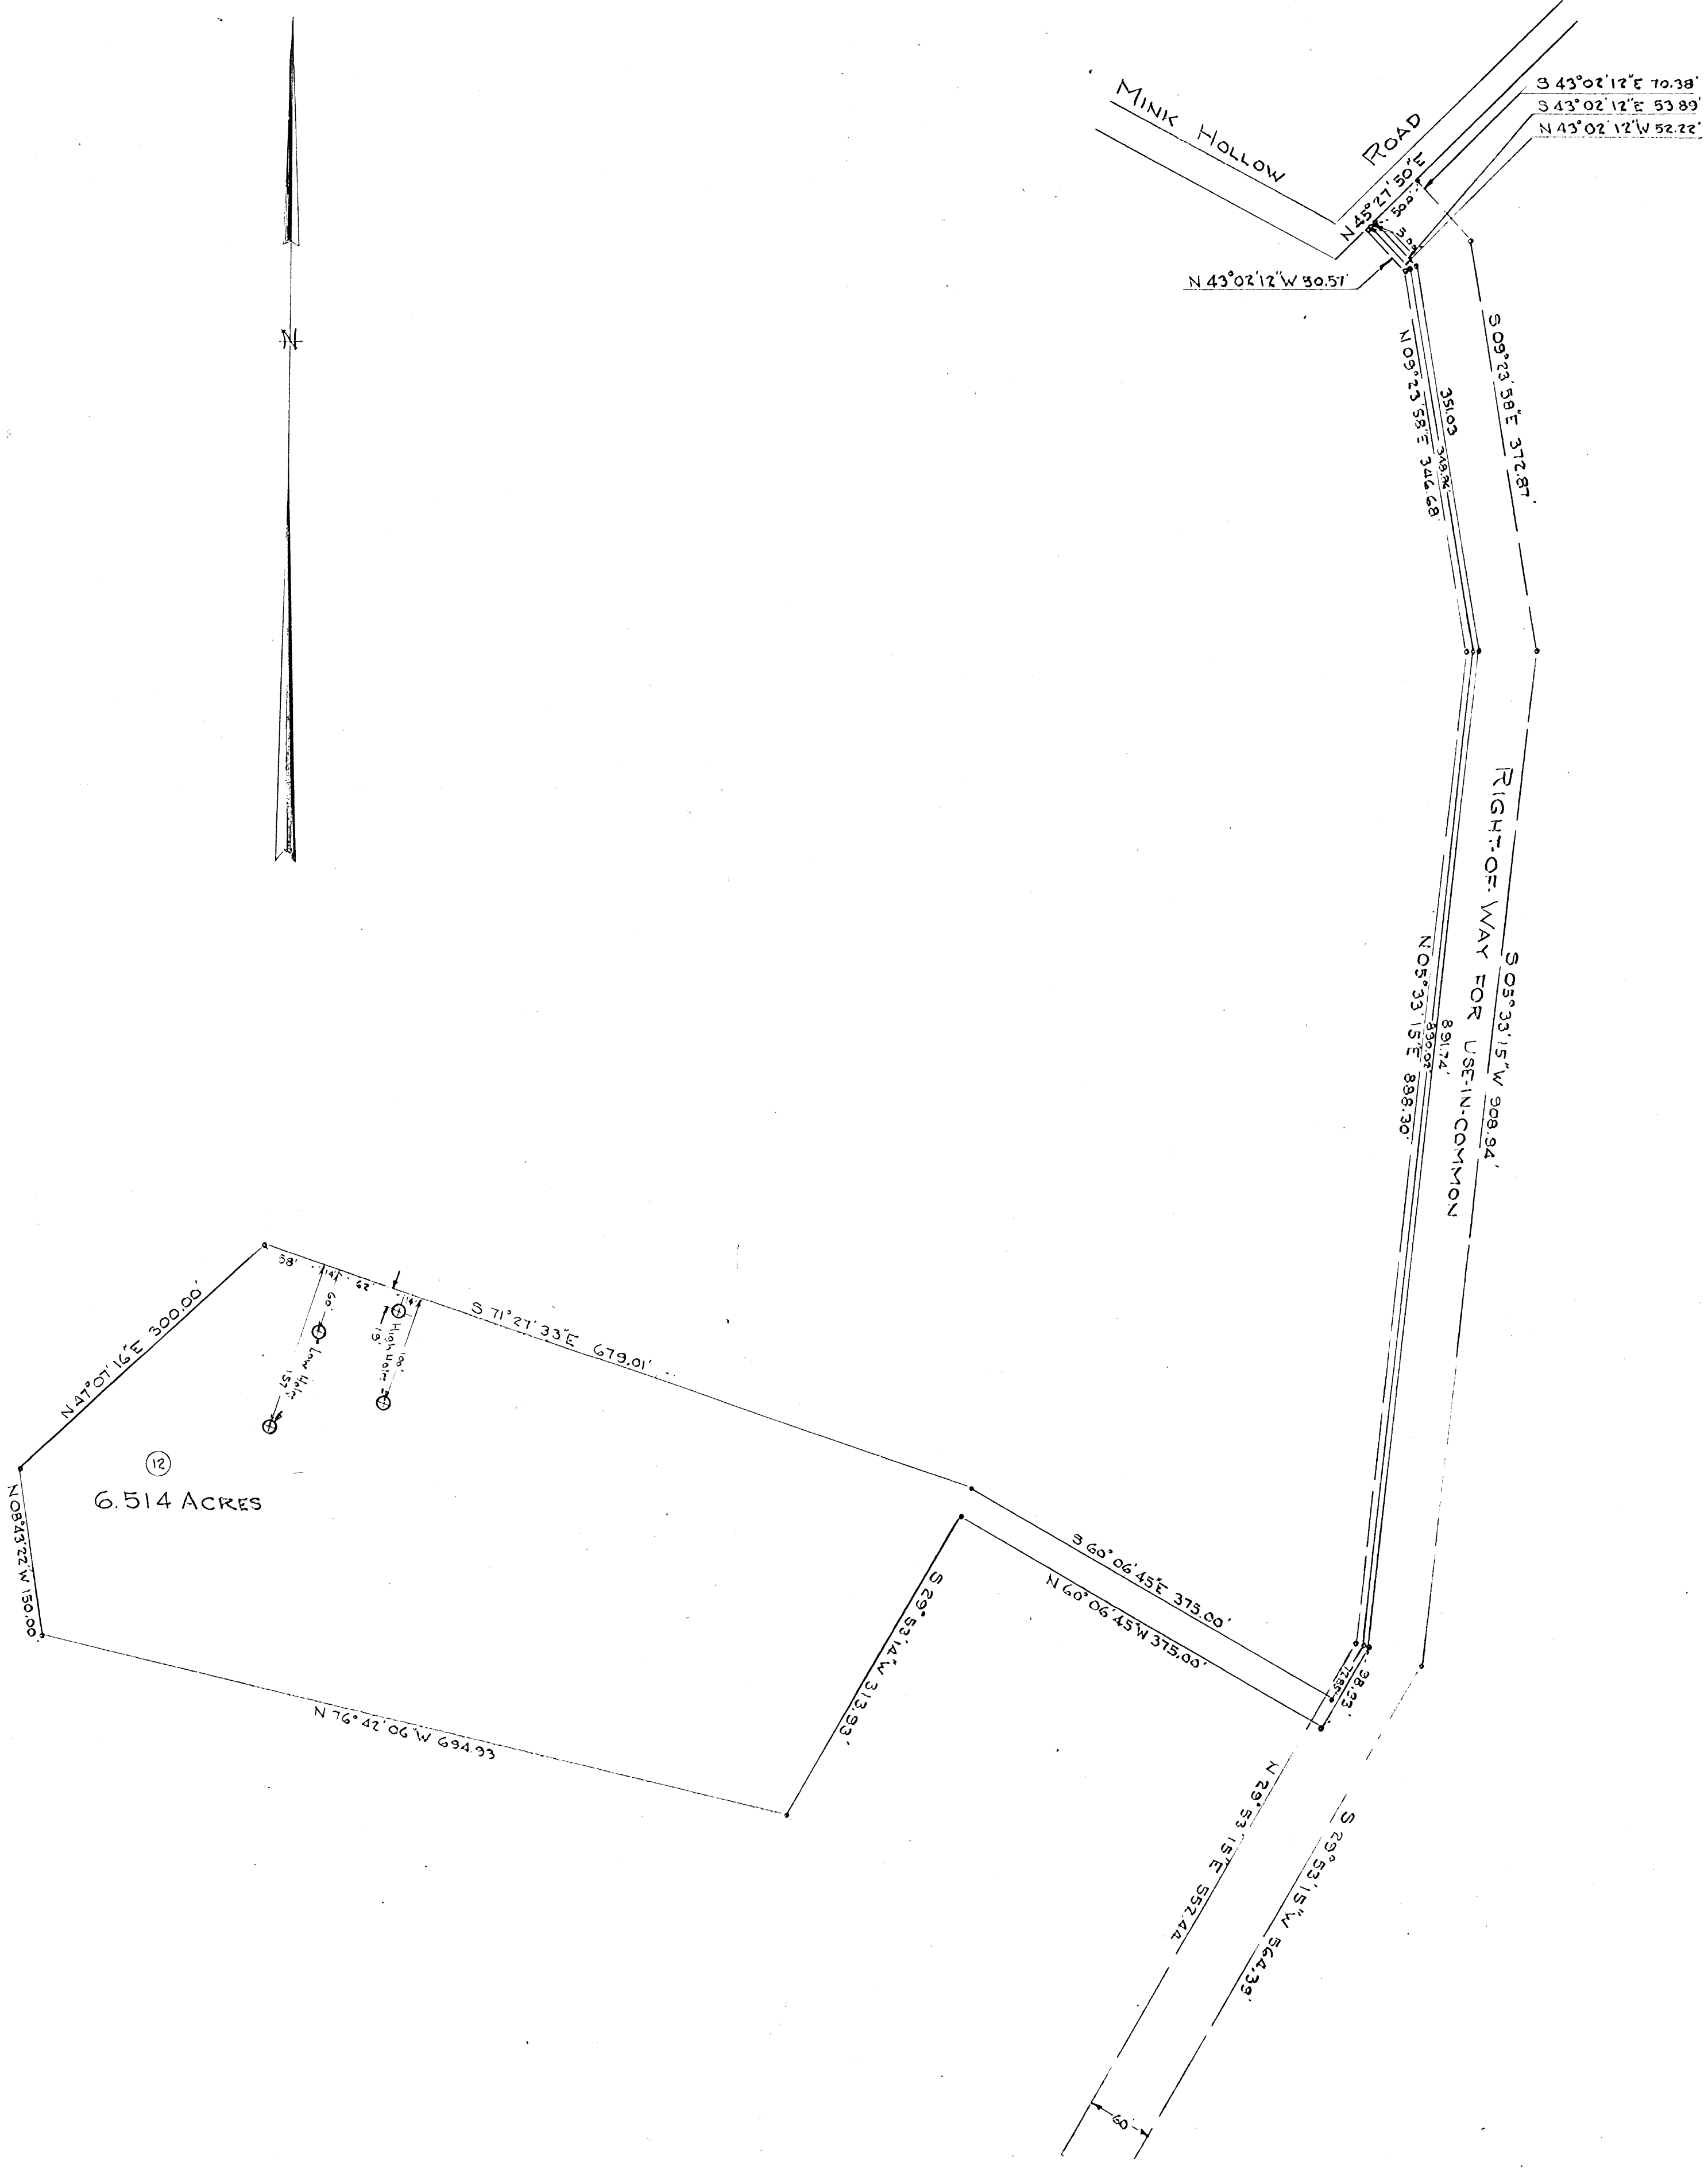

LOCATION SURVEY
 FOR
 HALLOWELL'S ADDITION
 FIFTH ELECTION DISTRICT, HOWARD COUNTY
 HIGHLAND, MARYLAND.
 SCALE: 1 IN. = 100 FT. NOVEMBER 6, 1973.

Note: The lot shown hereon complies with the minimum ownership and lot area as required by the Maryland State Health Department.

Approved: Private Water and Private Sewer
[Signature]
 Howard County Health Officer
 1/13/74
 Date

⊙ Denotes percolation test hole (actual field location)



Charles M. Steunoy