

Bureau of Environmental Health

8930 Stanford Boulevard, Columbia, MD 21045

Main: 410-313-2640 | Fax: 410-313-2648

TDD 410-313-2323 | Toll Free 1-866-313-6300

www.hchealth.org

Facebook: www.facebook.com/hocohealth

Twitter: HowardCoHealthDep

Maura J. Rossman, M.D., Health Officer

APPLICATION FOR PERCOLATION TESTING AND SITE EVALUATION

PROPERTY LOCATION

SUBDIVISION/PROPERTY NAME William Hanlon

PROPERTY ADDRESS 3329 Brantly Rd. Glenwood MD 21738

TAX ACCOUNT # TAX MAP GRID PARCEL LOT NO. PROPOSED LOT SIZE (ACRES)

ZONING CATEGORY TIER

PROPERTY OWNER(S) William Hanlon

DAYTIME PHONE 410 489 4863 CELL EMAIL

MAILING ADDRESS 3329 Brantly Rd. Glenwood MD 21738

APPLICANT Ronnie Heaps RELATIONSHIP TO OWNER: Contractor

DAYTIME PHONE 443-277-7526 CELL EMAIL

MAILING ADDRESS 425 Obrecht Rd. Sykesville MD 21784


I HEREBY APPLY FOR THE NECESSARY TESTING/EVALUATION PRIOR TO ISSUANCE OF SEWAGE DISPOSAL SYSTEM PERMIT(S):

- PROPERTY: SUBDIVISION: NUMBER OF LOTS INCLUDING RESIDUE: SUBDIVISION CLASSIFICATION (PER DEPT. OF PLANNING AND ZONING) MAJOR MINOR
CONSTRUCT NEW OSDS ON UNDEVELOPED LOT
REPAIR OR REPLACE FAILING OSDS
UPGRADE EXISTING OSDS
BUILDING: RESIDENTIAL WITH 3 EXISTING OR PROPOSED BEDROOMS IN THE COMPLETED STRUCTURE
COMMERCIAL (PROVIDE DETAIL OF TYPE OF USE AND NUMBERS OF EMPLOYEES/CUSTOMERS ON ACCOMPANYING PLAN)
IS THE PROPERTY WITHIN 2500 FEET OF ANY RESERVOIR? YES NO

- AS APPLICANT, I UNDERSTAND THE FOLLOWING:
THIS APPLICATION IS VALID FOR TWO(2) YEARS FROM DATE OF FEE PAYMENT AND APPROVAL IS BASED UPON HEALTH OFFICER SIGNATURE OF A PERC CERTIFICATION PLAN PRIOR TO EXPIRATION OF THIS PERMIT.
THE APPLICATION FEE IS NON-REFUNDABLE
THIS APPLICATION MUST BE ACCOMPANIED BY ALL APPLICABLE FEES AND A SUITABLE SITE PLAN IN ORDER TO BE PROCESSED
THIS IS A PUBLIC DOCUMENT

I declare and affirm that to the best of my knowledge, the information contained herein is correct. I declare that I am the owner of the property or duly authorized to make this application on behalf of the owner. I agree to comply with all applicable state and county regulations.
By signature of this application, I hereby grant Howard County Health Department officials the right to enter onto the property for the purpose of inspecting the property as directly related to the requested permit/service.
Ronnie Heaps 8-15-16
SIGNATURE OF APPLICANT DATE

1" Ex Drilled Well
(HO-73-2340)

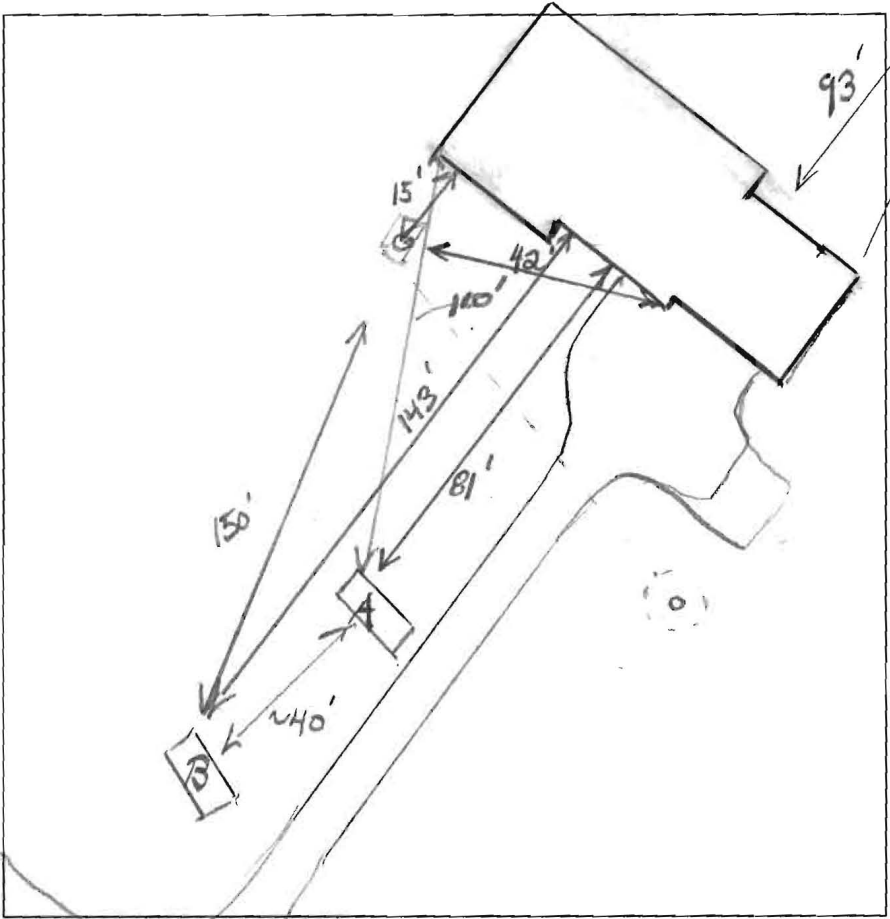

8" **(A)**
OM, WK20K roots
Br/Rd CL
CS, WP,
MSBK,
moist, roots

5'
8'
9'
10'
12'
Gr/Rd L.
CW, WK50K
Friable
Br/Y SL, m. sfl
mica, Friable
Pocket
Curtis Rd
20-25%
Br/Y/Rd SL
micaceous
10-15% Sap
15% Rx.
Hard Bottom

10'
4'
(B)
Br OM,
MSBK
Br CL,
WP, MSBK,
Friable,
roots
Br/Rd L,
Friable, WK50K
Friable, Dry
5% Sap.

7-8'
15'
Br/Y SL
WK Pl, Friable
Micaceous
CW, 10-15% Sap
10% Rx

DATE	TEST #	DEPTH	START	BREAK 1" DROP	STOP 2" DROP	TIME OF 2ND INCH	P/F/H
8/25/16	(A)	12'	00:45	00:53	01:05	12	P
	(B)	Visual OK					P
		H2O Pump @ bottom				~ 7mp	P

REMARKS wp= Plastic, can form wire / Deep Clay

SANITARIAN K. Wolf BACKHOE Ronnie OTHERS Kyle, owner
 TEST HOLES USED IN SDA 2 AVG. PERC TIME 12 SQ. FT/BR 0.8
 TRENCH WIDTH 3 INLET DEPTH 5' MAX. BOT DEPTH 8' EFFECTIVE S/W 7

$$\frac{4 \text{ BR} = 600 \text{ gal}}{0.8} = 750 \div 3 = 250 (.83) \approx 207.5 \text{ LF}$$