

4-12' Lodes

APPLICATION

A 19281

Preliminary

SEWAGE DISPOSAL TESTING

P _____

STATE OF MARYLAND - DEPARTMENT OF HEALTH AND MENTAL HYGIENE

HOWARD COUNTY HEALTH DEPARTMENT
ENVIRONMENTAL HEALTH SERVICES
P. O. BOX 476, ELLICOTT CITY, MARYLAND 21043
TELEPHONE: 465-8000, EXT. 356

4Br

DISTRICT 5

DATE 11/13/73

*Septic Tank 1200 gal
Dry Well - 450 sq ft absorbent sidewall area to begin below the ~~to~~ just
5' of original grade. Max depth permitted for dry well is 12' below orig. grade.
Place Dry Well 321' from rear lot line (point where lines meet) and
134' from right side line as seen when facing from the front.*

TO: THE COUNTY HEALTH OFFICER
ELLICOTT CITY, MARYLAND

I, HEREBY, APPLY FOR THE NECESSARY TEST IN ORDER TO CONSTRUCT (OR RECONSTRUCT) A SEWAGE DISPOSAL SYSTEM.

PROPERTY OWNER ~~Richard Hallowell (contract owner)~~ Thomas Goff

ADDRESS 7131 Mink Hollow Rd., Highland, Md. PHONE 286-2988

PROPERTY LOCATION:

SUBDIVISION Parcel 13 LOT NO. 13

ROAD AND DESCRIPTION #7085 - One E. side of Mink Hollow Rd approximately
400' N. of Gardner Lane

SIZE OF LOT #13 - - 5.544 acres TYPE BLDG. _____

NUMBER OF BEDROOMS _____

IF NOT SINGLE RESIDENCE DESCRIBE _____

THE SYSTEM INSTALLED UNDER THIS APPLICATION IS ACCEPTABLE ONLY UNTIL PUBLIC FACILITIES BECOME AVAILABLE

SIGNATURE OF APPLICANT Richard Hallowell

APPROVED BY [Signature] FOR Septic System DATE 1-21-74
(KIND OF SYSTEM)

REJECTED BY _____ FOR _____ DATE _____
(KIND OF SYSTEM)

HOLD PENDING FURTHER TESTS _____ DATE B.P.# 70505

REASONS FOR REJECTION OR HOLDING _____

THIS IS NOT A PERMIT

APPLICATION

A 19281

SEWAGE DISPOSAL TESTING

P _____

STATE OF MARYLAND - DEPARTMENT OF HEALTH AND MENTAL HYGIENE

HOWARD COUNTY HEALTH DEPARTMENT
ENVIRONMENTAL HEALTH SERVICES

DISTRICT 5

P. O. BOX 476, ELLICOTT CITY, MARYLAND 21043
TELEPHONE: 465-8000, EXT. 356

DATE 11/13/73

TO: THE COUNTY HEALTH OFFICER
ELLICOTT CITY, MARYLAND

I, HEREBY, APPLY FOR THE NECESSARY TEST IN ORDER TO CONSTRUCT (OR RECONSTRUCT) A SEWAGE DISPOSAL SYSTEM.

PROPERTY OWNER Richard Hallowell (contract owner)

ADDRESS 7131 Mink Hollow Rd., Highland, Md. PHONE 286-2988

PROPERTY LOCATION:

SUBDIVISION _____ LOT NO. Parcel 13

ROAD AND DESCRIPTION One E. side of Mink Hollow Rd approximately
400' N. of Gardner Lane

SIZE OF LOT #13 - - 5.544 acres TYPE BLDG. _____

NUMBER OF BEDROOMS _____

IF NOT SINGLE RESIDENCE DESCRIBE _____

THE SYSTEM INSTALLED UNDER THIS APPLICATION IS ACCEPTABLE ONLY UNTIL PUBLIC FACILITIES BECOME AVAILABLE

SIGNATURE OF APPLICANT Richard Hallowell

APPROVED BY _____ FOR _____ DATE _____
(KIND OF SYSTEM)


REJECTED BY _____ FOR _____ DATE _____
(KIND OF SYSTEM)

HOLD PENDING FURTHER TESTS _____ DATE _____

REASONS FOR REJECTION OR HOLDING _____

THIS IS NOT A PERMIT

Lot
13

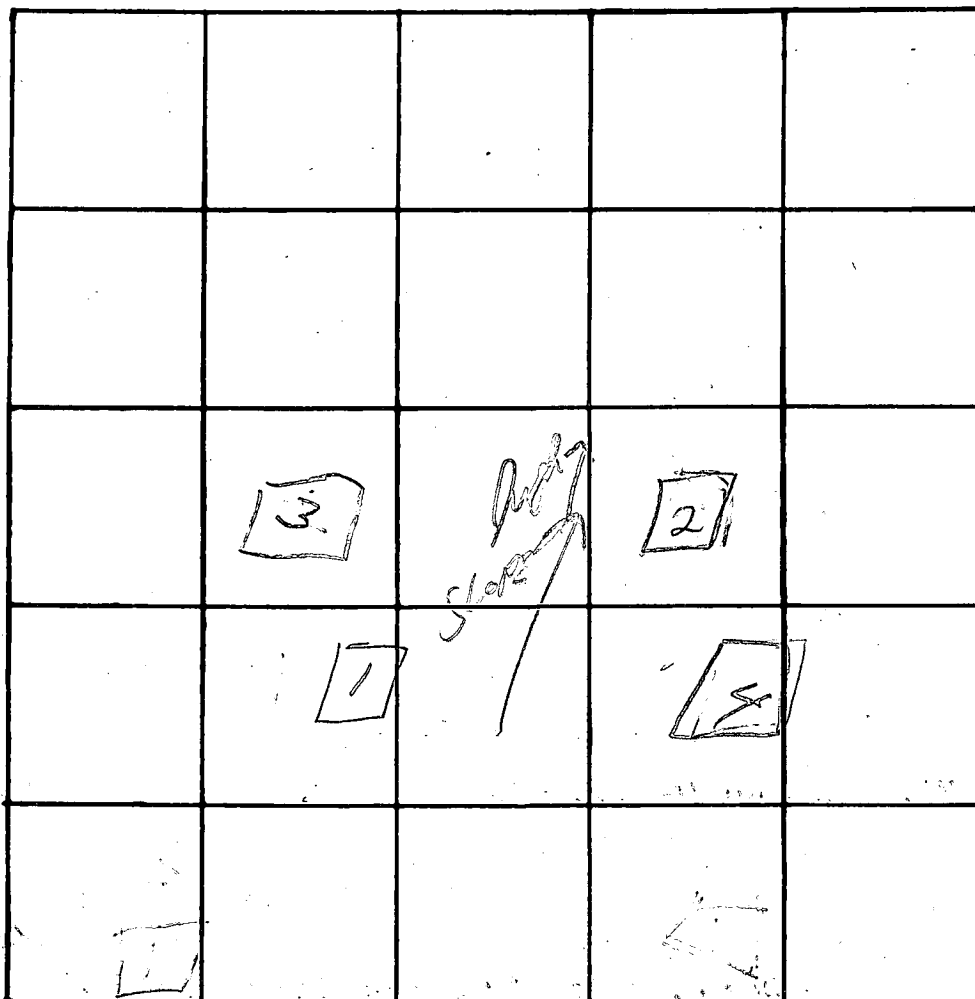

INDICATE NORTH. - NAME ADJOINING ROADWAY AS BASE LINE.

DATE	TEST NO.	DEPTH	PRE-WET		TEST - 1" DROP		TIME
			START	STOP	START	STOP	
11-22-23	1	11'	USUAL		OK		
	2	11'	USUAL		OK		
	3	12'	204	209	209	225	16AW
	3A	5 1/2'	204	210	210	213	3AW
	4	11'	215	221	221	225	4AW
	4A	5'	215	220	220	223	3AW

High

REMARKS

Century 21

TYPE OF SOIL