

MARYLAND DEPARTMENT OF THE ENVIRONMENT, WATER MANAGEMENT ADMINISTRATION
 1800 Washington Blvd., Baltimore, Maryland 21230 (410) 537-3784

 WATER WELL ABANDONMENT-SEALING REPORT FORM

SUBMIT COPIES OF COMPLETED FORM TO:

- * COUNTY ENVIRONMENT AGENCY (contact MDE, WMA if address needed)
- * WELL OWNER
- * MDE, WATER MANAGEMENT ADMINISTRATION, WELL PROGRAM

DATE WELL ABANDONED: 12/14/06 (month/day/year)

OK
 9/14/16 SC

* PERMIT NUMBER OF ABANDONED WELL (if any) _____

* PERMIT NUMBER OF REPLACEMENT WELL _____


* PERSON ABANDONING WELL: Richard A. Pruitt WELL DRILLERS LICENSE NUMBER: WRO 014

CIRCLE: MWD/MSD/MGD

* OWNER'S NAME: TRI COUNTY INDUSTRIES

SITE LOCATION MAP

* WELL LOCATION:
 COUNTY: Howard
 NEAREST TOWN: Simpsonville
 TAX MAP _____ BLOCK _____ PARCEL _____
 SUBDIVISION: _____
 SECTION: _____ LOT: _____
 NEAREST ROAD: 6700 FREETOWN RD

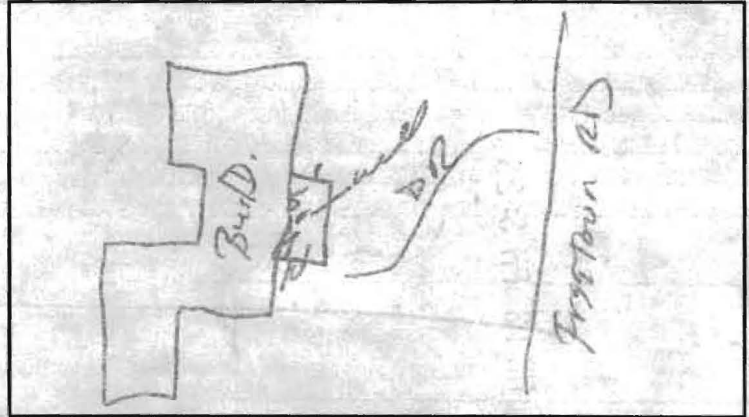

* TYPE OF WELL BEING ABANDONED:

- DRILLED _____ JETTED _____
- _____ BORED/AUGERED _____ HAND DUG _____
- _____ OTHER (specify) _____

* USE CODE:

- DOMESTIC _____ MUNICIPAL/PUBLIC _____
- _____ IRRIGATION _____ INDUSTRIAL _____
- _____ TEST/OBSERVATION _____ GEOTHERMAL _____

* TYPE OF CASING:

- STEEL _____ PLASTIC _____
- _____ CONCRETE _____ OTHER (specify) _____

* SIZE OF CASING: 6 INCHES IN DIAMETER

* DEPTH OF WELL: 159 FEET DEEP

* WAS ANY CASING REMOVED? _____ YES _____ NO
 if yes, length removed, in feet: _____

WAS CASING RIPPED OR PERFORATED? _____ YES _____ NO

LOG OF SEALING MATERIAL

MATERIAL	FEET	
	FROM	TO
Bertrantz well pit	159	9
	9	0
VOLUME OF MATERIAL USED		
11 BAGS Bertrantz		

George F. [Signature]
 NATURE-MASTER WELL DRILLER OR SUPERVISING SANITARIAN

040
 LICENSE #

MWD/MSD/MGD
 CIRCLE ONE

3/8/07
 DATE