

MARYLAND DEPARTMENT OF THE ENVIRONMENT, WATER MANAGEMENT ADMINISTRATION
 2500 BROENING HIGHWAY, BALTIMORE, MARYLAND 21224, (410) 631-3784

 WATER WELL ABANDONMENT-SEALING REPORT FORM

SUBMIT COPIES OF COMPLETED FORM TO:

- * COUNTY ENVIRONMENT AGENCY (contact MDE, WMA if address needed)
- * WELL OWNER
- * MDE, WATER MANAGEMENT ADMINISTRATION, WELL PROGRAM

DATE WELL ABANDONED: July 22 2005 (month/day/year)

* PERMIT NUMBER OF ABANDONED WELL (if any) WA - -

* PERMIT NUMBER OF REPLACEMENT WELL WA - -


* PERSON ABANDONING WELL: Ralph E. Mayne

WELL DRILLERS LICENSE NUMBER: 117

CIRCLE: MWD/MSD/MGD

* OWNER'S NAME: Taylor Services

* WELL LOCATION:
 COUNTY: Howard
 NEAREST TOWN: ELLICOTT CITY
 TAX MAP _____ BLOCK _____ PARCEL _____
 SUBDIVISION: WA
 SECTION: WA LOT: 124
 NEAREST ROAD: 3796 Mulligans Hill Lane

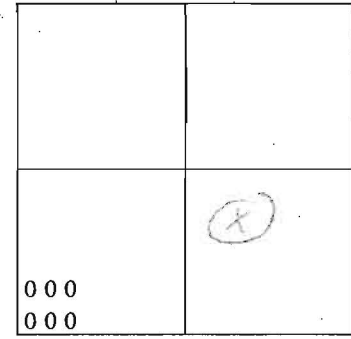

SHOW WELL LOCATION BY X WITHIN BOX

MARYLAND GRID COORDINATES
 E 520
 BOX NUMBER
 N 860

- * TYPE OF WELL BEING ABANDONED:
- _____ DRILLED
 - _____ BORED/AUGURED
 - _____ OTHER (specify) _____
 - _____ JETTED
 - HAND DUG

- * USE CODE:
- _____ DOMESTIC
 - _____ IRRIGATION
 - _____ TEST/OBSERVATION
 - _____ MUNICIPAL/PUBLIC
 - _____ INDUSTRIAL

- * TYPE OF CASING:
- STEEL
 - CONCRETE
 - _____ PLASTIC
 - _____ OTHER (specify) _____

* SIZE OF CASING: 36 INCHES IN DIAMETER

* DEPTH OF WELL: 15 FEET DEEP

* WAS ANY CASING REMOVED? YES NO
 if yes, length removed, in feet: _____

* WAS CASING RIPPED OR PERFORATED? YES NO

LOG OF SEALING MATERIAL

MATERIAL	FEET	
	FROM	TO
<u>Blue Stone</u>	<u>15</u>	<u>5</u>
<u>Concrete</u>	<u>5</u>	<u>0</u>

Ralph E. Mayne

117