

MARYLAND DEPARTMENT OF THE ENVIRONMENT, WATER MANAGEMENT ADMINISTRATION
 1800 Washington Blvd., Baltimore, Maryland 21230 (410) 537-3784

 WATER WELL ABANDONMENT-SEALING REPORT FORM

SUBMIT COPIES OF COMPLETED FORM TO:

- * COUNTY ENVIRONMENT AGENCY (contact MDE, WMA if address needed)
- * WELL OWNER
- * MDE, WATER MANAGEMENT ADMINISTRATION, WELL PROGRAM

12/6/2011

O.K. **BB**

DATE WELL ABANDONED: Aug 16, 11 (month/day/year)

* PERMIT NUMBER OF ABANDONED WELL (if any) None

* PERMIT NUMBER OF REPLACEMENT WELL Public water


* PERSON ABANDONING WELL: Harvey Knopp

WELL DRILLERS LICENSE NUMBER: 509

CIRCLE: MWD/MSD/MGD

* OWNER'S NAME: Gary Segal

SITE LOCATION MAP

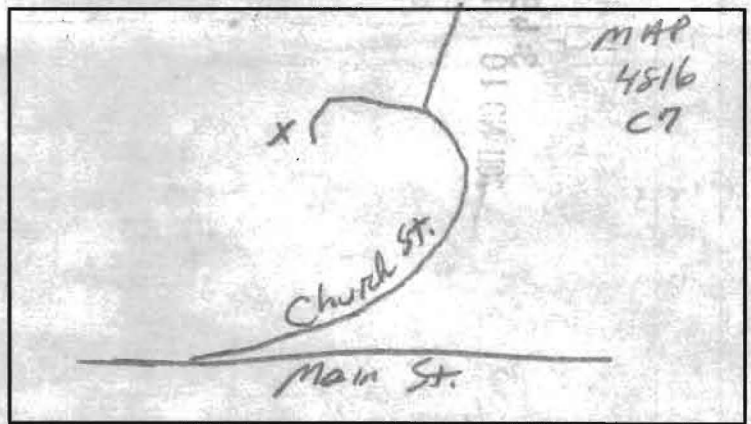

* WELL LOCATION:
 COUNTY: Howard
 NEAREST TOWN: Ellicott City
 TAX MAP 25 BLOCK 8 PARCEL 208
 SUBDIVISION: _____
 SECTION: _____ LOT: _____
 NEAREST ROAD: 3630 Church St.

* TYPE OF WELL BEING ABANDONED:

- DRILLED JETTED
- BORED/AUGERED HAND DUG
- OTHER (specify) _____

* USE CODE:

- DOMESTIC MUNICIPAL/PUBLIC
- IRRIGATION INDUSTRIAL
- TEST/OBSERVATION GEOTHERMAL

* TYPE OF CASING:

- STEEL PLASTIC
- CONCRETE OTHER (specify) _____

* SIZE OF CASING: 6 INCHES IN DIAMETER

* DEPTH OF WELL: 89 FEET DEEP

* WAS ANY CASING REMOVED? YES NO
 if yes, length removed, in feet: _____

* WAS CASING RIPPED OR PERFORATED? YES NO

LOG OF SEALING MATERIAL

MATERIAL	FEET	
	FROM	TO
well pit	0	6
bentonite hole plug	6	89
VOLUME OF MATERIAL USED		
16.6 cu. ft. bentonite		

SIGNATURE-MASTER WELL DRILLER OR SUPERVISING SANITARIAN David K. [Signature]

LICENSE # 304

CIRCLE ONE MWD/MSD/MGD

DATE 8/16/11