

MARYLAND DEPARTMENT OF THE ENVIRONMENT, WATER MANAGEMENT ADMINISTRATION
 1800 Washington Blvd., Baltimore, Maryland 21230 (410) 537-3784

 WATER WELL ABANDONMENT-SEALING REPORT FORM

SUBMIT COPIES OF COMPLETED FORM TO:

- * COUNTY ENVIRONMENT AGENCY (contact MDE, WMA if address needed)
- * WELL OWNER
- * MDE, WATER MANAGEMENT ADMINISTRATION, WELL PROGRAM

OK
 9/14/16 SC

DATE WELL ABANDONED: 8/20/10 (month/day/year)

* PERMIT NUMBER OF ABANDONED WELL (if any) _____

* PERMIT NUMBER OF REPLACEMENT WELL _____

* PERSON ABANDONING WELL: Allen Compton


WELL DRILLERS LICENSE NUMBER: 009

CIRCLE: MWD/MSD/MGD

* OWNER'S NAME: Community Baptist Church

SITE LOCATION MAP

* WELL LOCATION:
 COUNTY: Howard
 NEAREST TOWN: Jessup
 TAX MAP 43 BLOCK 8 PARCEL 376
 SUBDIVISION: _____
 SECTION: _____ LOT: F2
 NEAREST ROAD: 1326 Cedar Ave

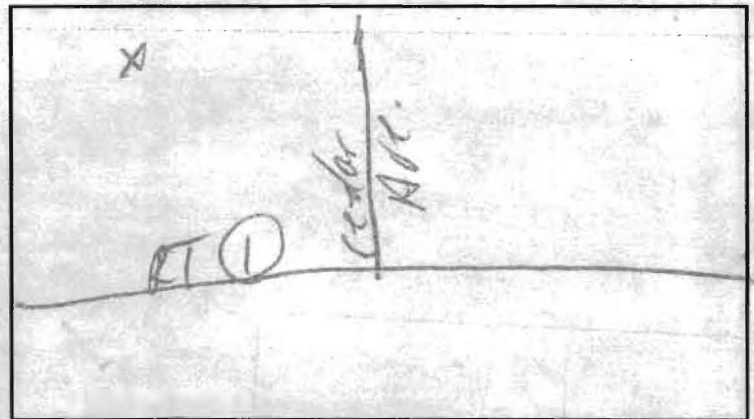

* TYPE OF WELL BEING ABANDONED:

_____ DRILLED _____ JETTED
 _____ BORED/AUGERED HAND DUG
 _____ OTHER (specify) _____

LOG OF SEALING MATERIAL

MATERIAL	FEET	
	FROM	TO
concrete	0	13
VOLUME OF MATERIAL USED		
6.5 yds		

* USE CODE:

DOMESTIC _____ MUNICIPAL/PUBLIC
 _____ IRRIGATION _____ INDUSTRIAL
 _____ TEST/OBSERVATION _____ GEOTHERMAL

* TYPE OF CASING:

STEEL _____ PLASTIC
 _____ CONCRETE _____ OTHER (specify) _____

* SIZE OF CASING: 4 INCHES IN DIAMETER

* DEPTH OF WELL: 13' FEET DEEP

* WAS ANY CASING REMOVED? _____ YES _____ NO
 if yes, length removed, in feet: _____

* WAS CASING RIPPED OR PERFORATED? _____ YES _____ NO

SIGNATURE-MASTER WELL DRILLER OR SUPERVISING SANITARIAN _____

LICENSE # 009

CIRCLE ONE MWD/MSD/MGD

DATE 8-26-10