
 WATER WELL ABANDONMENT-SEALING REPORT FORM

OK
 9/14/16SC

SUBMIT COPIES OF COMPLETED FORM TO:

- * COUNTY ENVIRONMENT AGENCY (contact MDE, WMA if address needed)
- * WELL OWNER
- * MDE, WATER MANAGEMENT ADMINISTRATION, WELL PROGRAM

DATE WELL ABANDONED: 5/12/2011 (month/day/year)

* PERMIT NUMBER OF ABANDONED WELL (if any) _____


* PERMIT NUMBER OF REPLACEMENT WELL _____

* PERSON ABANDONING WELL: Richard Crummitt WELL DRILLERS LICENSE NUMBER: WPD0014

CIRCLE: MWD/MSD/MGD

* OWNER'S NAME: TOM SULLIVAN

SITE LOCATION MAP

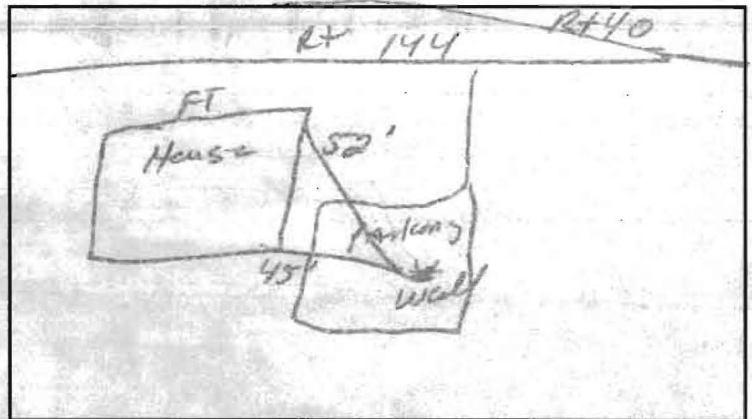

* WELL LOCATION:
 COUNTY: HOWARD
 NEAREST TOWN: ELLICOTT CITY
 TAX MAP _____ BLOCK _____ PARCEL _____
 SUBDIVISION: _____
 SECTION: _____ LOT: _____
 NEAREST ROAD: 10443 Frederick Rd

* TYPE OF WELL BEING ABANDONED: 10-11
 DRILLED _____ JETTED
 _____ BORED/AUGERED _____ HAND DUG
 _____ OTHER (specify) _____

LOG OF SEALING MATERIAL

MATERIAL	FEET	
	FROM	TO
Bentonite	2/2	0
VOLUME OF MATERIAL USED		
7 Bags Bentonite		

* USE CODE:
 DOMESTIC _____ MUNICIPAL/PUBLIC
 _____ IRRIGATION _____ INDUSTRIAL
 _____ TEST/OBSERVATION _____ GEOTHERMAL

* TYPE OF CASING:
 STEEL _____ PLASTIC
 _____ CONCRETE _____ OTHER (specify) _____

* SIZE OF CASING: 6 INCHES IN DIAMETER

* DEPTH OF WELL: 42 FEET DEEP

* WAS ANY CASING REMOVED? _____ YES NO
 if yes, length removed, in feet: _____

* WAS CASING RIPPED OR PERFORATED? _____ YES NO

SIGNATURE - MASTER WELL DRILLER OR SUPERVISING SANITARIAN: George F. Entenber LICENSE # 040 CIRCLE ONE
 MWD/MSD/MGD DATE: 5-17-11