

-1970-

MARYLAND DEPARTMENT OF THE ENVIRONMENT, WATER MANAGEMENT ADMINISTRATION  
2500 BROENING HIGHWAY, BALTIMORE, MARYLAND 21224, (410) 631-3784

\*\*\*\*\*  
WATER WELL ABANDONMENT-SEALING REPORT FORM  
\*\*\*\*\*

SUBMIT COPIES OF COMPLETED FORM TO:

- \* COUNTY ENVIRONMENT AGENCY (contact MDE, WMA if address needed)
- \* WELL OWNER
- \* MDE, WATER MANAGEMENT ADMINISTRATION, WELL PROGRAM

DATE WELL ABANDONED: 12/15/08 (month/day/year)

OK  
9/15/16 sec

\* PERMIT NUMBER OF ABANDONED WELL (if any) \_\_\_\_\_

\* PERMIT NUMBER OF REPLACEMENT WELL \_\_\_\_\_


\* PERSON ABANDONING WELL: Robert P Copesey

WELL DRILLERS LICENSE NUMBER: 1161

CIRCLE: MWD/MSD/MGD

\* OWNER'S NAME: Edward J Roberts

\* WELL LOCATION: 7946 Keelmont Dr  
 COUNTY: Howard County  
 NEAREST TOWN: Lanham  
 TAX MAP 46 BLOCK 6 PARCEL 2266  
 SUBDIVISION: Hammond Village  
 SECTION: \_\_\_\_\_ LOT: 2  
 NEAREST ROAD: Nicky Ct

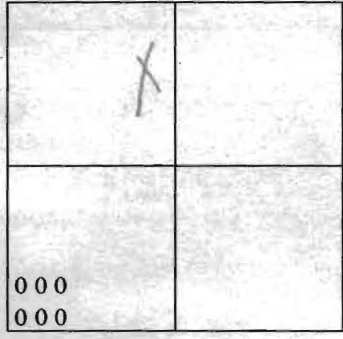

SHOW WELL LOCATION BY X WITHIN BOX

MARYLAND GRID COORDINATES

BOX NUMBER  
E 830  
N 470

\* TYPE OF WELL BEING ABANDONED:

- DRILLED
- BORED/AUGURED
- OTHER (specify) \_\_\_\_\_
- JETTED
- HAND DUG

\* USE CODE:

- DOMESTIC
- IRRIGATION
- TEST/OBSERVATION
- MUNICIPAL/PUBLIC
- INDUSTRIAL

\* TYPE OF CASING:

- STEEL
- CONCRETE
- PLASTIC
- OTHER (specify) \_\_\_\_\_

\* SIZE OF CASING: 1 1/2" INCHES IN DIAMETER

\* DEPTH OF WELL: 97 FEET DEEP

\* WAS ANY CASING REMOVED?  YES \_\_\_\_\_ NO  
if yes, length removed, in feet: 5

\* WAS CASING RIPPED OR PERFORATED?  YES \_\_\_\_\_ NO

LOG OF SEALING MATERIAL

MATERIAL	FEET	
	FROM	TO
Bentonite clay	97	5
clean fill	3	0

SIGNATURE-MASTER WELL DRILLER OR SUPERVISING SANITARIAN

LICENSE #

1161  
MWD/MSD/MGD

12/15/08  
DATE

