
 WATER WELL ABANDONMENT-SEALING REPORT FORM

SUBMIT COPIES OF COMPLETED FORM TO:

- * COUNTY ENVIRONMENT AGENCY (contact MDE, WMA if address needed)
- * WELL OWNER
- * MDE, WATER MANAGEMENT ADMINISTRATION, WELL PROGRAM

OK
 9/15/16 SC

DATE WELL ABANDONED: 6/27/05 (month/day/year)

* PERMIT NUMBER OF ABANDONED WELL (if any) _____

HO - 88 - 1625

* PERMIT NUMBER OF REPLACEMENT WELL _____

* PERSON ABANDONING WELL: Michael Isom


WELL DRILLERS LICENSE NUMBER: 162

CIRCLE: MWD/MSD/MGD

* OWNER'S NAME: Julius Group

SITE LOCATION MAP

* WELL LOCATION:
 COUNTY: Howard
 NEAREST TOWN: ELLIOTT CITY
 TAX MAP _____ BLOCK _____ PARCEL _____
 SUBDIVISION: _____
 SECTION: _____ LOT: _____
 NEAREST ROAD: 1277 Old Frederick Rd
1625

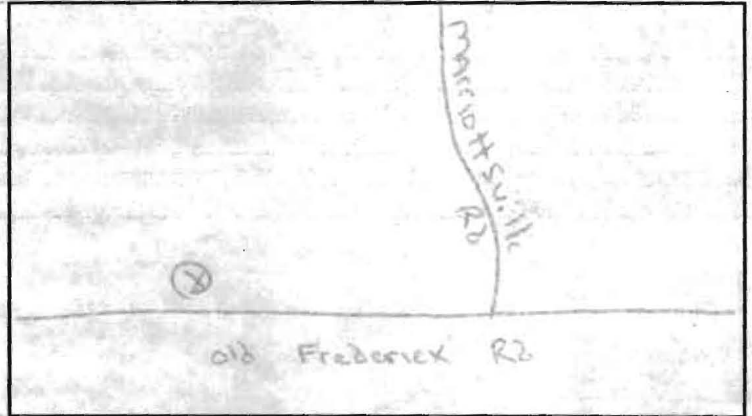

* TYPE OF WELL BEING ABANDONED:

- DRILLED JETTED
- BORED/AUGERED HAND DUG
- OTHER (specify) _____

LOG OF SEALING MATERIAL

MATERIAL	FEET	
	FROM	TO
Portland Cement	160	0
VOLUME OF MATERIAL USED		

* USE CODE:

- DOMESTIC MUNICIPAL/PUBLIC
- IRRIGATION INDUSTRIAL
- TEST/OBSERVATION GEOTHERMAL

* TYPE OF CASING:

- STEEL PLASTIC
- CONCRETE OTHER (specify) _____

* SIZE OF CASING: 6 INCHES IN DIAMETER

* DEPTH OF WELL: 160 FEET DEEP

* WAS ANY CASING REMOVED? YES NO
 if yes, length removed, in feet: _____

* WAS CASING RIPPED OR PERFORATED? YES NO

SIGNATURE-MASTER WELL DRILLER OR SUPERVISING SANITARIAN _____

LICENSE # 162

MWD/MSD/MGD

CIRCLE ONE

DATE 6/28/05